


WEST SANDUSKY AVENUE
S.R. No. 47



INDEXED ON MAP
6399 IP

Daniel E. Gilbert
 DANIEL E. GILBERT, P.S.,
 REG. SUR. No. 5402
 400 N. PARK ST.
 BELLEFONTAINE, OHIO
 43311

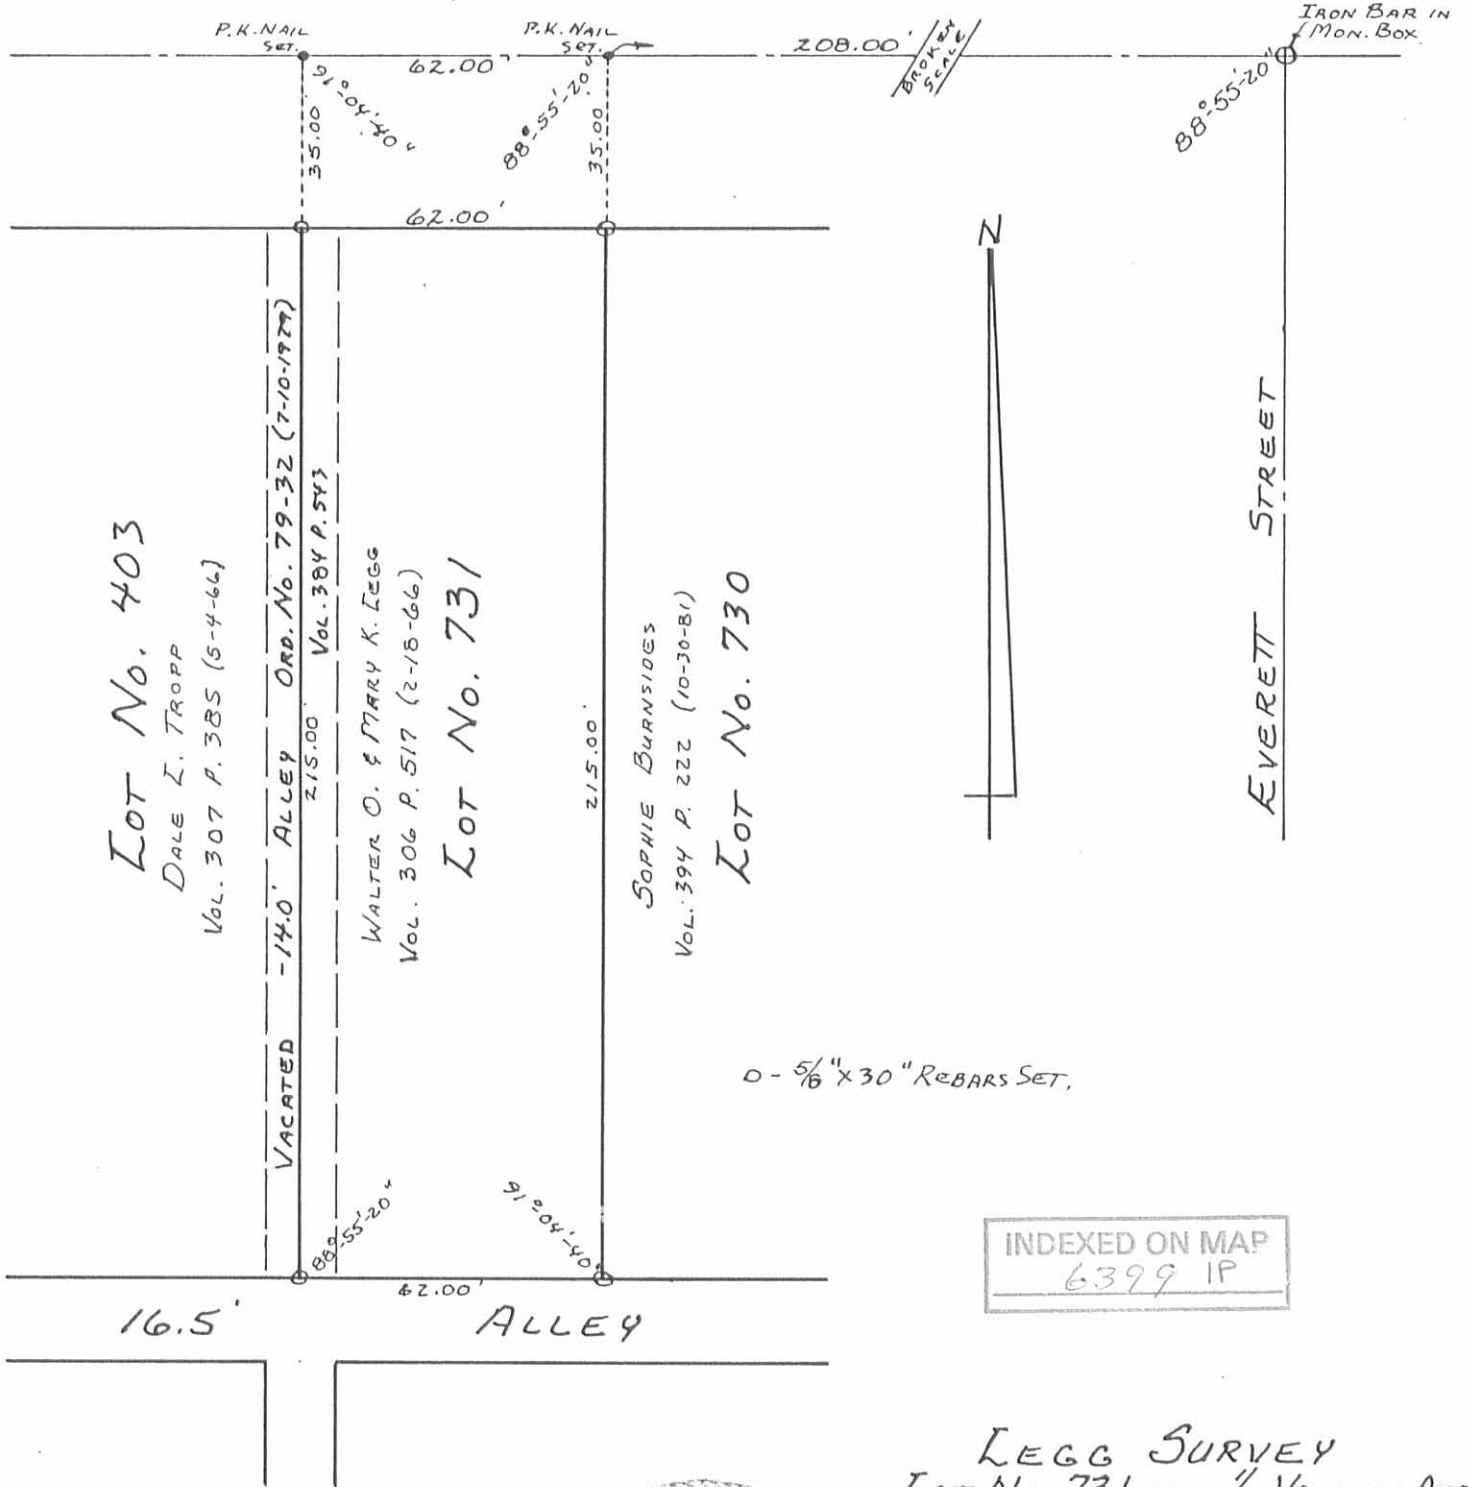


LEGG SURVEY
 LOT No. 731 AND 1/2 VACATED ALLEY
 CITY OF BELLEFONTAINE
 LAKE TOWNSHIP
 LOGAN COUNTY, OHIO
 OCTOBER 8, 1986
 SCALE: 1" = 40'

086-025

RAMBO'S ADDITION


RAMBO'S ADD.
N56°W

Surveyed by M. H. McCormick 3-71

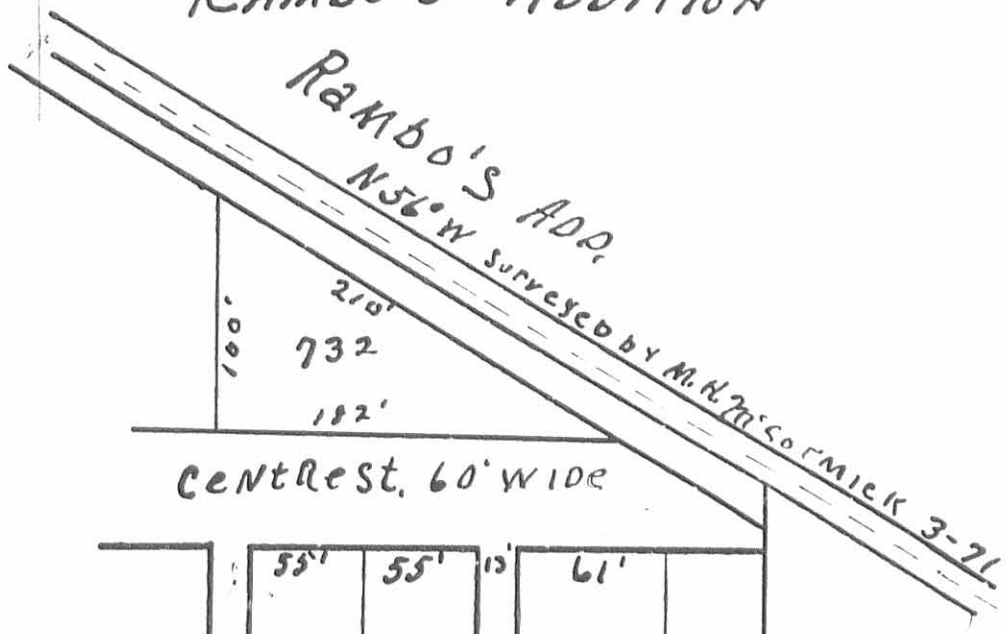

Centrest. 60' wide

RAMBO'S ADDITION

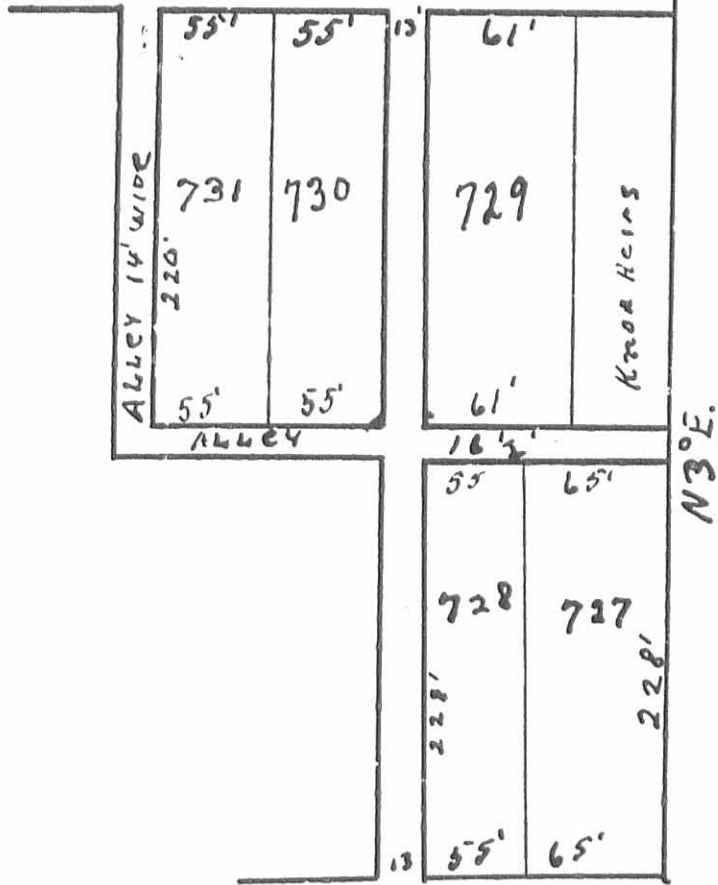

ALLEY 14' wide

ALLEY

Know Heirs

N3°E

COLUMBUS AVE. OR SIDNEY ROAD

6399 2P

INDEXED ON MAP