


PART LOT 3960
BELLEFONTAINE, OHIO
November 8, 1969

The following described real estate situated in the City of Bellefontaine, Lake Township, Logan County, Ohio and being part of Lot 3960 of Lake Heights Allotment No. 2 as shown on Logan County Recorders Plat Book D, Volume 4, Page 30 and more particularly described as follows:

Beginning at an iron bar in the west line of Forester Avenue at the southeast corner of lot 3960; thence with the south line of said lot N.76° 26'W. 135.3 feet to an iron bar at the southwest corner of said lot; thence with the west line of said lot N.0° 12'W. 52.0 feet to an iron pipe at the southwest corner of lot 3961; thence with the south line of said lot 3961, N.52° 52'E. 106.0 feet to an iron bar; thence S.49° 49'E. 94.0 feet to an iron bar in the west line of said Forester Avenue; thence with said west line S.44° 35'W. 40.0 feet to an iron pipe; thence continuing with said west line S.0° 17'E. 54.1 feet to the place of beginning.

INDEXED ON MAP
6474 1D

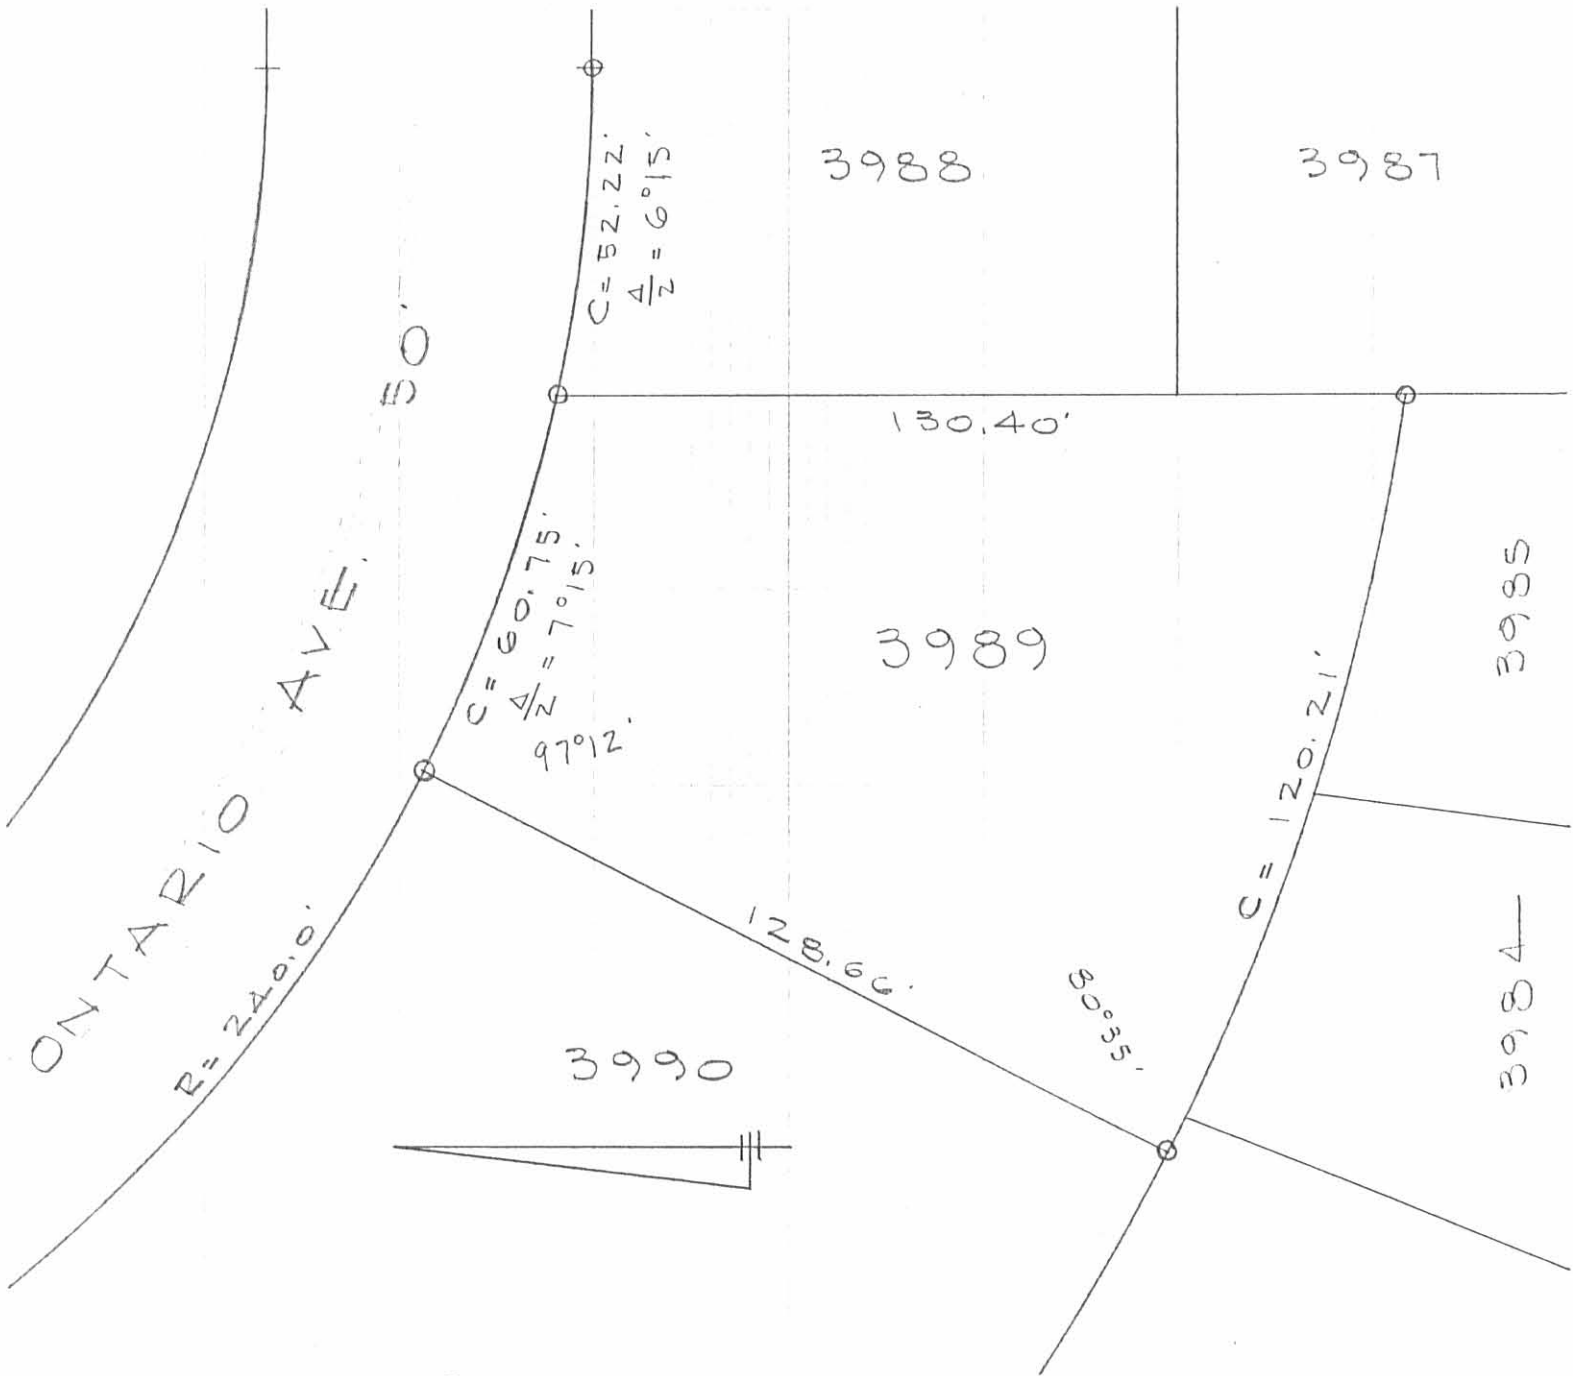

SURVEY OF
LOT 3989

BELLEFONTAINE, OHIO

JULY 14, 1973

SCALE 1" = 30'

○ = 3/4" PIPE FOUND

DAN L. DODSON
REG. SURVEYOR 4270
BELLEFONTAINE, O

INDEXED ON MAP
6474 1P