

C. W. Eby Bk 187
 New Gas House Lot Survey
 See page 100. Nov. 19-1917.

(1) Start at iron pin cent Plum Valley S. & Chilli Ave
 Thence east on cent Chilli Ave.

at 656.70 Iron pin cent Powell St. App. R.
 " 761.60 cent main track. Sand. Div. of R. & Ry.

Wit. Iron pin cent Powell St. & Chilli Ave.
 Waide materials S. 13.10; N. 1/2 stone. feds 2 S.F.
 6 of 5.42.2'; Maple 24" S.W. 37'


(2) Start at iron pin cent Powell St. & Chilli Ave
 Thence S. on cent Powell St
 at 184.8 point at 90° m. of iron pin on E side
 of Powell St at N.W. City property

(3) Start at cent. Sand. Div. R. & Ry = a.
 Thence west at 193. Iron pin at a = N.W. corner lot

Survey continued March 8th 1918

W. H. Kellogg Asset Real Estate Agt. R. & Ry. Co.
 Delineter, Transit man " "
 was present and assisted in survey and location
 of the east line of Powell (Gas House) Lot
 See page 100 - In note survey.

New Gas House Lot, Nov 19-1917 ⁹⁹
 67.17
 112.45 See Book 198 Page 15
 " " A-1 " 132

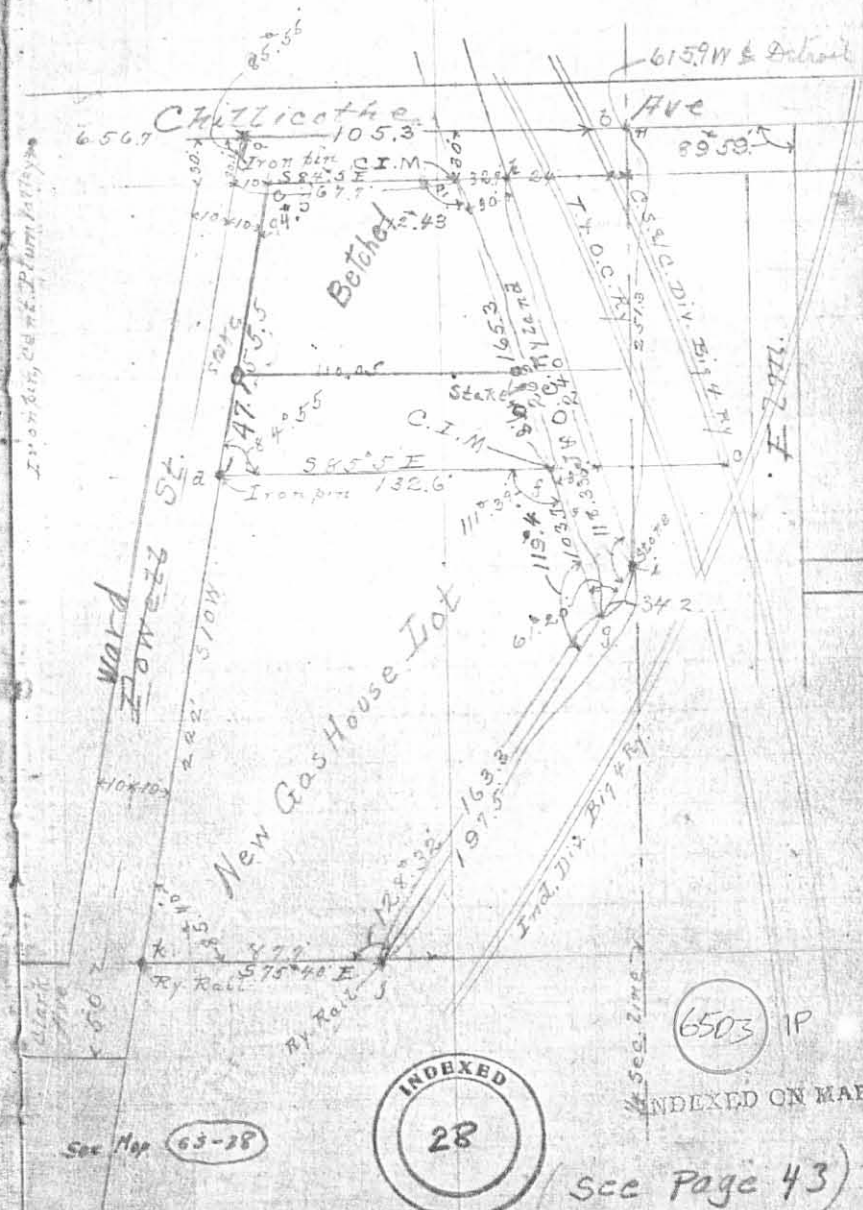

CITY EXP. BK. 184
 Cross Section Powell Lot, S. of Chilli. Ave.

May 8th 1917. Fine bright warm day.

- For new gas plant			46.34		
B.M. Hyd. Clark & Powell	3.39		42.95		
Top Ry. Dim at SW ² Powell Lot = 1	5.90		40.44		
Top side walk W. side Powell N. side Clark = 0	5.43		40.91		
-1 at 20'	6.10	40.24	π	46.34	
" " " I 5'	7.00	39.34	Sp. rail switch d	1.00	45.34
" " " R 5'	5.60	40.74	3-3 at 0	4.80	41.54
" " " 40'	6.60	39.74	Sp. m. stone = E	2.05	44.29
" " " I 5'	7.30	39.04	" " " = "	3.61	47.90
" " " R 15'	5.10	41.24	3-3 at 20'	6.70	41.20
" " " 30'	6.00	40.34	" " " 40'	9.70	40.20
" " " I 5'	7.20	39.14	" " " 60'	7.90	40.00
" " " R 15'	4.60	41.74	" " " 80'	7.30	40.60
" " " 80'	4.60	41.44	" " " 100'	6.60	41.30
" " " I 5'	6.30	40.04	" " " 120'	6.00	41.90
" " " R 15'	3.30	43.04	" " " 134'	2.90	45.00
" " " 84 Ry. Dim	3.45	42.89	" " " 165 Ry. Dim	1.70	46.20
Sp. rail switch 2'	1.71	44.57			51.19
" " Main Line c	-1.70	48.04	Sp. m. stone c	6.91	44.28
2-2 at 0	5.80	41.04	B.M. Hyd. Clark & Powell	7.24	42.95
" " " 20'	7.10	39.24	3-3 at 198 Ry. Dim	2.49	43.40
" " " 40'	7.30	39.04	3-3 " 225' " "	2.59	48.60
" " " 60'	6.90	39.44	4-4 at 0	9.09	42.10
" " " 80'	6.40	39.94	" " " 20'	9.79	41.40
" " " 100'	4.80	41.54	" " " 40'	10.39	40.80
" " " 110 W. side Beer House 3 ft			" " " 60'	10.20	40.90

cross section Powell Lot S. of Chilli. Ave. 43

W. Chillicothe Ave

