


- LEGEND:**
- = POWER POLE
 - ⊙ = PIPE FOUND
 - = 3/8" IRON BAR SET
 - = 1" IRON BAR FOUND

BENCH MARK
 R.R. SPIKE IN EAST SIDE
 OF POWER POLE @ PATTERSON
 AND 12.5' ALLEY.
 ASSUMED ELEV. 100.00

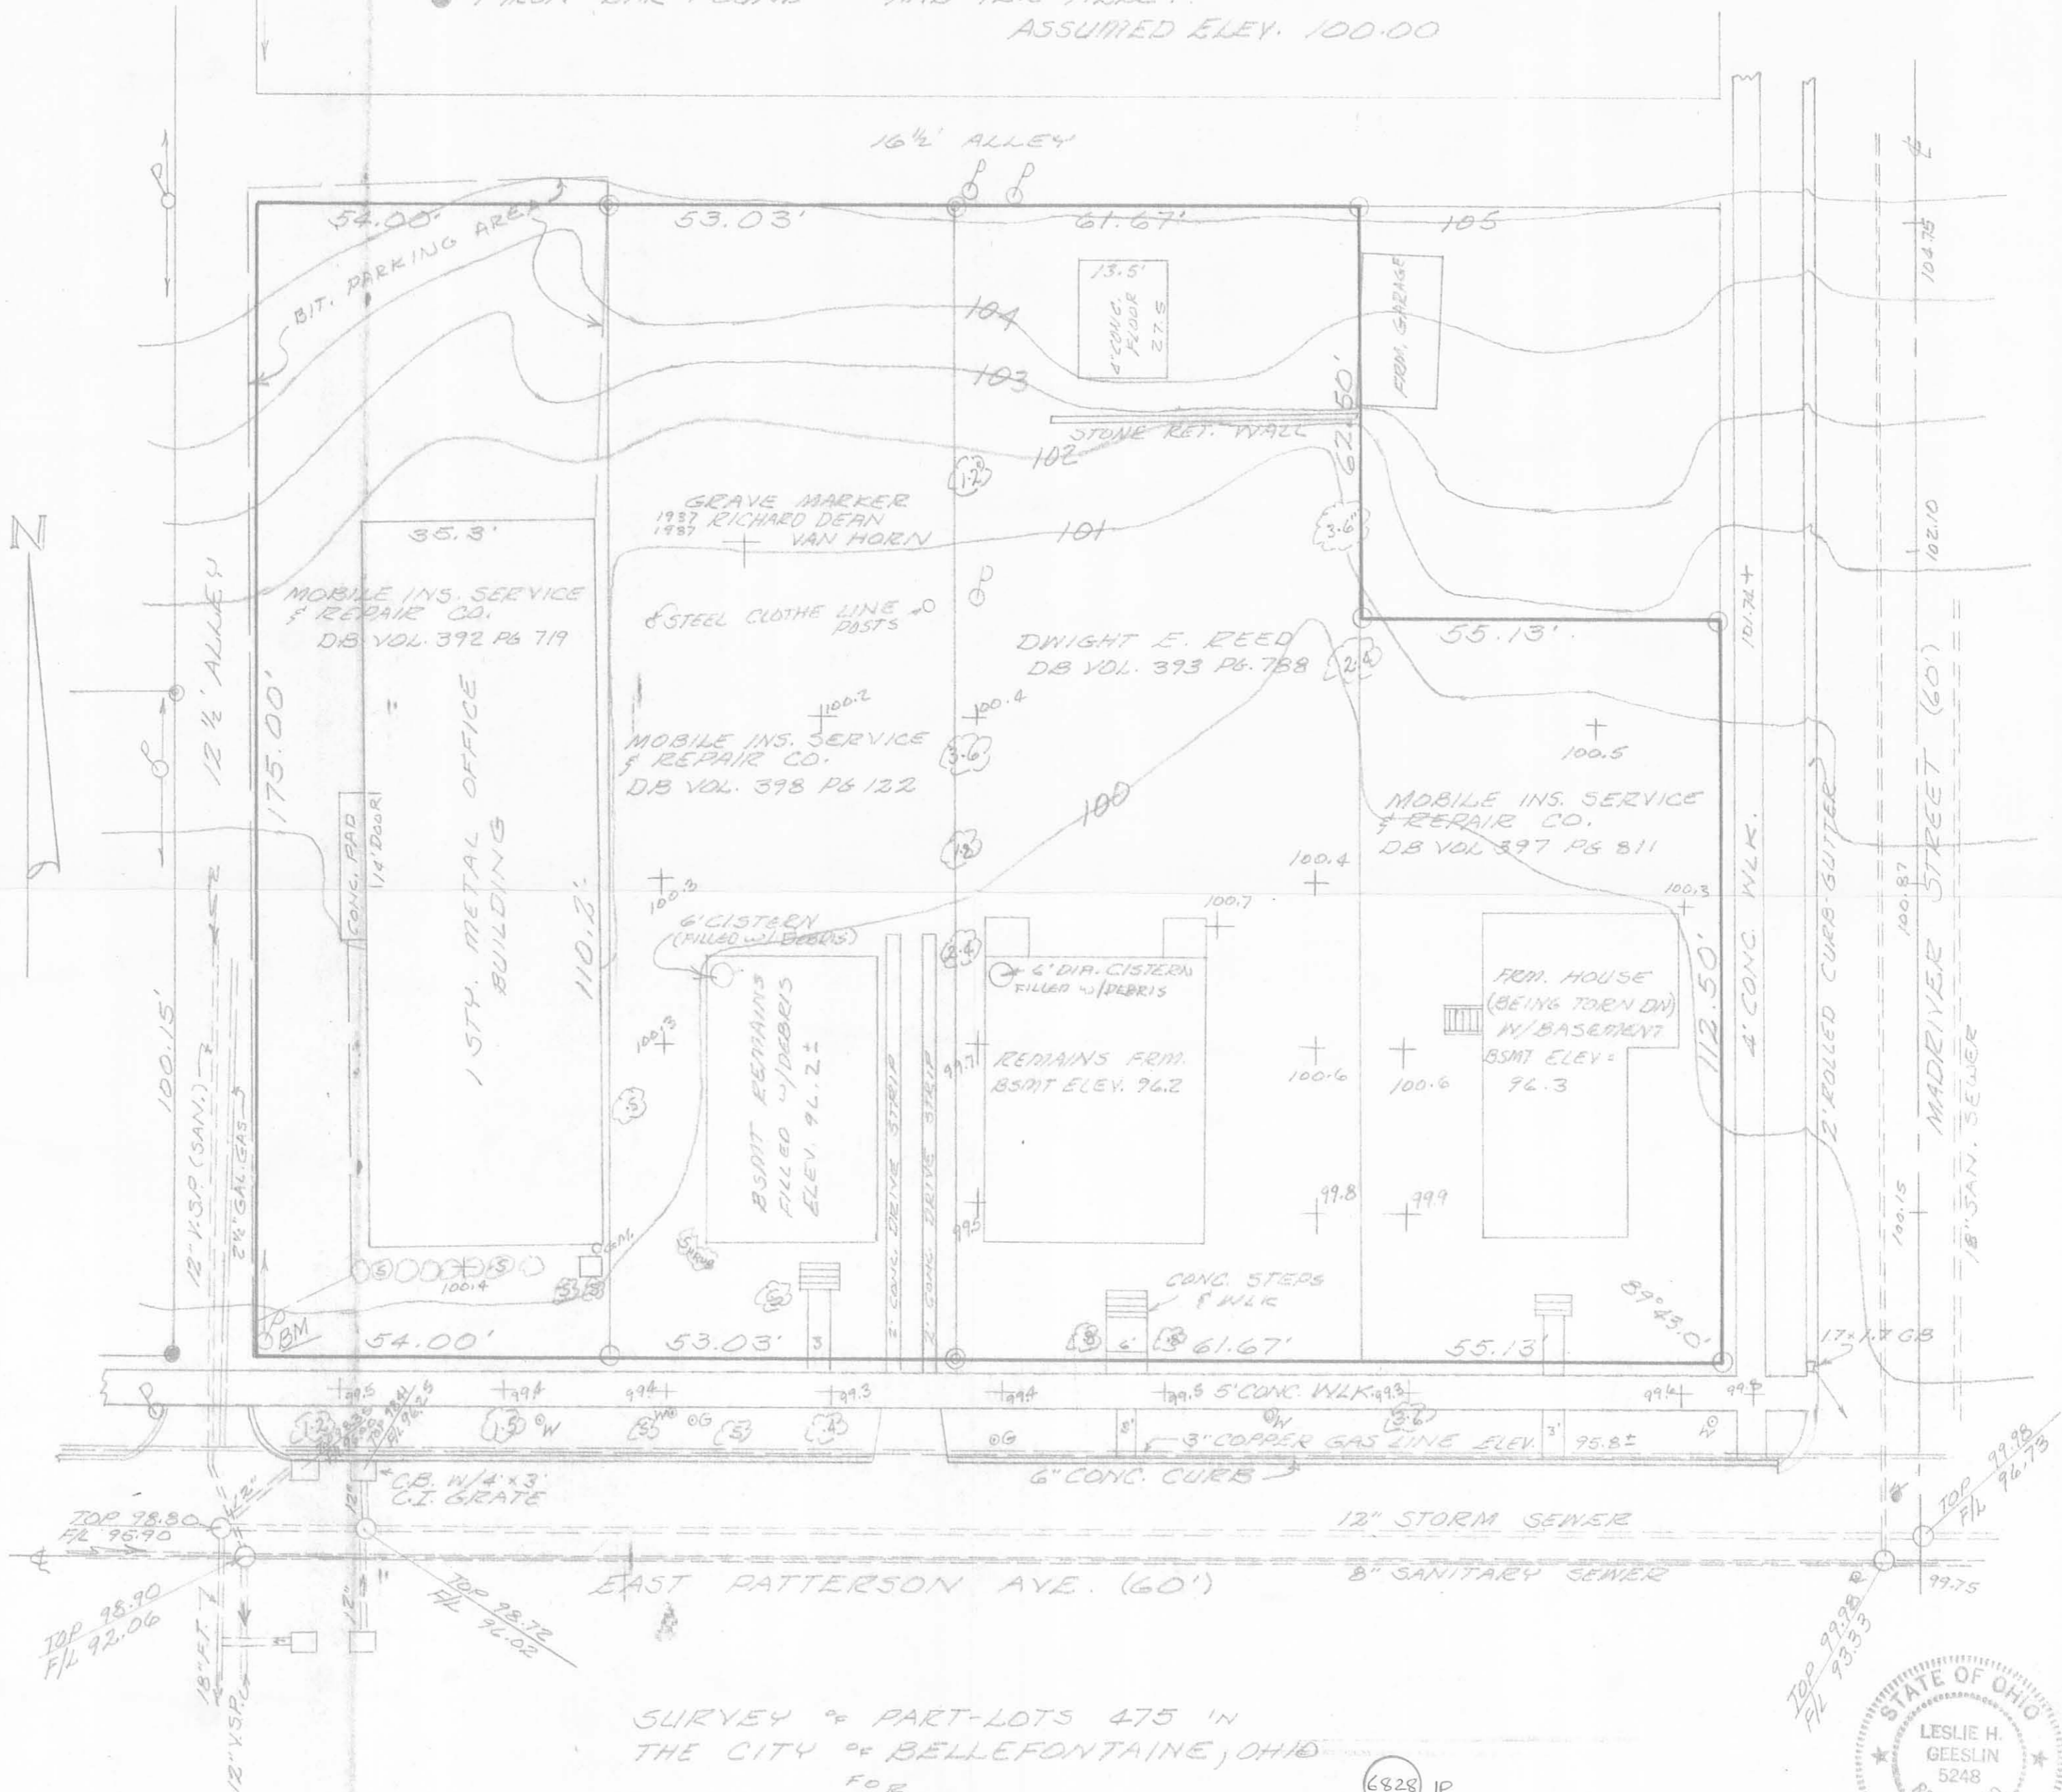

SURVEY OF PART-LOTS 475 IN
 THE CITY OF BELLEFONTAINE, OHIO
 FOR
 DEPUY-REED ASSOC.
 APRIL, 1983
 SCALE: 1" = 20'

(6828) 1P

INDEXED ON MAP



Leslie H. Geeslin
 LESLIE H. GEESLIN
 RUSHSVLVANIA, OHIO