

BM - Chiseled
Cross - Elev.
84.10


16 1/2 Public Alley

10" V.S.P @ 0.35%

8" V.S.P @ 0.10%

COLUMBUS ST. 80'


COURT ST. 16 1/2'

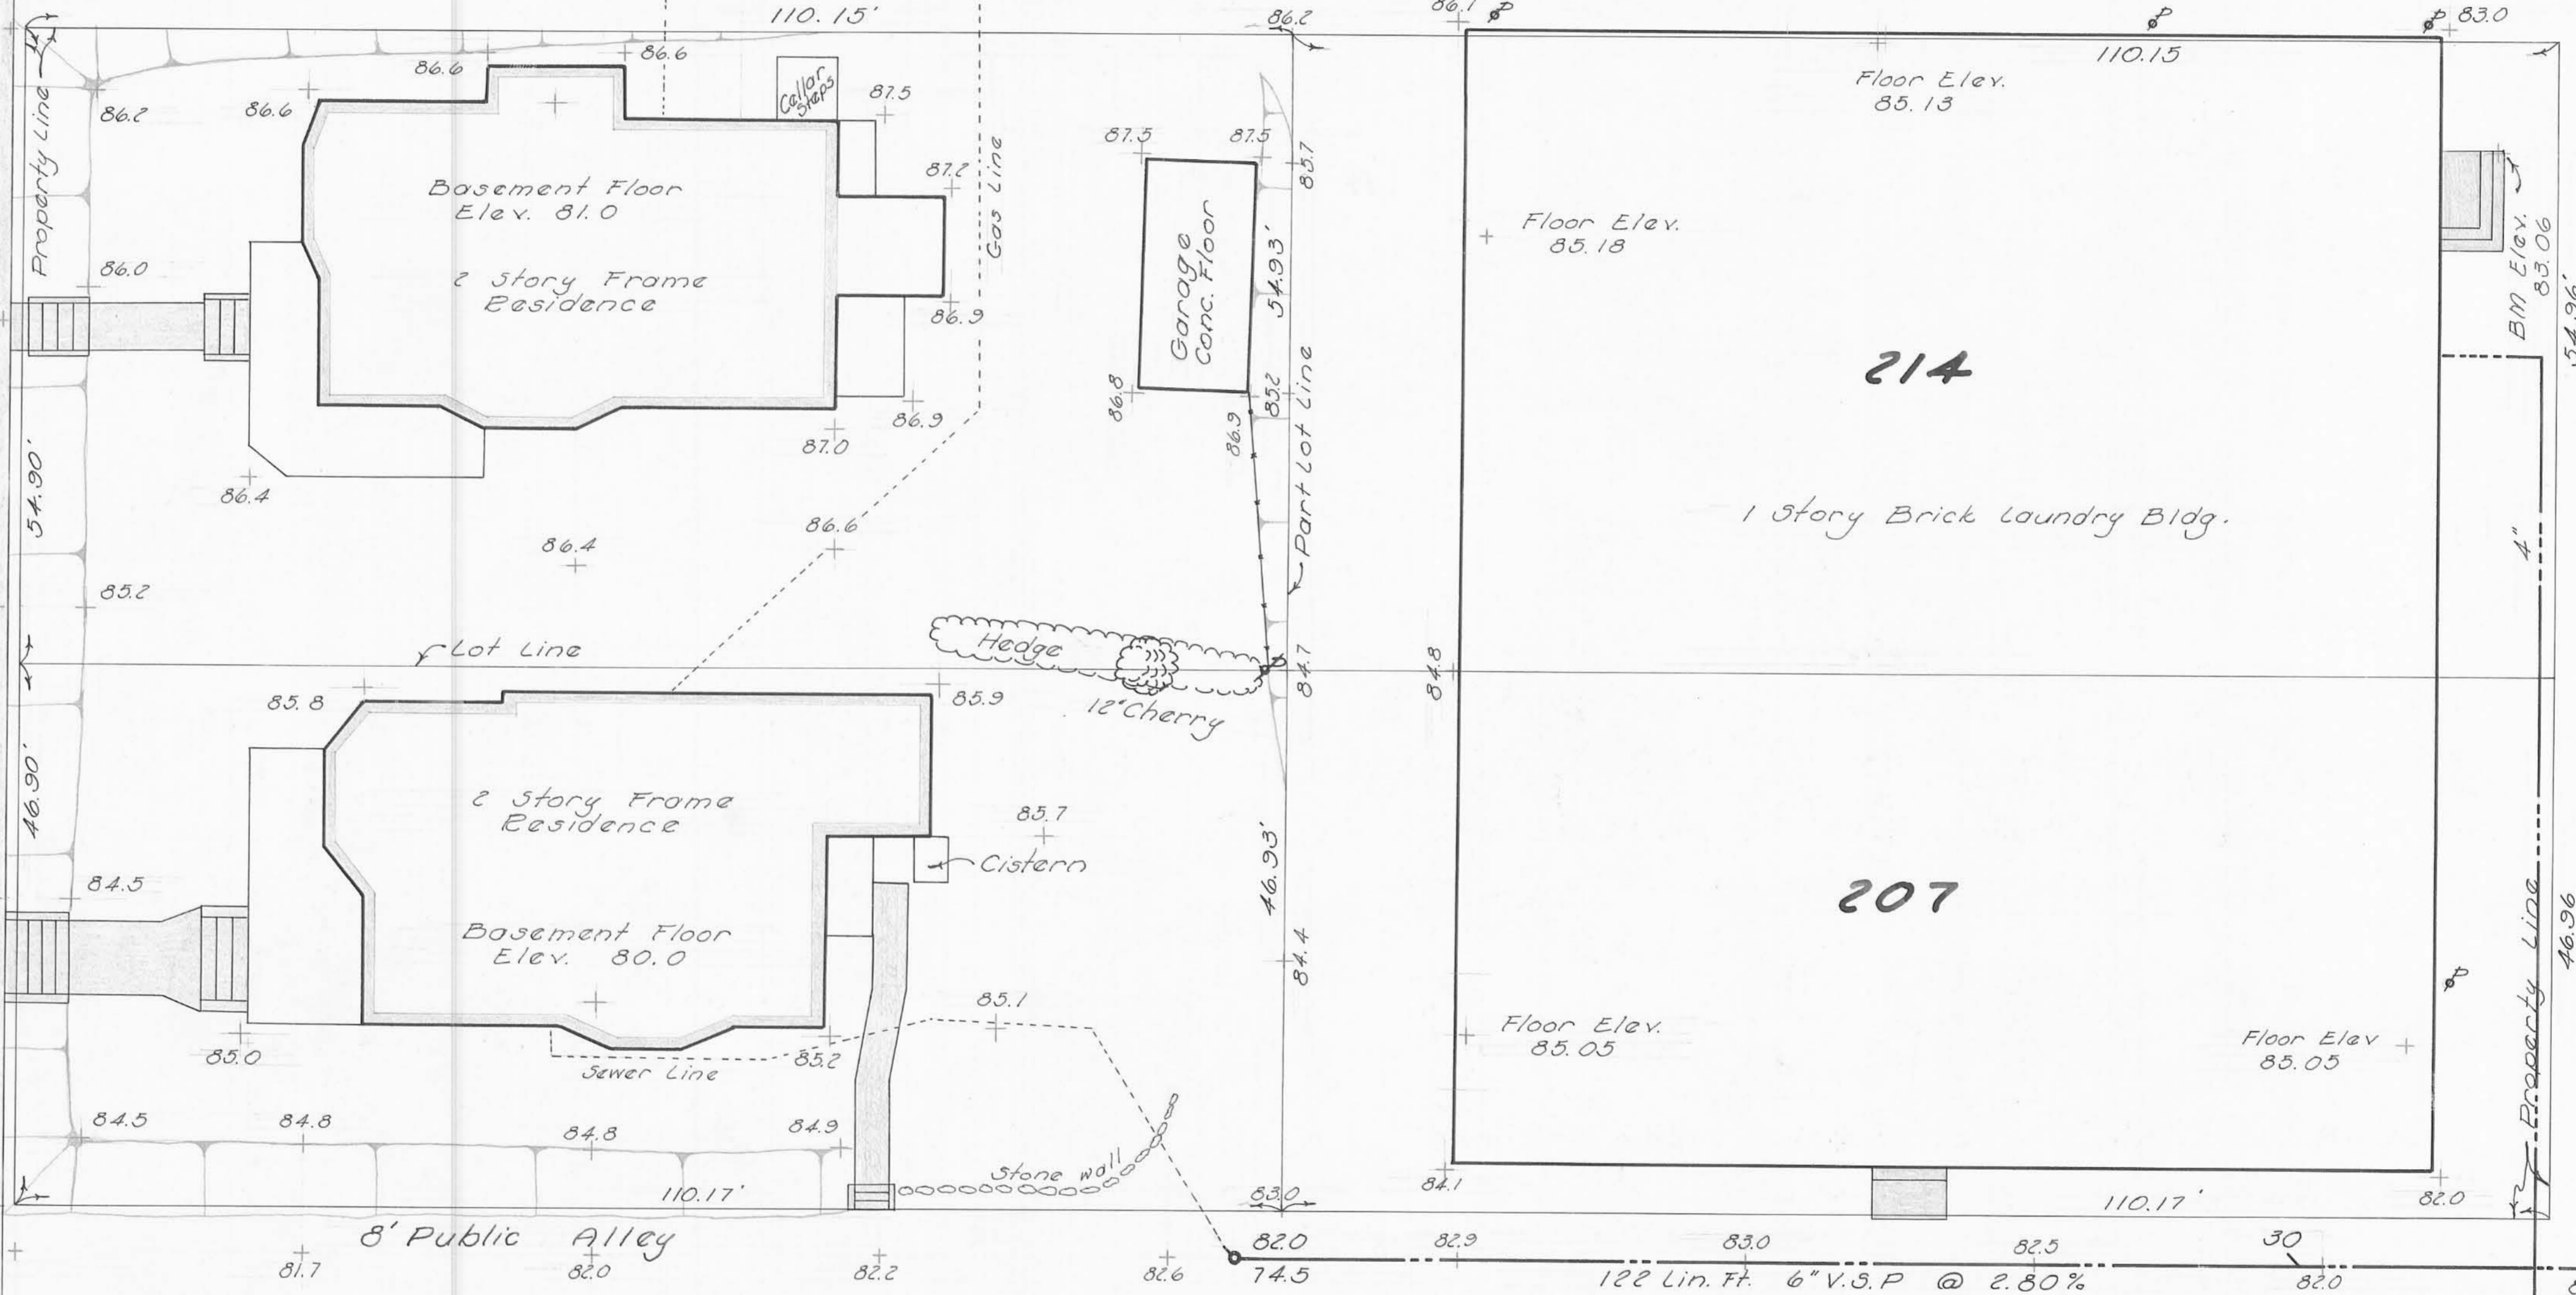

- LEGEND**
- Sanitary Sewer, stub indicates existing tap, number indicates dist. in feet from Manhole.
 - 6" High Pressure Gas Line
 - 3" Normal Pressure Gas Line
 - Water Line, number indicates diameter.
 - Chain Link Fence
 - Utility Pole
 - Sanitary Sewer Manhole, numbers indicate street and flowline elevation.

TOPOGRAPHIC SURVEY
LOT No. 207 & 214
BELLEFONTAINE, OHIO
 NOVEMBER, 1960
SCALE 1" = 10'

Surveyed by Dan L. Dodson
 November, 1960
 Registered Surveyor #4270

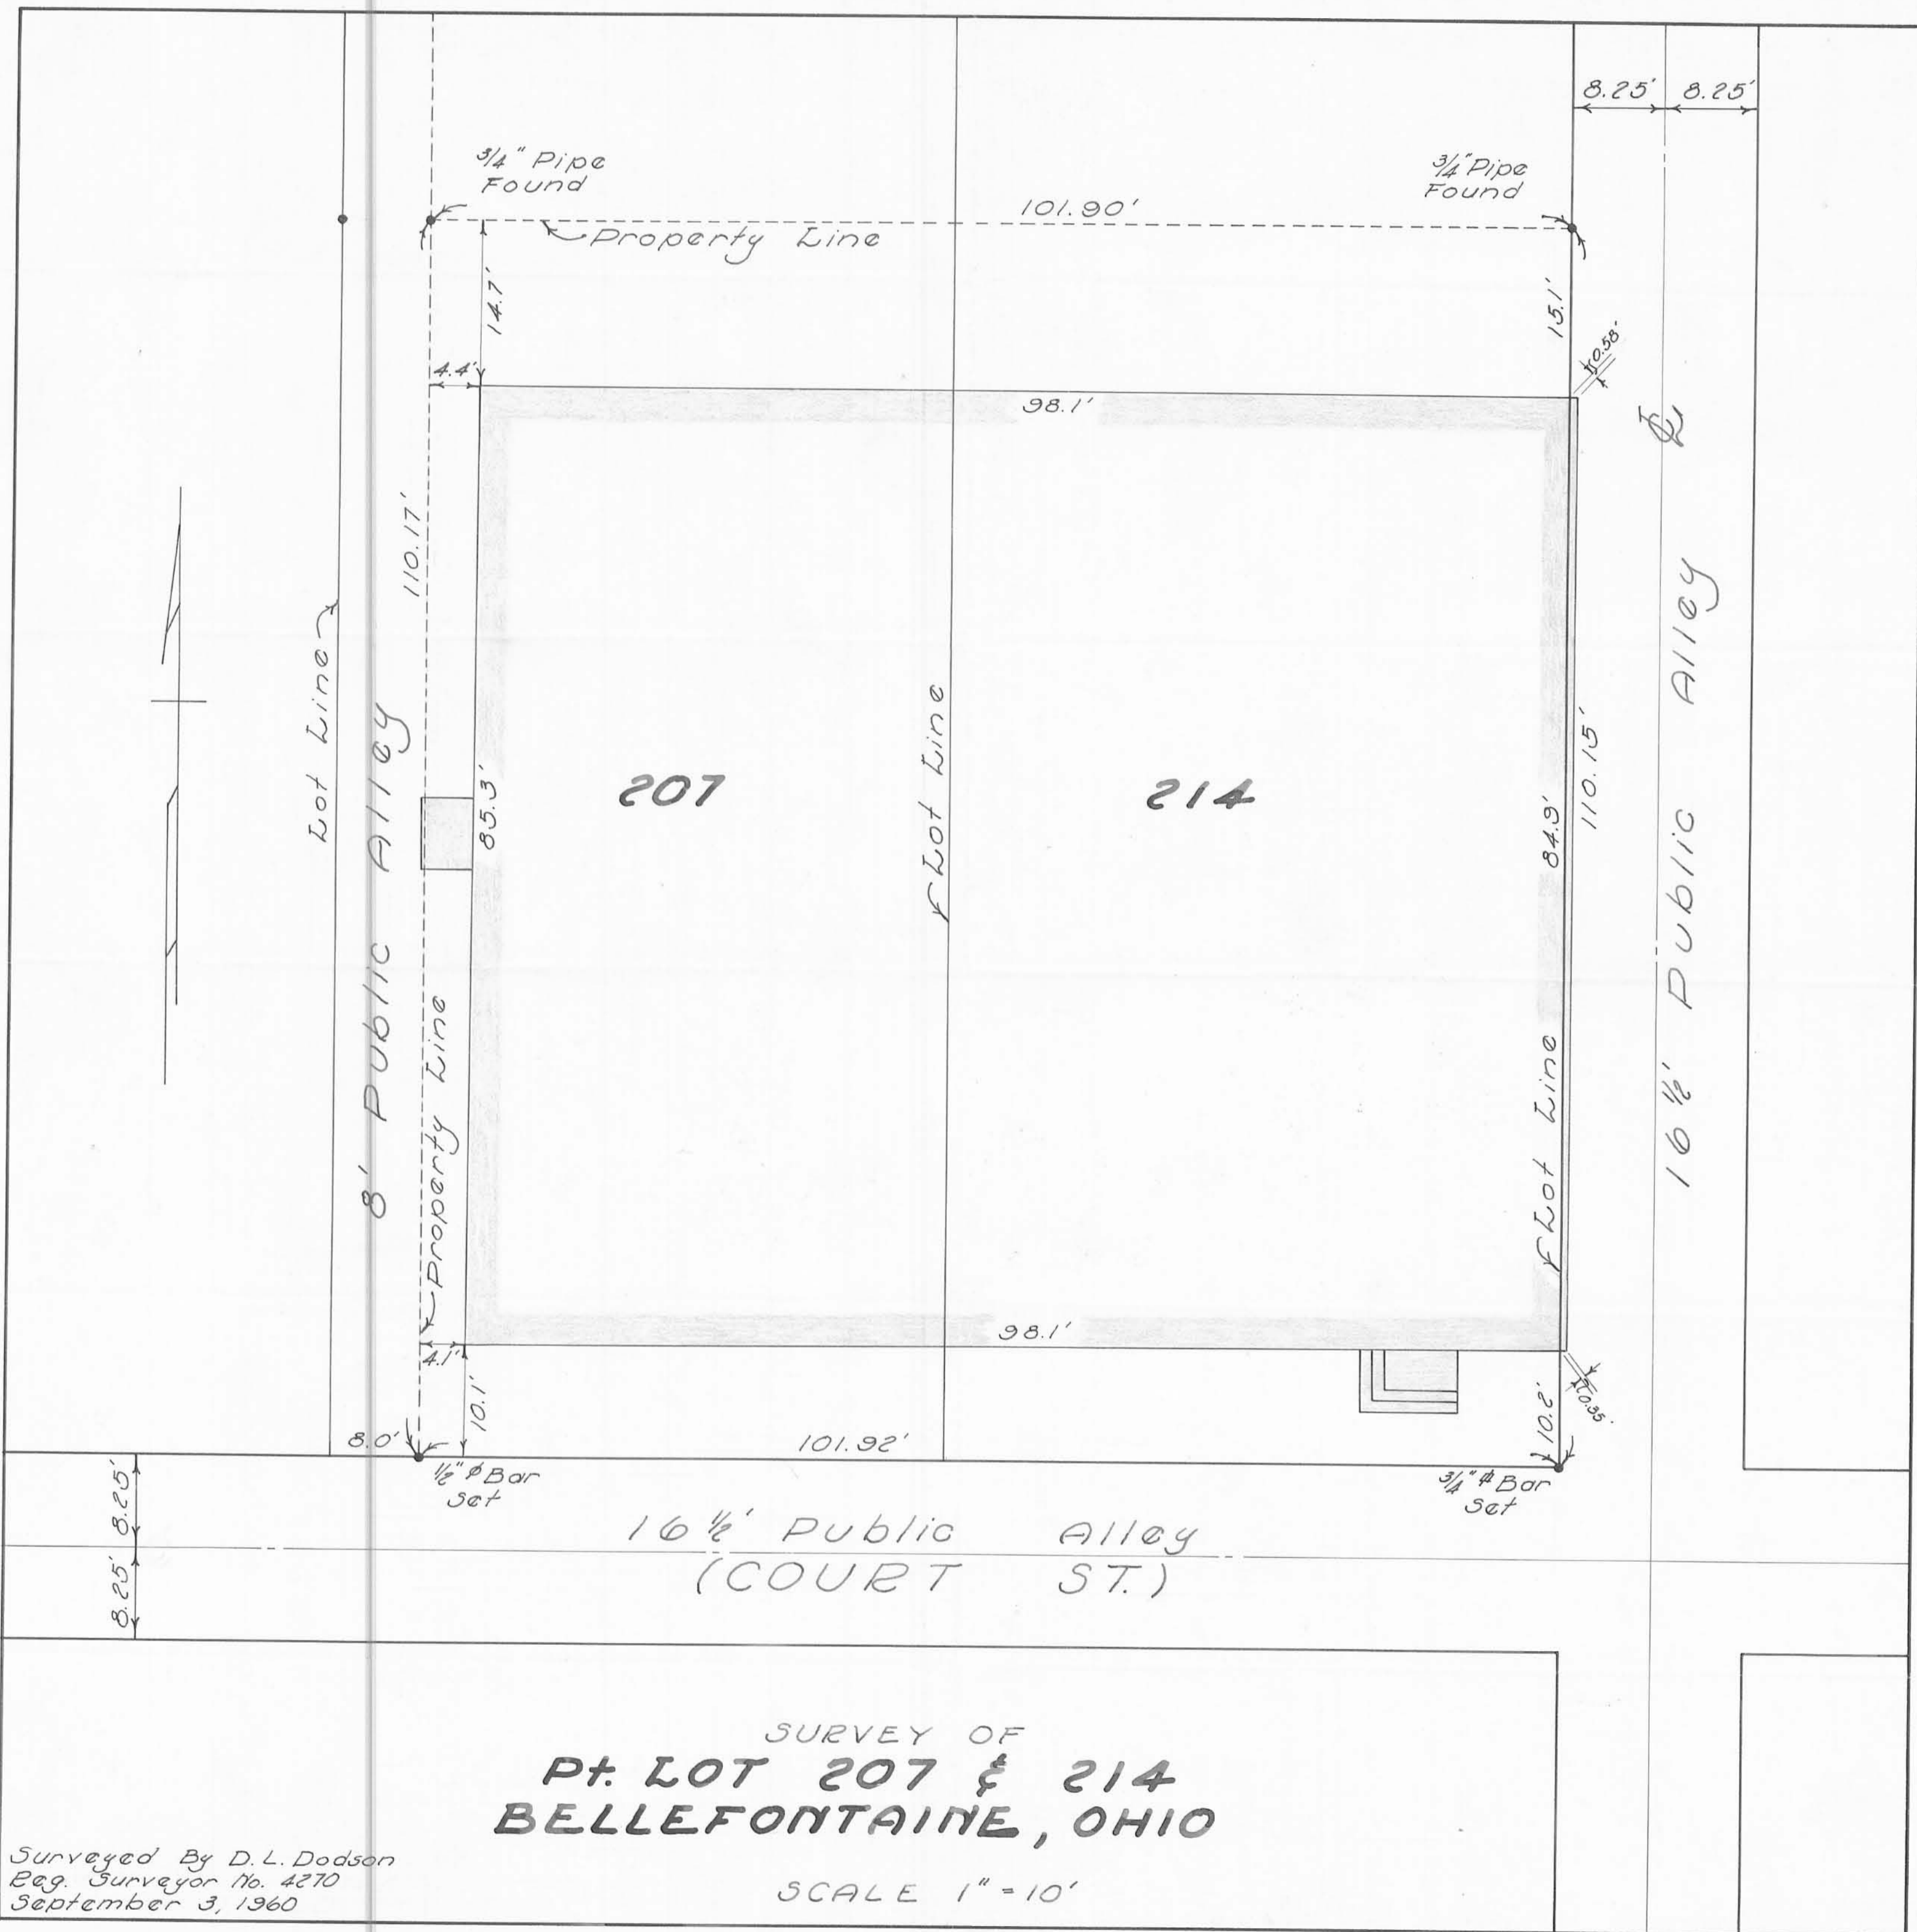


LOT 207-214
BELLEFONTAINE

8' R/W to City for alley
Vol. 237/518 May 14, 1956


Nov. 1960

14

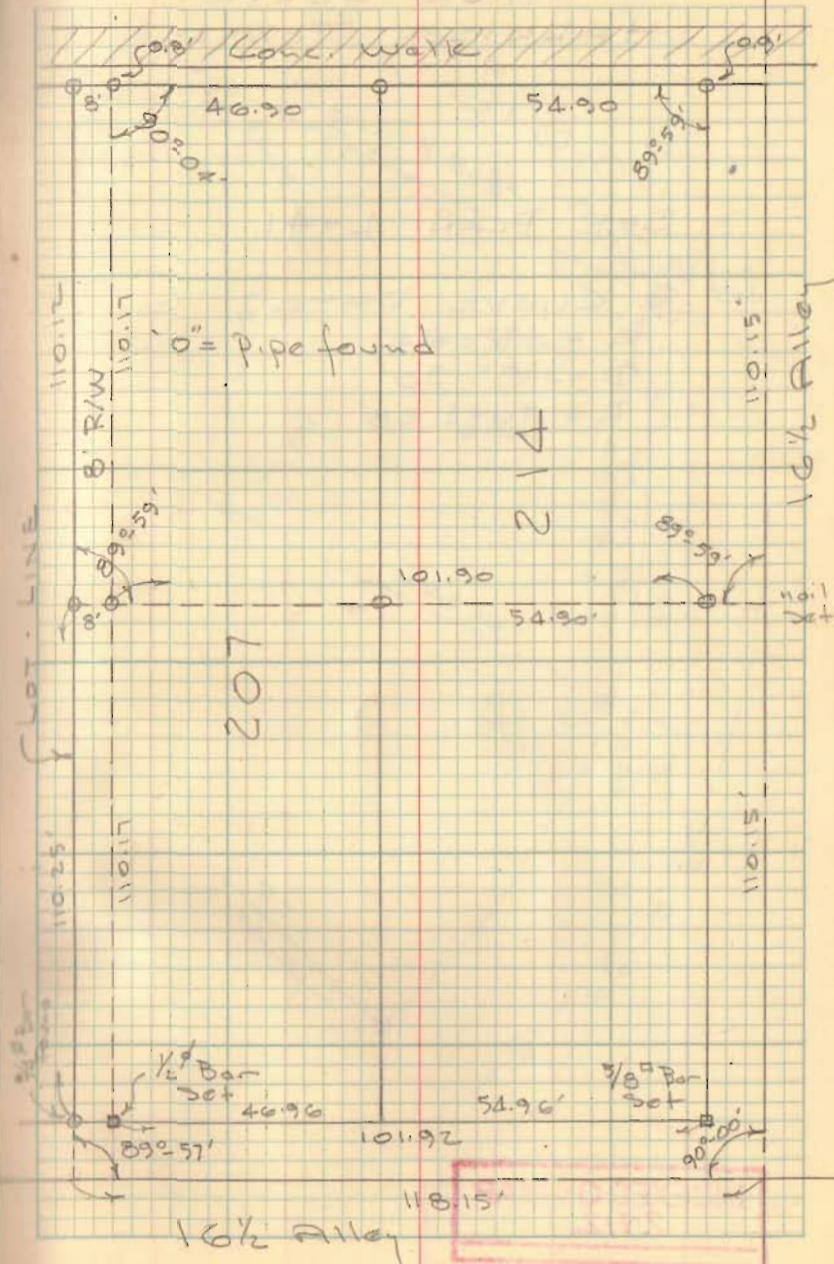

INDEXED ON MAP
7004


Lot 207-214
 Bellefontaine
 (Laundry Bldg.)

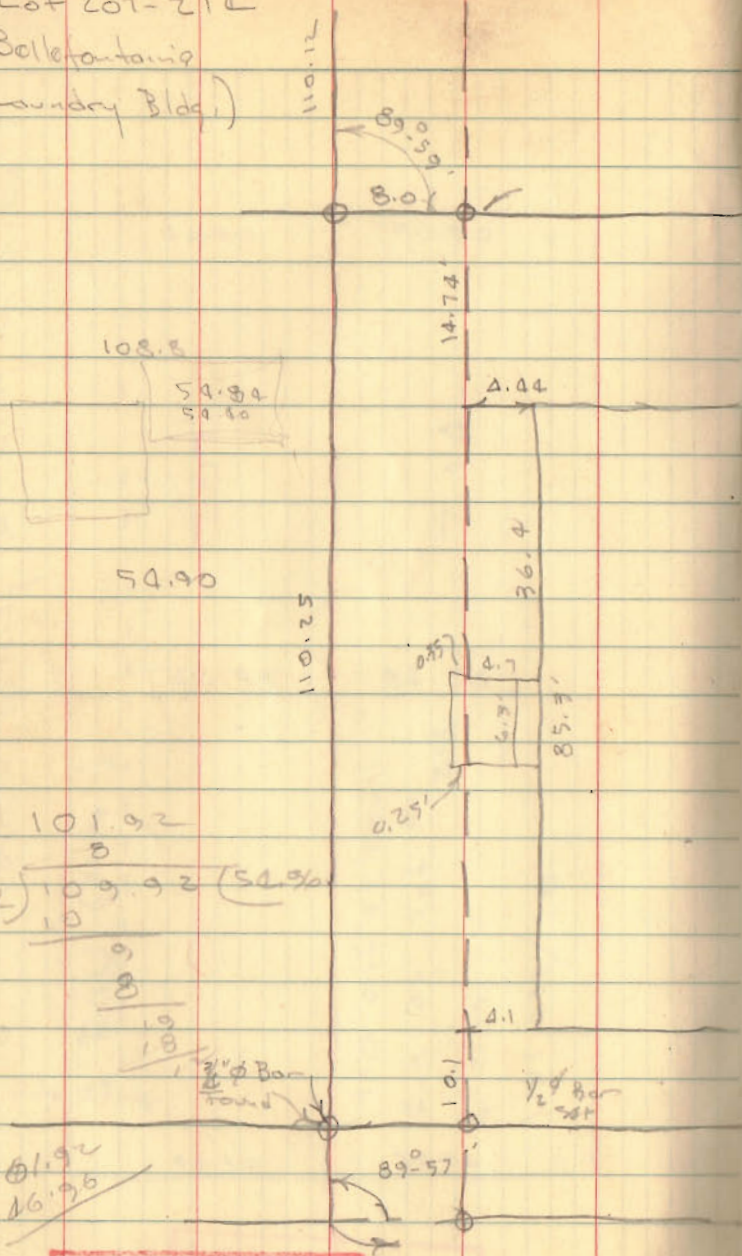

101.92
 8
 2) 109.92 (54.9%)
 18
 8
 18
 18

101.92
 46.96
 3/4\"/>

INDEXED ON MAP
 7004

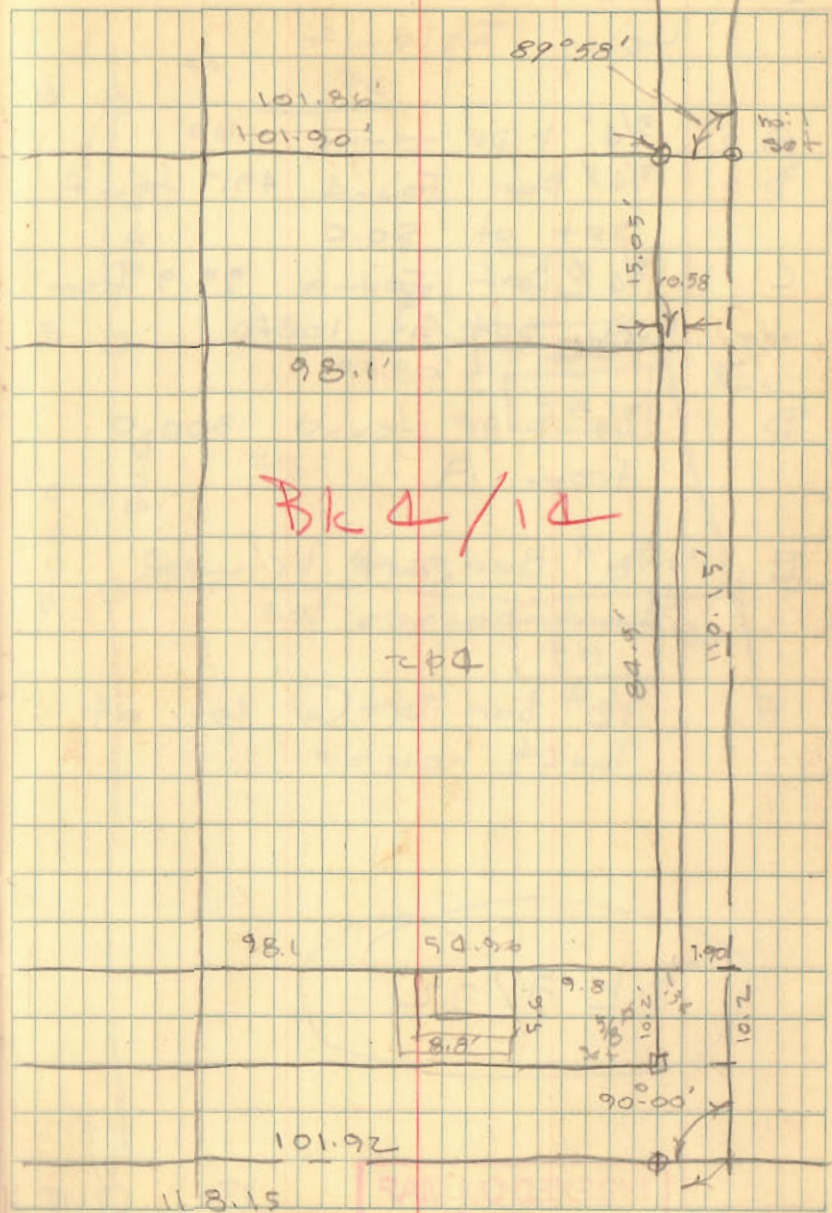

Bk 2/12

91102
 7004