


Received 5-9-85

N

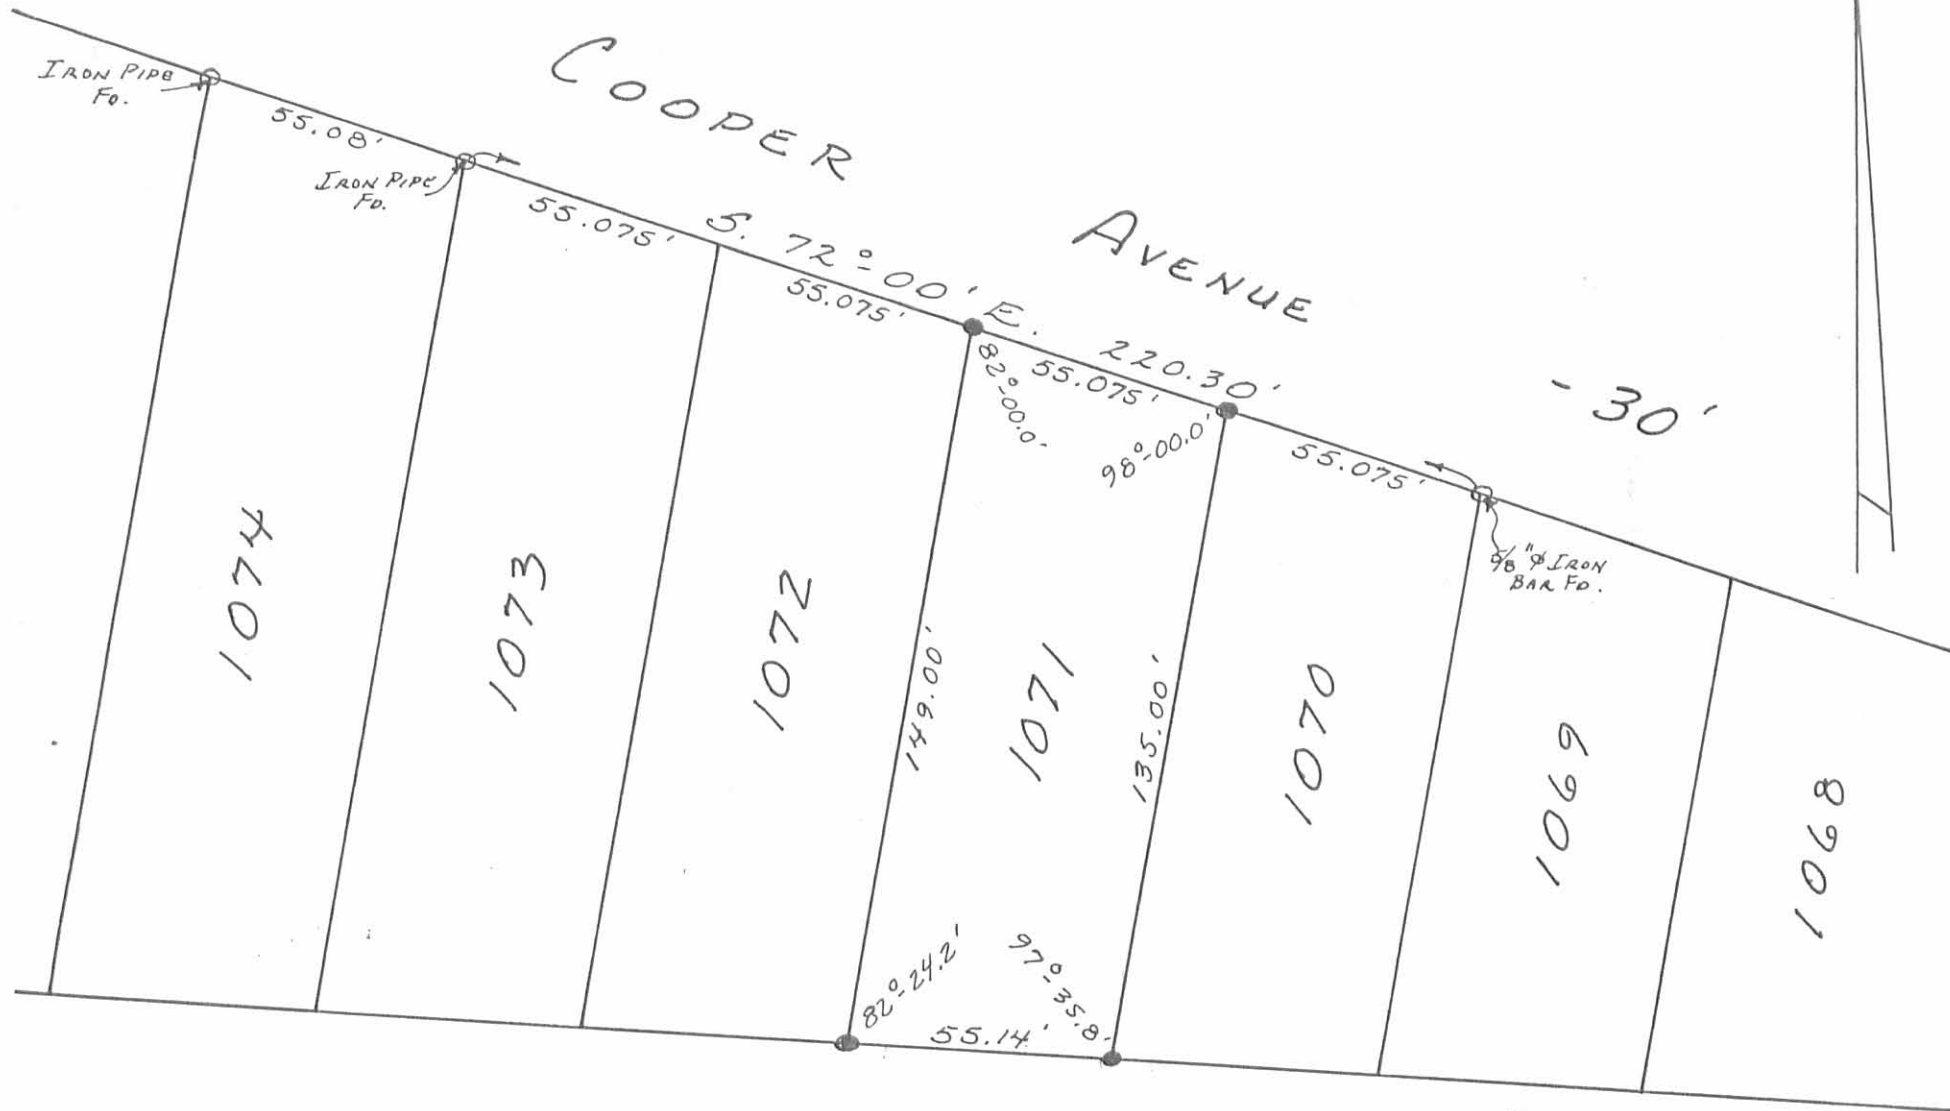

SNIDER SURVEY
 LOT NO. 1071
 CITY OF BELLEFONTAINE
 LAKE TOWNSHIP
 LOGAN COUNTY, OHIO
 APRIL 24, 1985

SCALE: 1" = 40'

085-006

INDEXED ON MAP
 7374 1P

● - 5/8" X 30" REBARS SET (CAPPED)

Daniel E. Gilbert
 DANIEL E. GILBERT, P.S.
 REG. SUR. NO. 5402
 105 ORGAN ST.
 BELLEFONTAINE, OHIO 43311