



Received 5-17-85

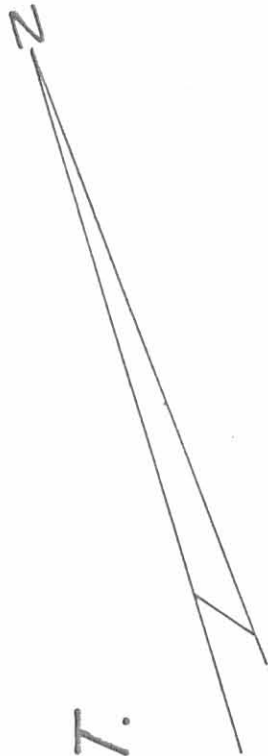

N. MAIN ST.

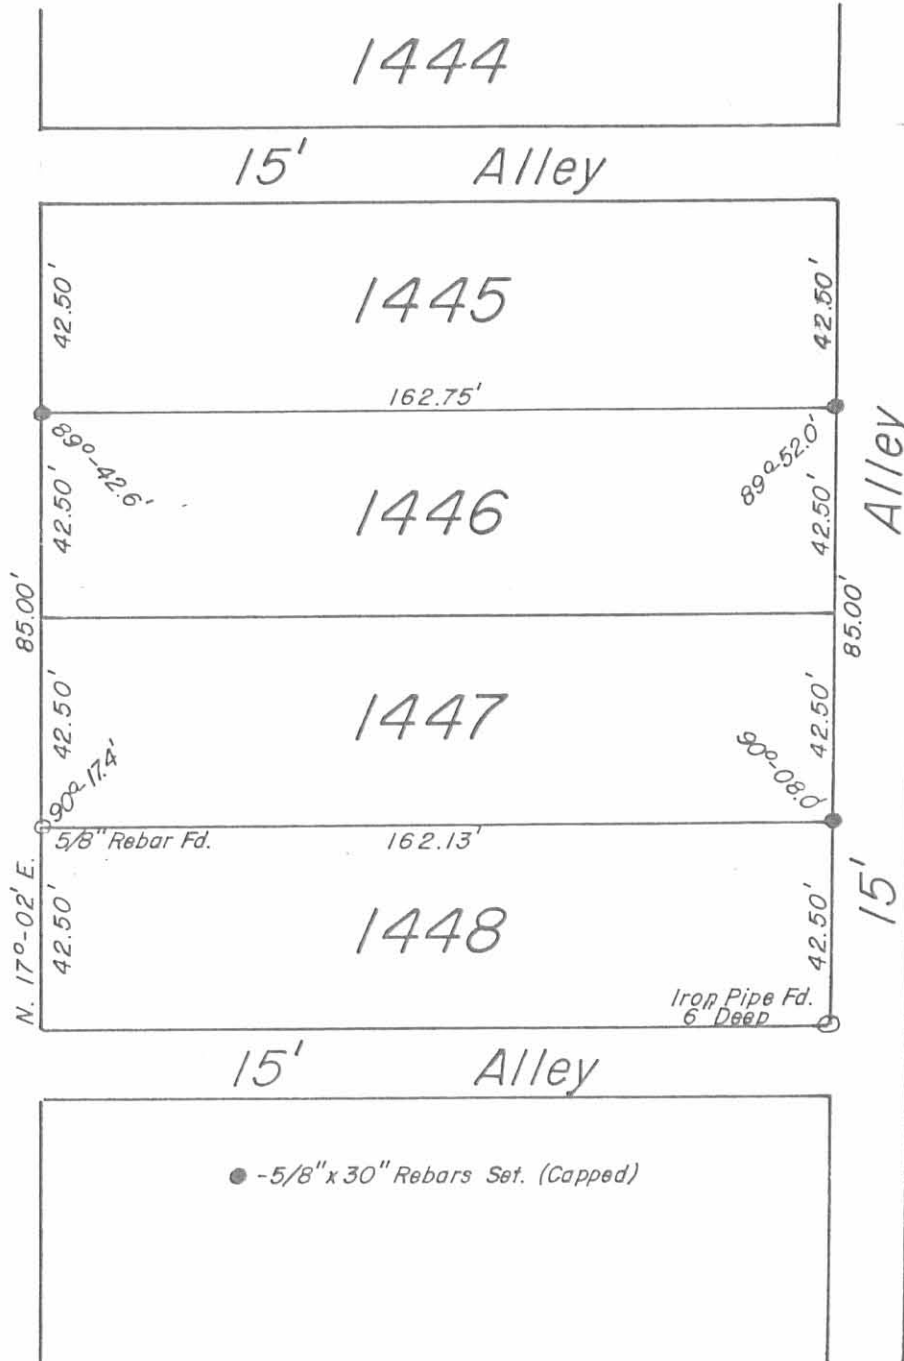

Survey of Lots 1446-1447
 City of Bellefontaine
 Lake Township
 Logan County, Ohio
 May 8, 1985

Scale: 1" = 40'

Daniel E. Gilbert

Daniel E. Gilbert, P.S.
 Reg. Sur. No. 5402
 105 Organ Street
 Bellefontaine, Ohio 43311

INDEXED ON MAP
 7380 1P