

SURVEY OF
 LOT 657
 BELLEFONTAINE, OHIO
 FEBRUARY 22, 1969
 SCALE 1"=20'
 • = 1/2" PIPE SET

I hereby certify that this plat
 is a correct representation of a
 survey made by me and that the
 same shows the improvements as
 located on the premises.

Dan L. Dodson

Dan L. Dodson
 Reg. Surveyor 4270
 Bellefontaine, Ohio

INDEXED ON MAP
 7516 1P

LOT 657

BELLEFONTAINE

HOGES EAST GROVE ADD.
PLAT BK A, Vol. 1, Pg. 10


See City Eng. F.B. 188 pg. 21 & 57
" " " " 302 pg. 24

INDEXED ON MAP
7516

Dodson
Nichols

Feb. 15, 1969
330


72

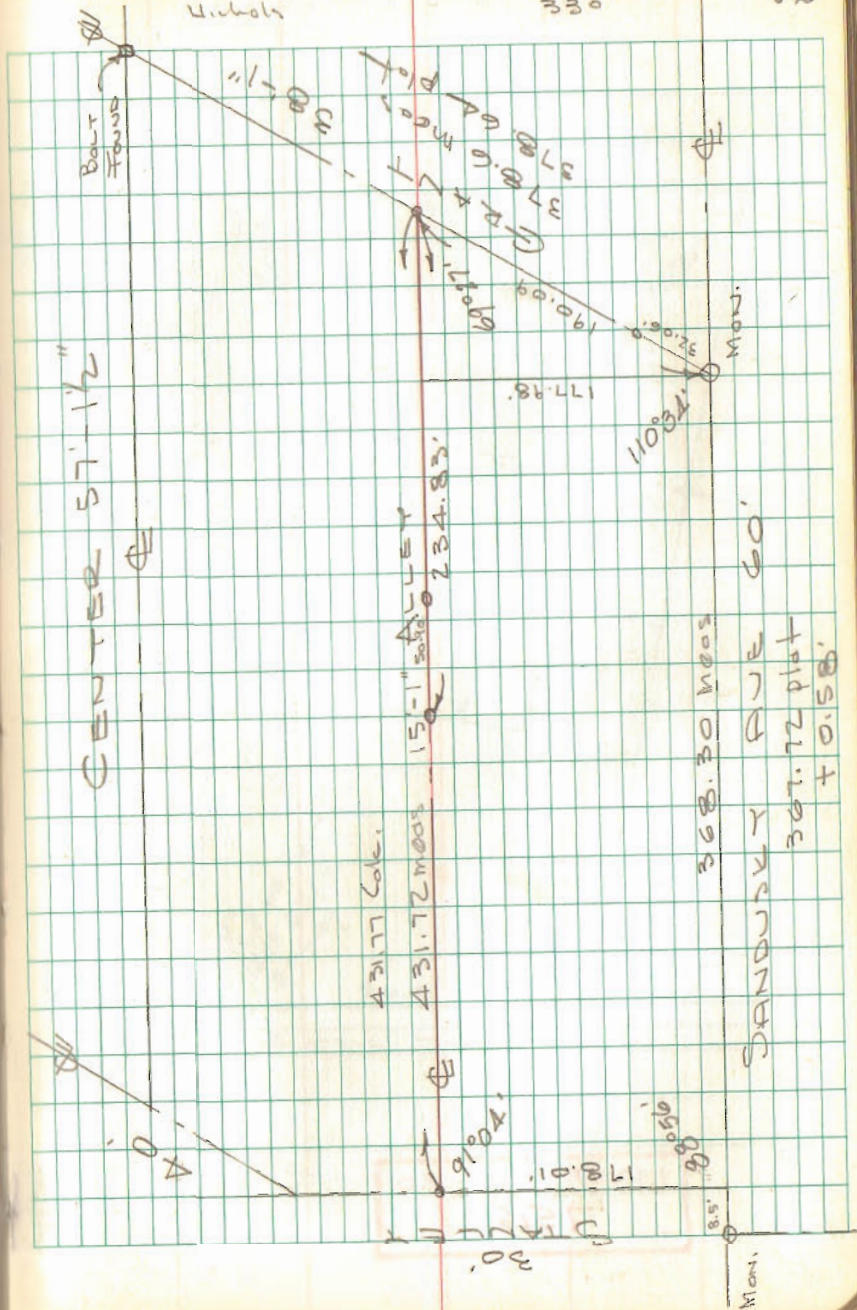

Lot 657 Cont'd.

Dodson
Nichols

2/22/69 73

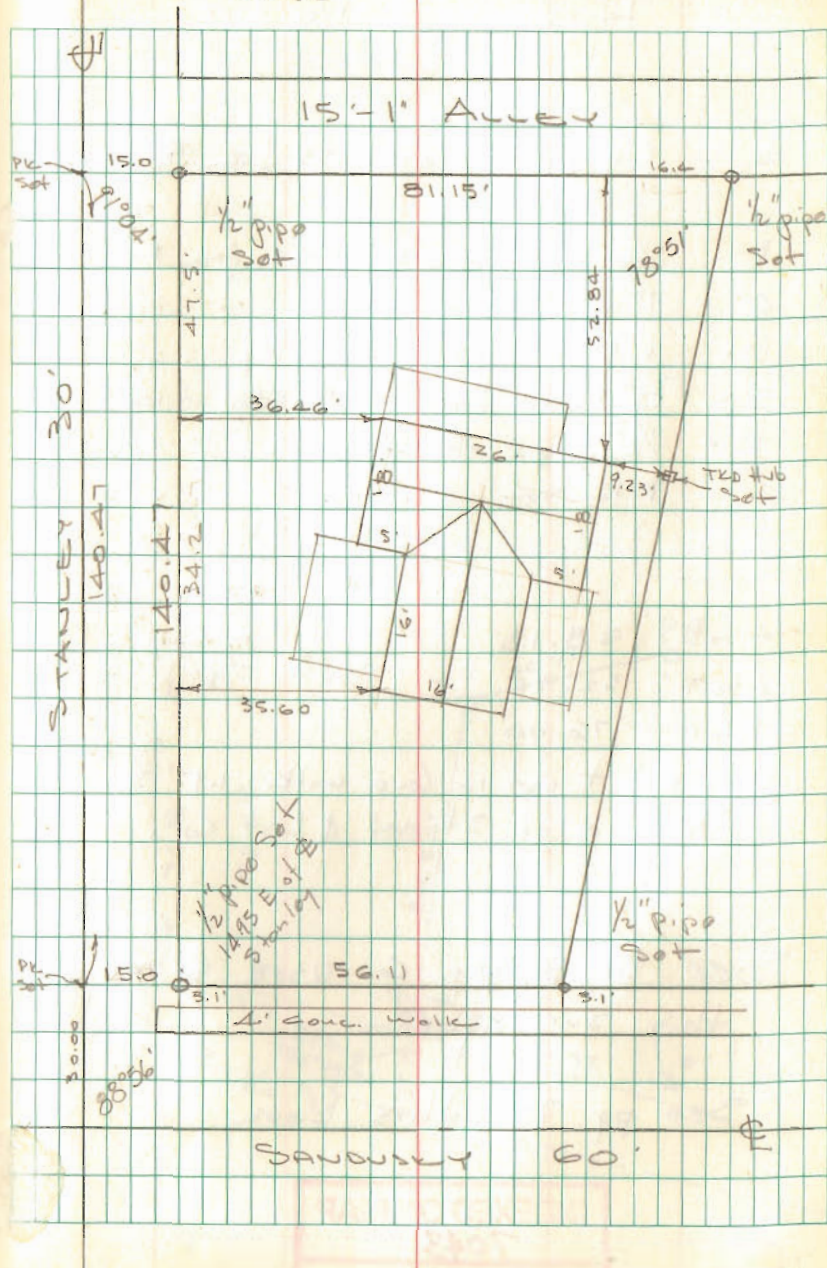

INDEXED ON MAP
7516