


REC'D 6-1-98 SM

LEGEND

- 5/8" IRON ROD SET
- 1.25" IRON ROD FOUND
- 3/4" BOLT FOUND

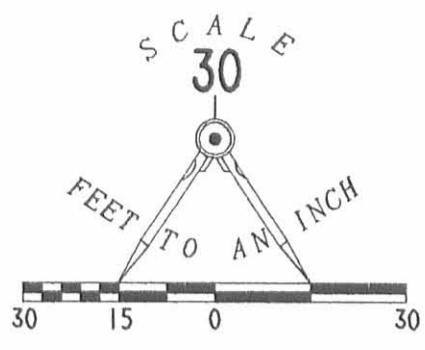

INDEXED ON MAP
9199 1P

RETRACEMENT SURVEY OF
THE KEITH WILLIAMSON
AND ALLISON JOAN WILLIAMSON
OFFICIAL RECORD 73, PAGE 16.
LOT 1790
OF NIVENS ADDITION TO THE
CITY OF BELLEFONTAINE,
SECTION 34, TOWN 4, RANGE 14
LAKE TOWNSHIP
LOGAN COUNTY, OHIO



ORIGINAL STAMP IN GREEN

SURVEYED BY:

Jeffrey I. Lee
JEFFREY I. LEE
PROFESSIONAL SURVEYOR 6359
MAY 28, 1998

COPYRIGHT 1998 BY:
LEE SURVEYING & MAPPING CO., INC.
117 North Madriver Street
BELLEFONTAINE, OHIO 43311
(937) 593-7335

2 WORKING DAYS
BEFORE YOU DIG
CALL TOLL FREE **800-362-2764**
OHIO UTILITIES PROTECTION SERVICE.

D-327 KETHWILL L-2646-3