


Recd 5-27-99 JLB

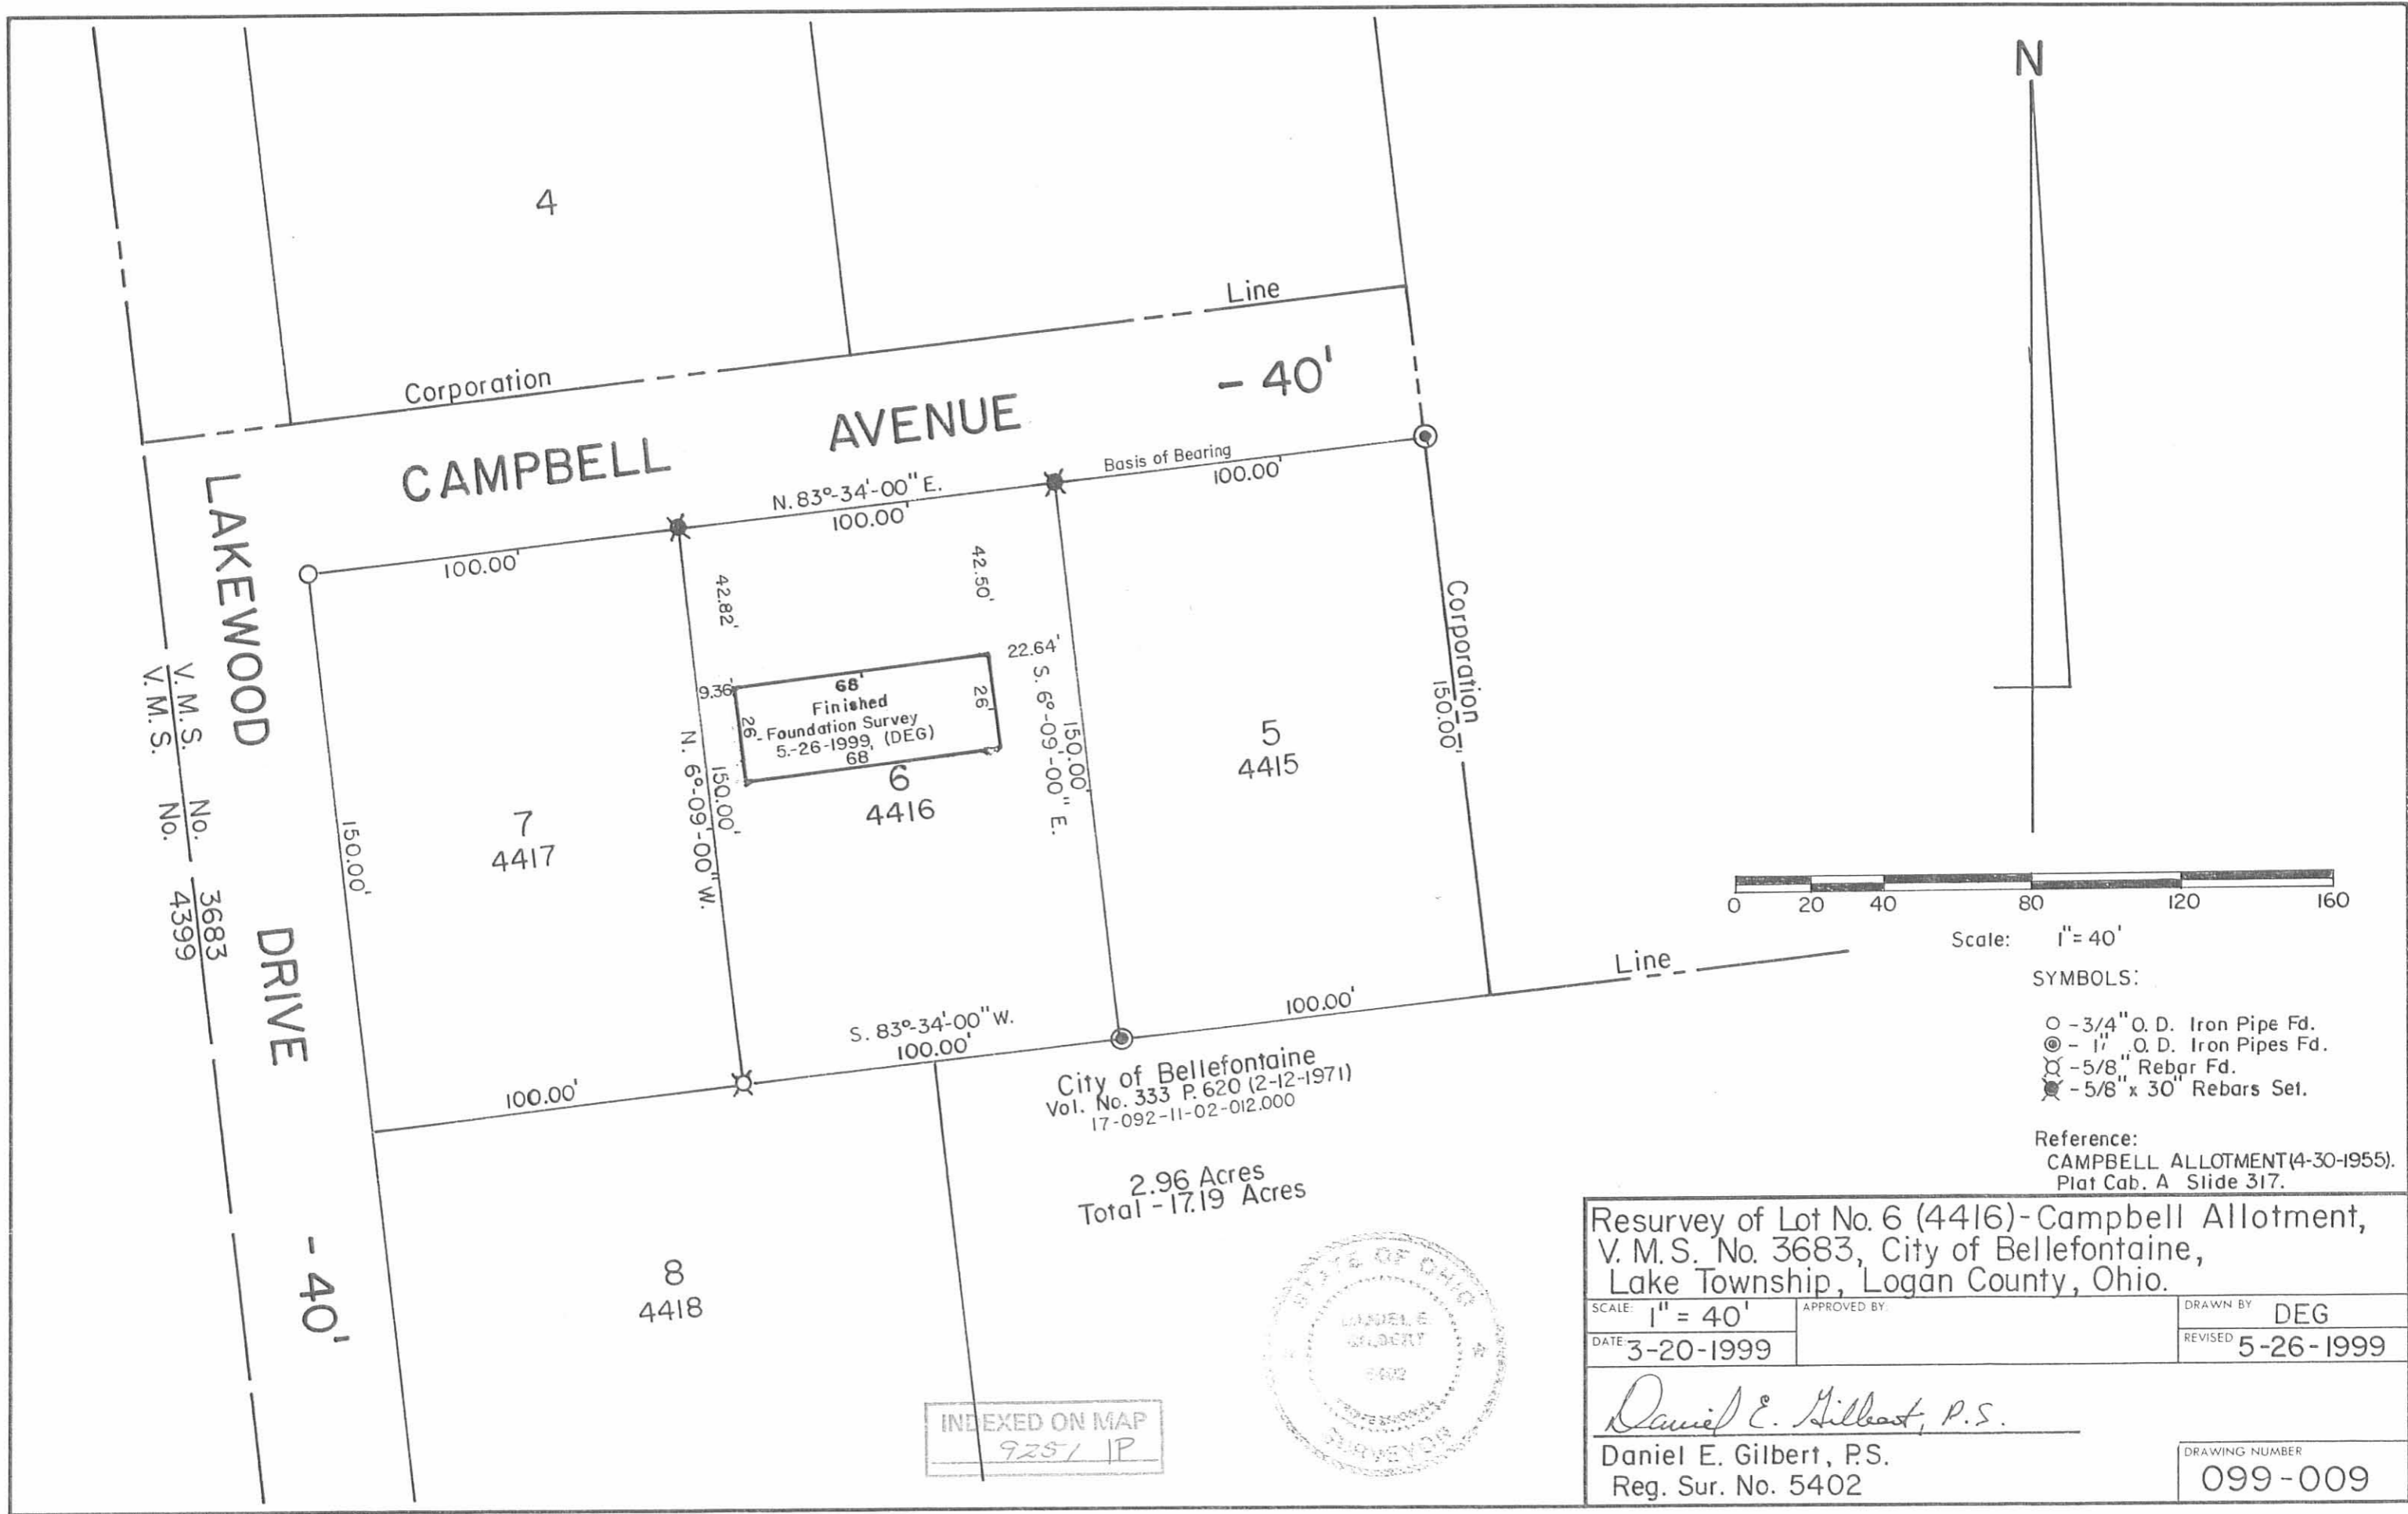

V.M.S. No. 3683
 V.M.S. No. 4399

LAKEWOOD DRIVE

- 40'

CAMPBELL AVENUE

- 40'

7
4417

6
4416

5
4415

8
4418

68'
 Finished
 Foundation Survey
 5-26-1999, (DEG)
 68'

City of Bellefontaine
 Vol. No. 333 P. 620 (2-12-1971)
 17-092-11-02-012.000

2.96 Acres
 Total - 17.19 Acres

INDEXED ON MAP
 9251 JP



Scale: 1" = 40'

SYMBOLS:

- - 3/4" O. D. Iron Pipe Fd.
- ⊙ - 1" O. D. Iron Pipes Fd.
- ⊗ - 5/8" Rebar Fd.
- ⊗ - 5/8" x 30" Rebars Set.

Reference:
 CAMPBELL ALLOTMENT (4-30-1955).
 Plat Cab. A Slide 317.

Resurvey of Lot No. 6 (4416)-Campbell Allotment,
 V. M. S. No. 3683, City of Bellefontaine,
 Lake Township, Logan County, Ohio.

SCALE: 1" = 40'	APPROVED BY:	DRAWN BY: DEG
DATE: 3-20-1999		REVISED: 5-26-1999

Daniel E. Gilbert, P.S.

Daniel E. Gilbert, P.S.
 Reg. Sur. No. 5402

DRAWING NUMBER
 099-009