
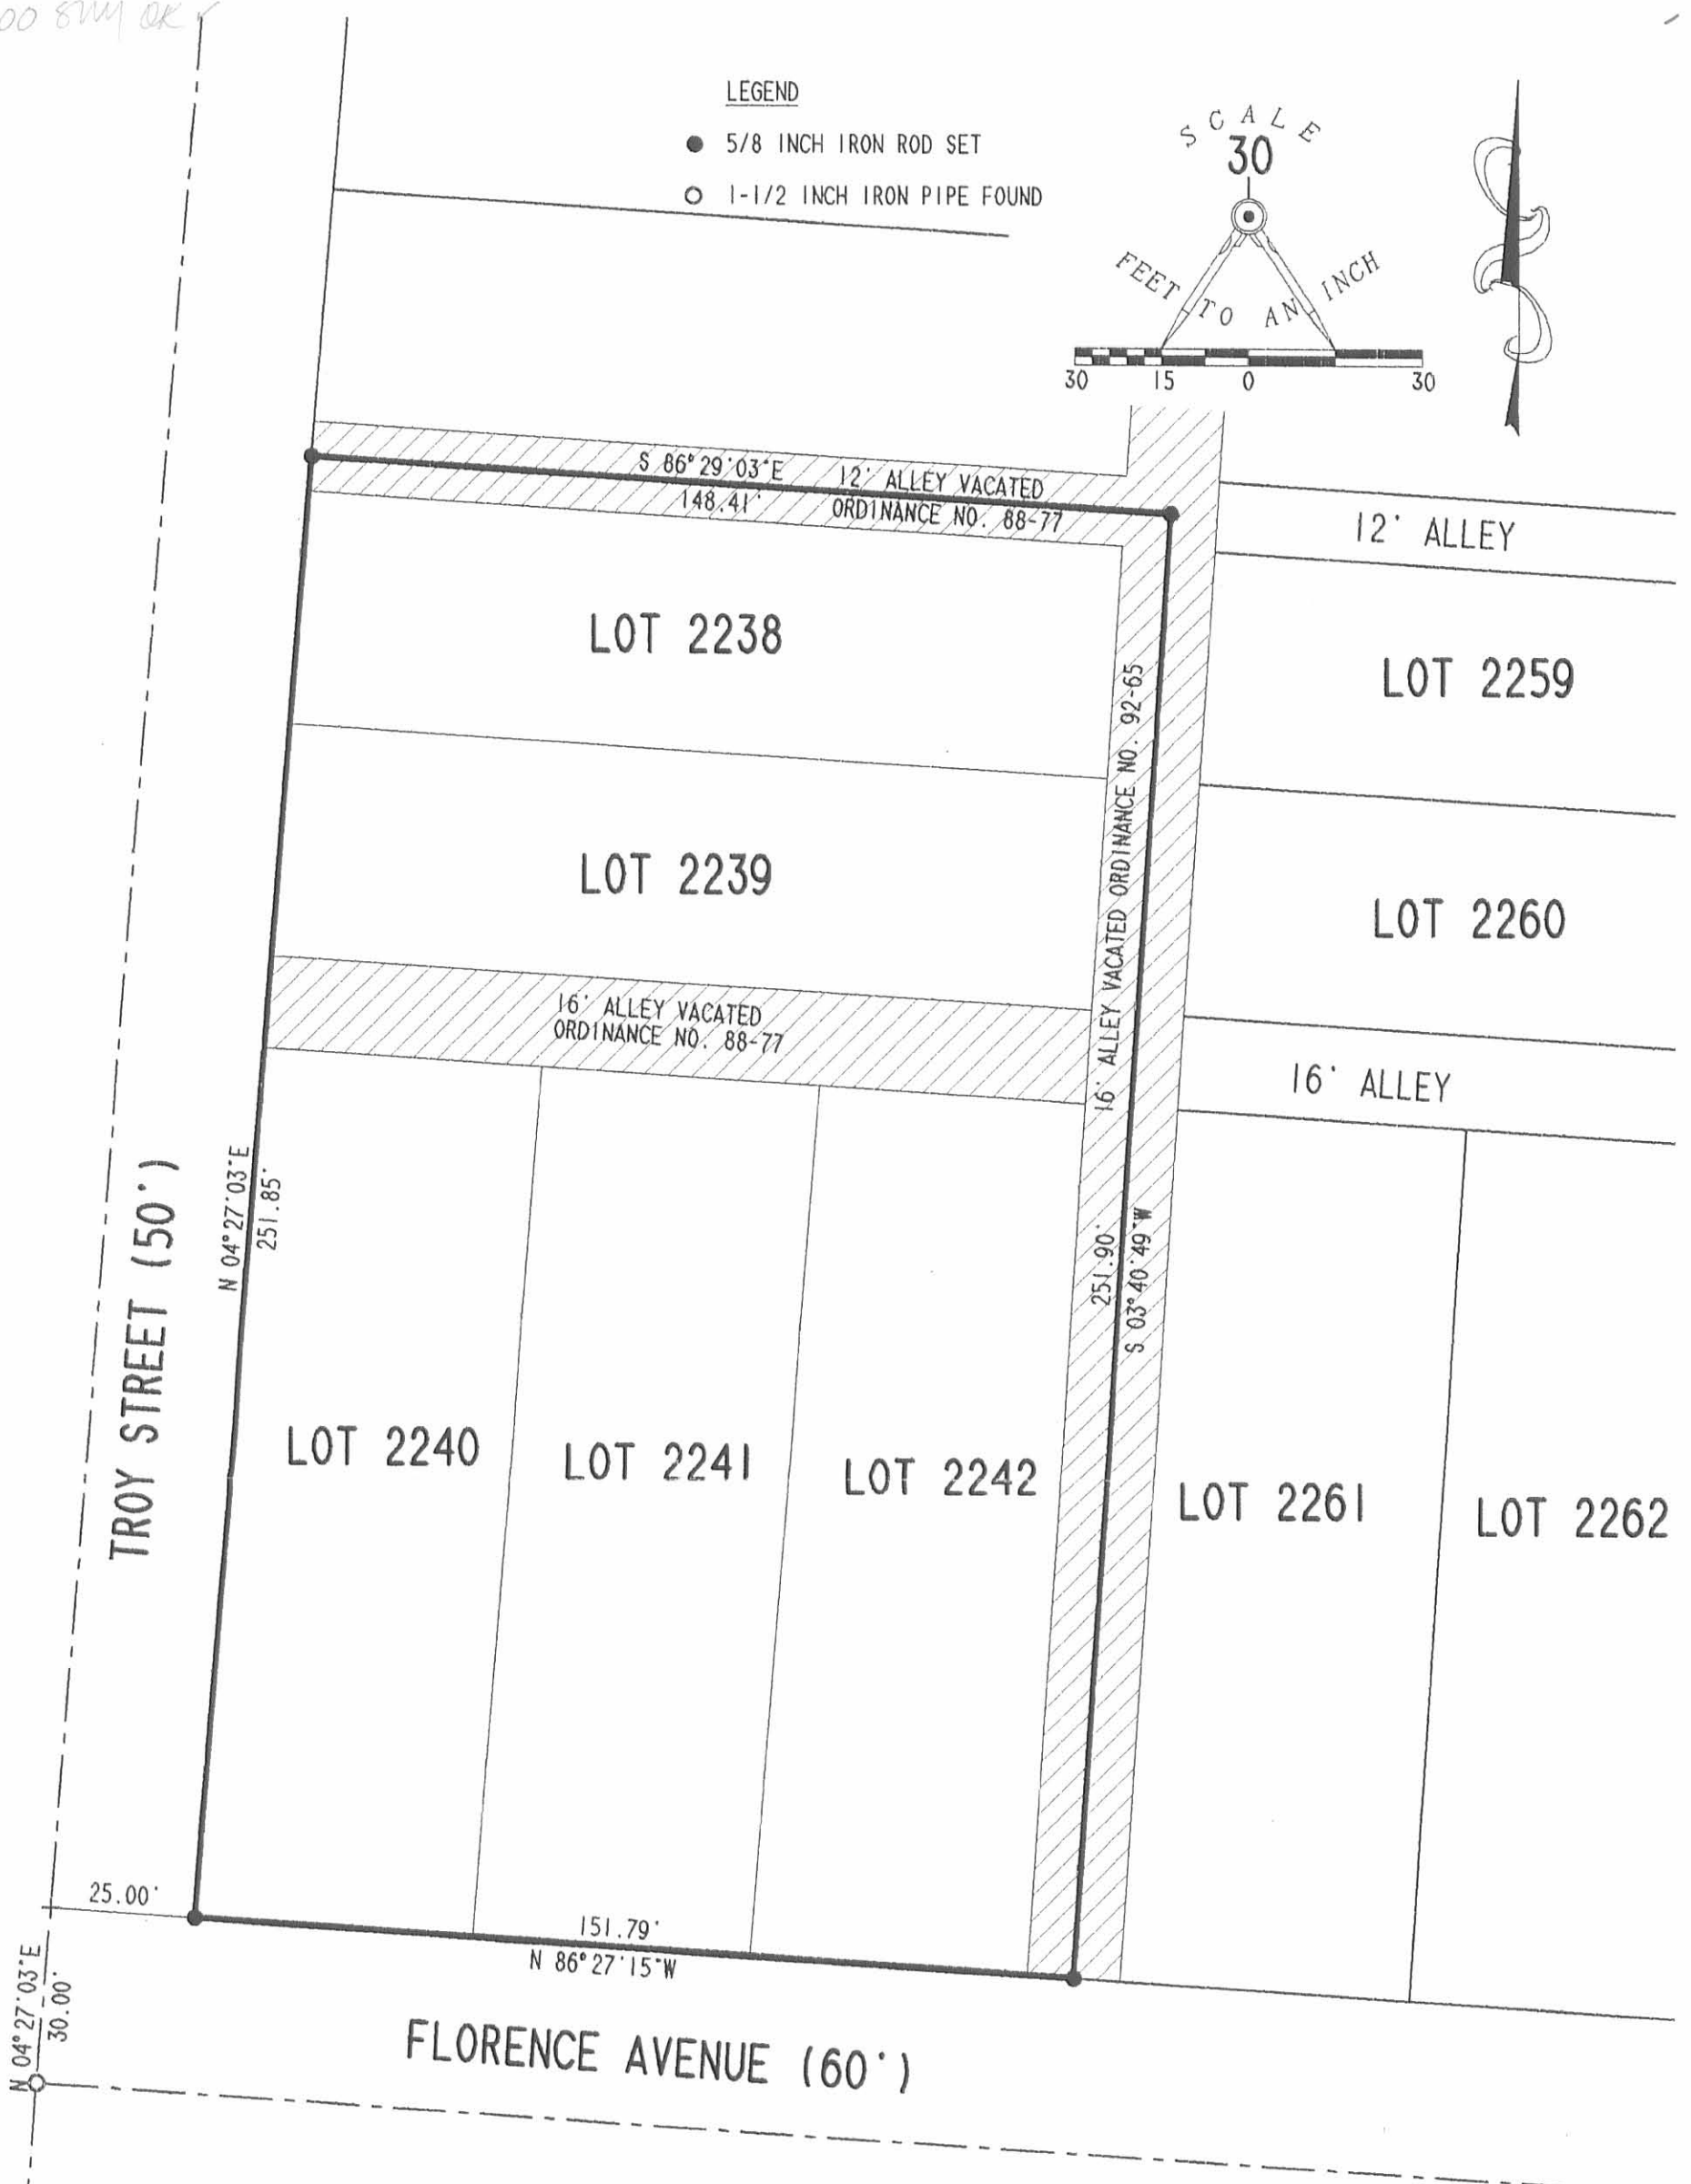


REC'D 6-19-00 8M OK

LEGEND

- 5/8 INCH IRON ROD SET
- 1-1/2 INCH IRON PIPE FOUND

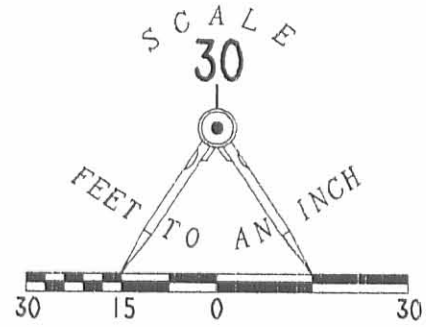

RETRACEMENT SURVEY OF THE  
 LOTS 2238, 2239, 2240, 2241 AND 2242  
 McCracken's Addition of  
 THE CITY OF BELLEFONTAINE  
 PLAT CABINET A, SLIDE 43  
 LAKE TOWNSHIP  
 LOGAN COUNTY, OHIO

SURVEYED BY:

*William K. Bruce*  
 WILLIAM K. BRUCE

PROFESSIONAL SURVEYOR 7437  
 MAY 23, 2000



ORIGINAL STAMP IN GREEN

COPYRIGHT 2000 BY:  
 LEE SURVEYING & MAPPING CO., INC.  
 117 North Madriver Street  
 BELLEFONTAINE, OHIO 43311  
 (937) 593-7335

2 WORKING DAYS  
**BEFORE YOU DIG**  
 CALL TOLL FREE **800-362-2764**  
 OHIO UTILITIES PROTECTION SERVICE.

INDEXED ON MAP  
 9322 IP