

LOT 783-784

MC BETH ADD.

FOR PROCTOR BROS.


LOTS 50' x 220'

- A = $\frac{3}{4}$ " ϕ Dor Found
- B = $\frac{1}{2}$ " Pipe "
- C = $\frac{3}{4}$ " " "
- D = $\frac{3}{4}$ " ϕ Dor Found
- E = $\frac{1}{2}$ " Pipe Found
- F = $\frac{3}{4}$ " " "
- G = $\frac{3}{4}$ " " "
- H = 1" " "
- I = $\frac{3}{4}$ " " "
- J = $\frac{1}{2}$ " " "

SEE CITY ENG. BK. 243 PG. 19
FOR PREVIOUS SURVEY.

D. Dodson
G. Geeslin

4-14-62
40° 31

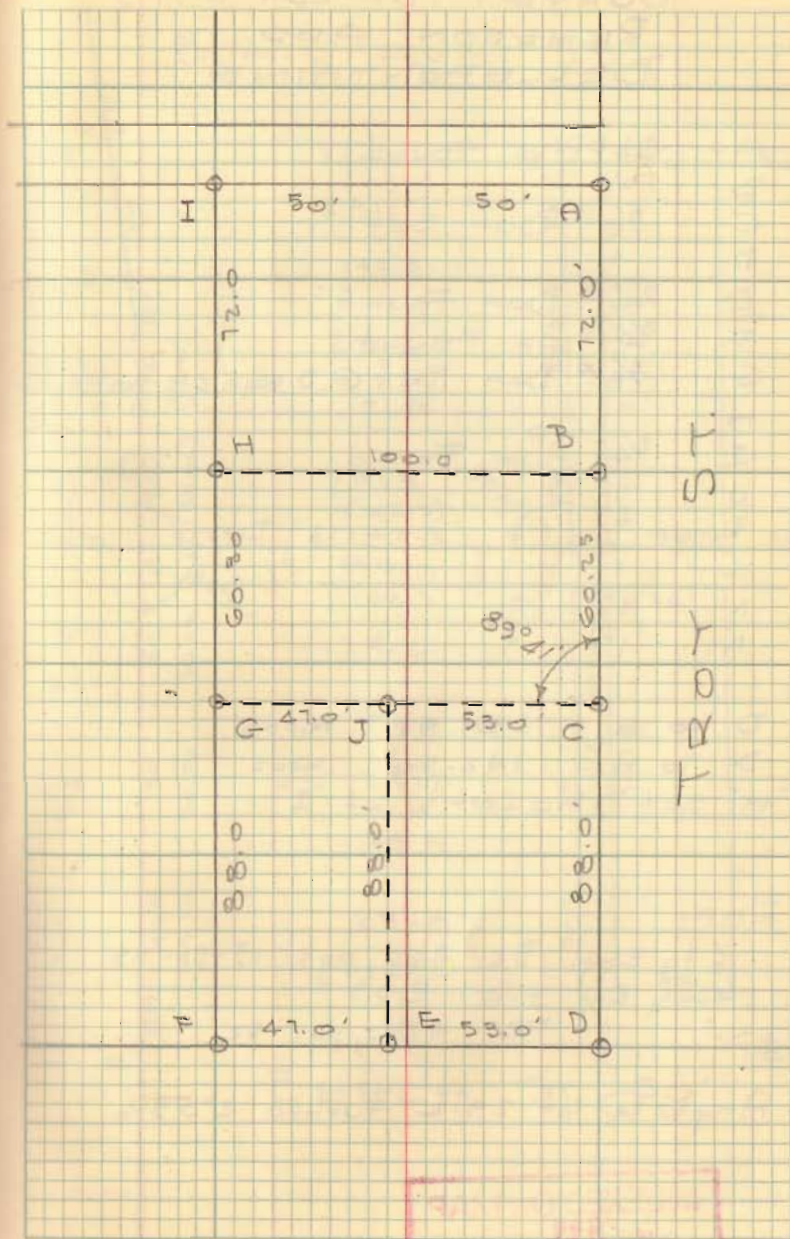

INDEXED ON MAP
9611

Pt Lot 783-784
 Troy St @ Chillicothe
 For Proctor Bros.
 Dodson
 G. Conline

See City Bk 243/79

Bk 4 / 31

$$\begin{array}{r} 2.5 \\ 3 \\ \hline 7.50 \end{array}$$

$$\begin{array}{r} 179.60 \\ 59.21 \\ \hline 90.19 \end{array}$$

W

INDEXED ON MAP
 9611

