


REV'D 5-27-10 SMM/OK

LEGEND:


- ⊕ 1 INCH IRON PIPE FOUND
- ⊙ 3/4 INCH IRON PIPE FOUND
- 5/8 INCH IRON ROD SET WITH PLASTIC I.D. CAP STAMPED "LSM 7437"

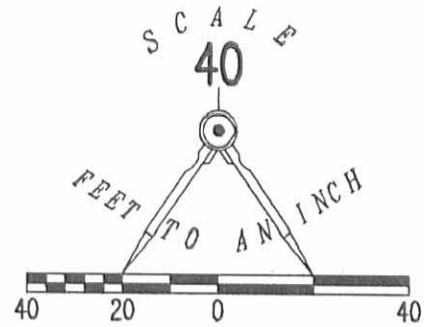

CHILlicothe AVENUE (60')

TROY STREET (60')

EATON STREET (60')

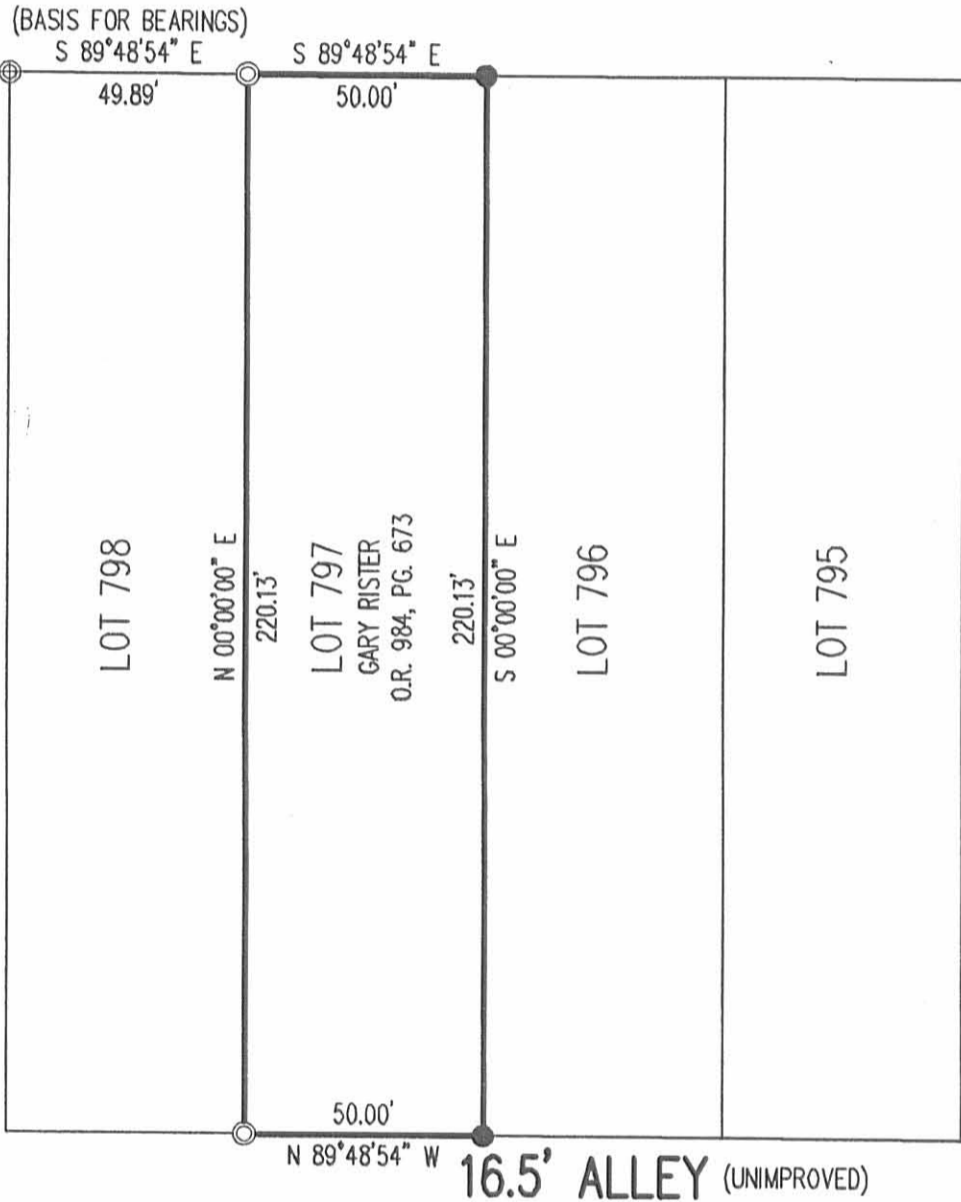

RETRACEMENT SURVEY OF THE
 GARY RISTER
 LOT 797
 McBETH ADDITION
 PLAT CABINET A, SLIDE 11
 OFFICIAL RECORD 984, PAGE 673
 CITY OF BELLEFONTAINE
 LAKE TOWNSHIP
 LOGAN COUNTY, OHIO



SURVEYED BY:

William K. Bruce
 WILLIAM K. BRUCE
 PROFESSIONAL SURVEYOR 7437
 MAY 25, 2010

ORIGINAL STAMP IN GREEN

COPYRIGHT 2010 BY:
 LEE SURVEYING & MAPPING CO., INC.
 117 North Madriver Street
 BELLEFONTAINE, OHIO 43311
 (937) 593-7335

KSS D0510 4962510 L-4962-3

2 WORKING DAYS
BEFORE YOU DIG
 CALL TOLL FREE **800-362-2764**
 OHIO UTILITIES PROTECTION SERVICE.

INDEXED ON MAP
 9635 1P