


REC'D 5-22-12 SUM AU

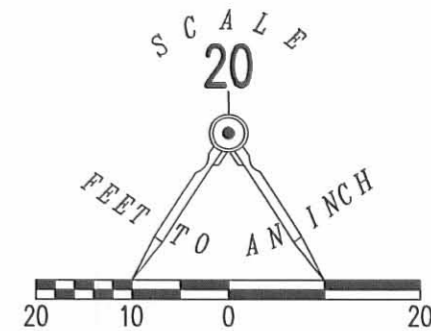


BROWN AVENUE (30')

LEGEND


⊙ 1 INCH IRON PIPE FOUND

MADRIVER STREET (60 FEET WIDE)

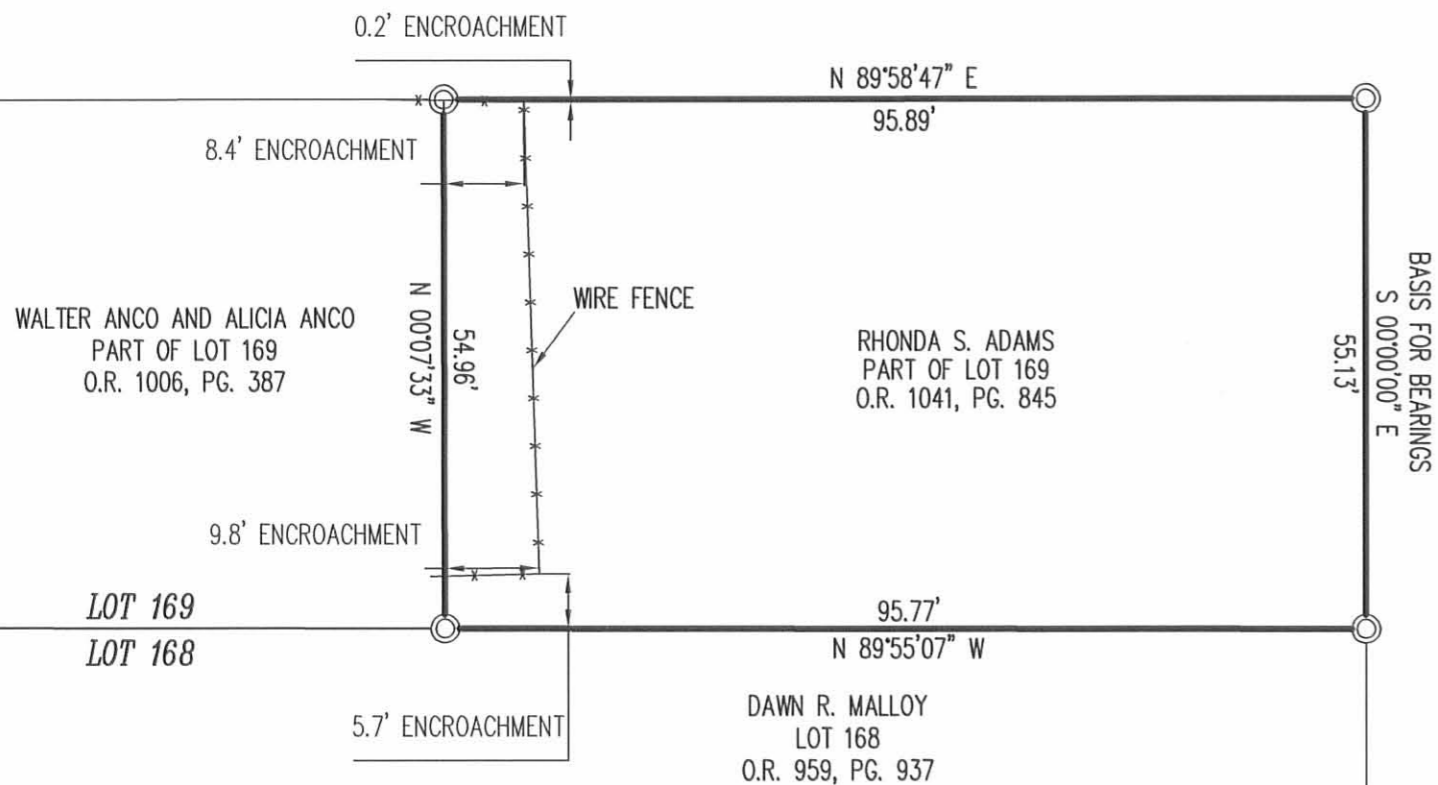

RETRACEMENT SURVEY OF
RHONDA S. ADAMS
PART OF LOT 169
OFFICIAL RECORD 1041, PAGE 845
ORIGINAL PLAT OF BELLEFONTAINE
PLAT CABINET A, SLIDE 1
CITY OF BELLEFONTAINE
LAKE TOWNSHIP
LOGAN COUNTY, OHIO

SURVEYED BY:

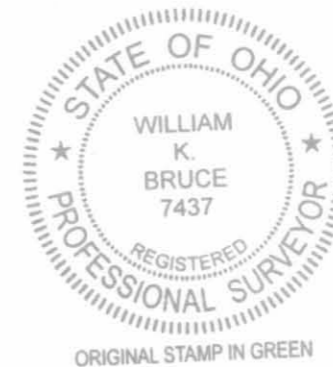

William K. Bruce
WILLIAM K. BRUCE
PROFESSIONAL SURVEYOR 7437
MAY 18, 2012

COPYRIGHT 2012 BY:
LEE SURVEYING & MAPPING CO., INC.
117 North Madriver Street
BELLEFONTAINE, OHIO 43111
(937) 593-7335
WWW.LSMINC.US
surveys@lsminc.us

ADW D0512 53290512 L-5329-3

ORIGINAL PLAT OF BELLEFONTAINE
PLAT CABINET A, SLIDE 1

2 WORKING DAYS
BEFORE YOU DIG
CALL TOLL FREE 800-362-2764
OHIO UTILITIES PROTECTION SERVICE

INDEXED ON MAP
9647 IP