


Emma V. Hall Survey Bloomfield Township  
R 8 - T 7 Sec. 28



INDEXED ON MAP

Showing Witness To B

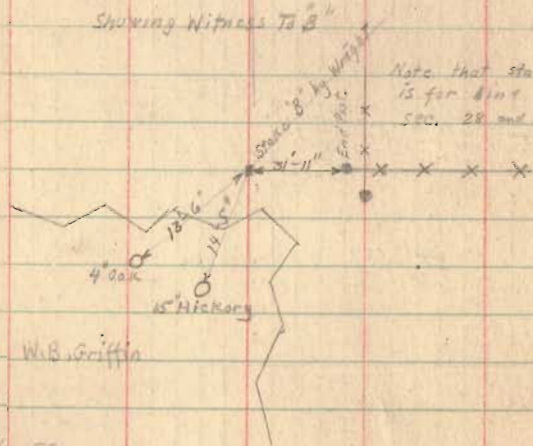


Note that stake B is for line between Sec. 28 and 21 only.

See Book 53  
and Box H in H<sub>2</sub>  
for 1906 Survey.  
Box H<sub>1</sub> for 1924

May 16-1924  
Clear.

F. Wright

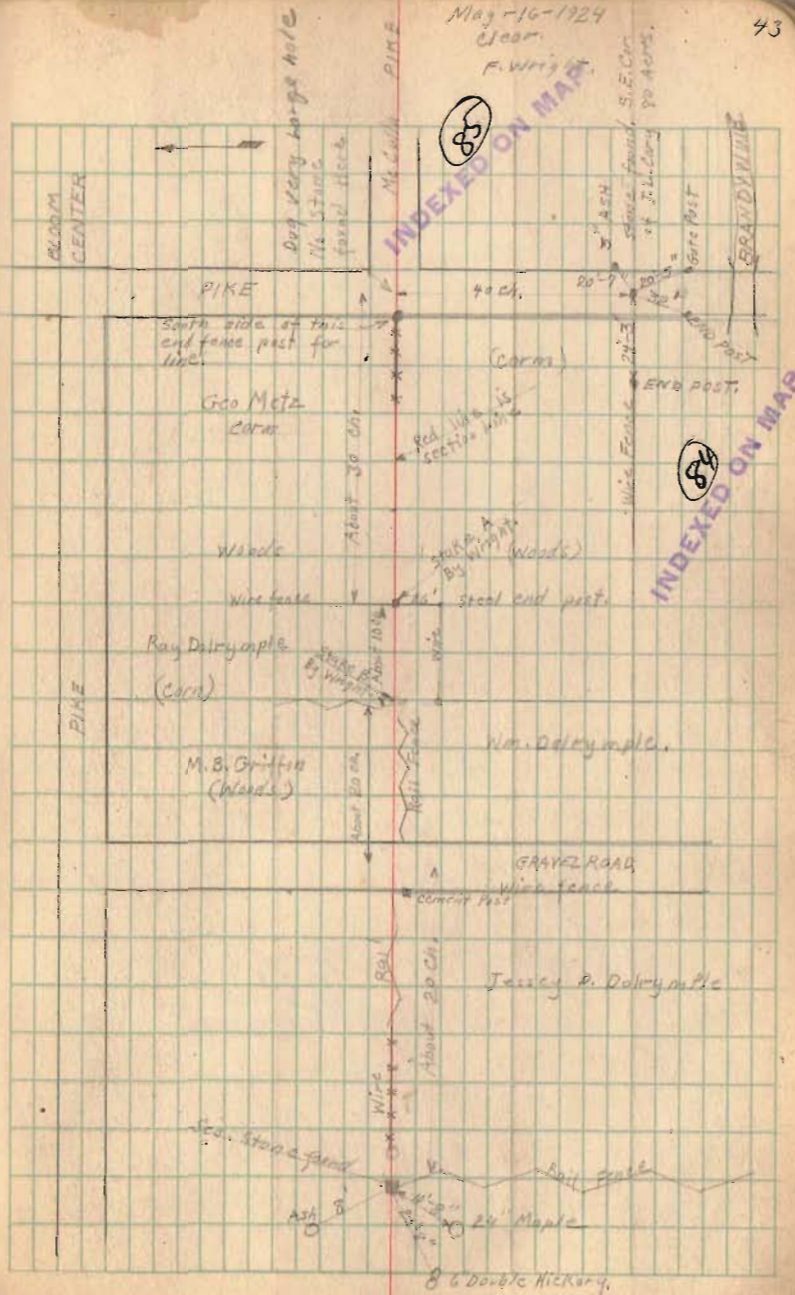

INDEXED ON MAP

W. H. Lusk

