

Note a bur oak ≈ 65 W 12 L the black oak is broken down
 thence on the east line of the sec. ≈ 8 E ≈ 10 S a small
 branch at 118 poles) $16\frac{1}{2}$ poles marked a small black
 oak ≈ 85 E 11 L a black oak bush at 26 W $10\frac{1}{2}$ L
 thence west $32\frac{1}{2}$ poles to the original 90 sec corner between
 Secs 10 & 11 a white oak $57\frac{1}{2}$ W 12 L a hickory ≈ 37 E 20 L
 thence between Secs 10 & 11 $5\frac{1}{2}$ W $16\frac{1}{2}$ poles to the beginning
 containing $33\frac{1}{2}$ acres - The division line begins in
 the south line of the sec. at $16\frac{1}{2}$ poles from each
 corner a hickory ≈ 29 E 16 L a hickory 558 W 12 L thence
 ≈ 4 E $16\frac{1}{2}$ poles to a stake in the centre of the sec.
 La King & Co
 J. C. Clayton


La. M. Manner
 C. S. G. C.

March 9th 1833

Survey No. 205

Stockwell }
 Smith }
 Downy }
 2000 }
 2000 }
(3291)

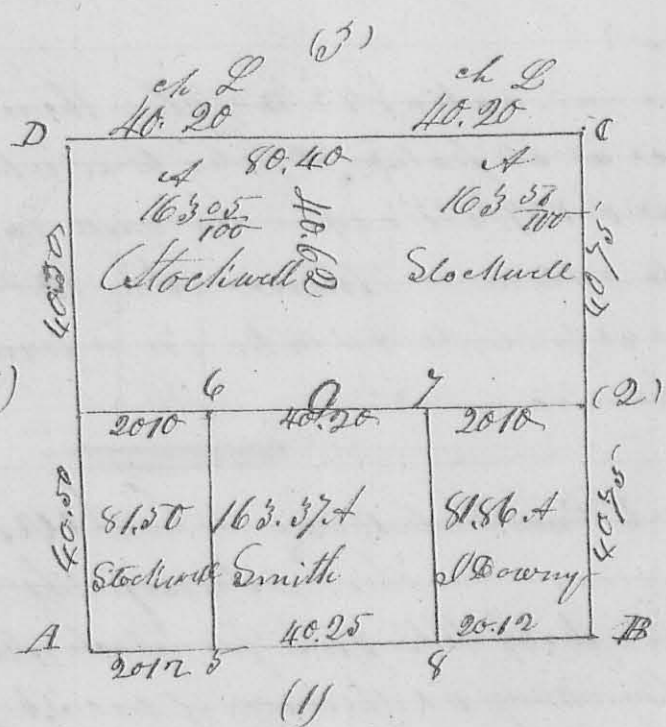

Bearing of the section lines in the above plat is as
 follows A. B. $\approx 84\frac{3}{4}$ E 80 ch 50 L thence ≈ 75 W 81.50 ch
 thence ≈ 85 W 50.40 ch - thence ≈ 88 E ch -

Corners of section and division lines are as follows
 At A Sec. corner - at 5 Ash W 11 D. 11 E $3\frac{1}{2}$ L Iron
 = wood ≈ 83 W 17 L. at 6 water beech $4\frac{1}{2}$ D. $53\frac{1}{2}$ W 17 L
 ash 22 D. $\approx 30\frac{1}{2}$ E $2\frac{1}{2}$ L At O Lynn 36 D. East 17 L

Two imp. ch. 18th S. 26th 1792^L - at 7 bech 18th S. 26th 17th 15th 2
 bech 18th S. north 50th L At original corner post
 At B see corner - at 2 old gr. sep. post - at C see
 corner - at D bech 18th S. 26th 17th 15th 2
 11th L at D see corner at A bech 3th S. 26th 17th 15th 2
~~12th L at 18th S. 26th 17th 15th 2~~ - Corner tree

I certify the foregoing to be correct and true as made
 by me March 9th 1833 for - Stockwell, Smith &
 Israel Downy on them for being the return of said
 subdivision of Sec 26th 27th 28th E - D Hopkins Deputy S. 26th

I certify the foregoing a true copy as returned to me

J. W. Mearns

[Signature]
 1833

March 15th 1833

Survey No 206

Hugh Rowell }
 R. Braider }
 + Hoays }
 No 206 }
 _____ }

No 2 of
 Deputy
 Surveyor

Red oak

	East	
39.08	156.22 A	39.16
38.57		
26.1	12.90	31.31 A
104.36	50.4	1/2 S. 26 th
25.70	12.90	38.18

original corner
 ash + hickory

Original corner
 of the sec -

The two north corners of the above fifty acres lot
 no trees near - This survey No 2 (of survey returned
 of my Deputy) represents Sec 11 T. 16 N. 13 W. for
 Hugh Rowell, R. Braider, Hoays & Hoays - adjoining
 Brown - March 15th 1833 - D Hopkins Deputy Surveyor
 I certify the foregoing to be a correct copy of the survey No 2
 of my Deputy D Hopkins as returned to me for record -

J. W. Mearns
 1833

[Faint handwritten notes and numbers]