


COUNTY LINE SURVEY

1876 By F.J. Sager.

(180)

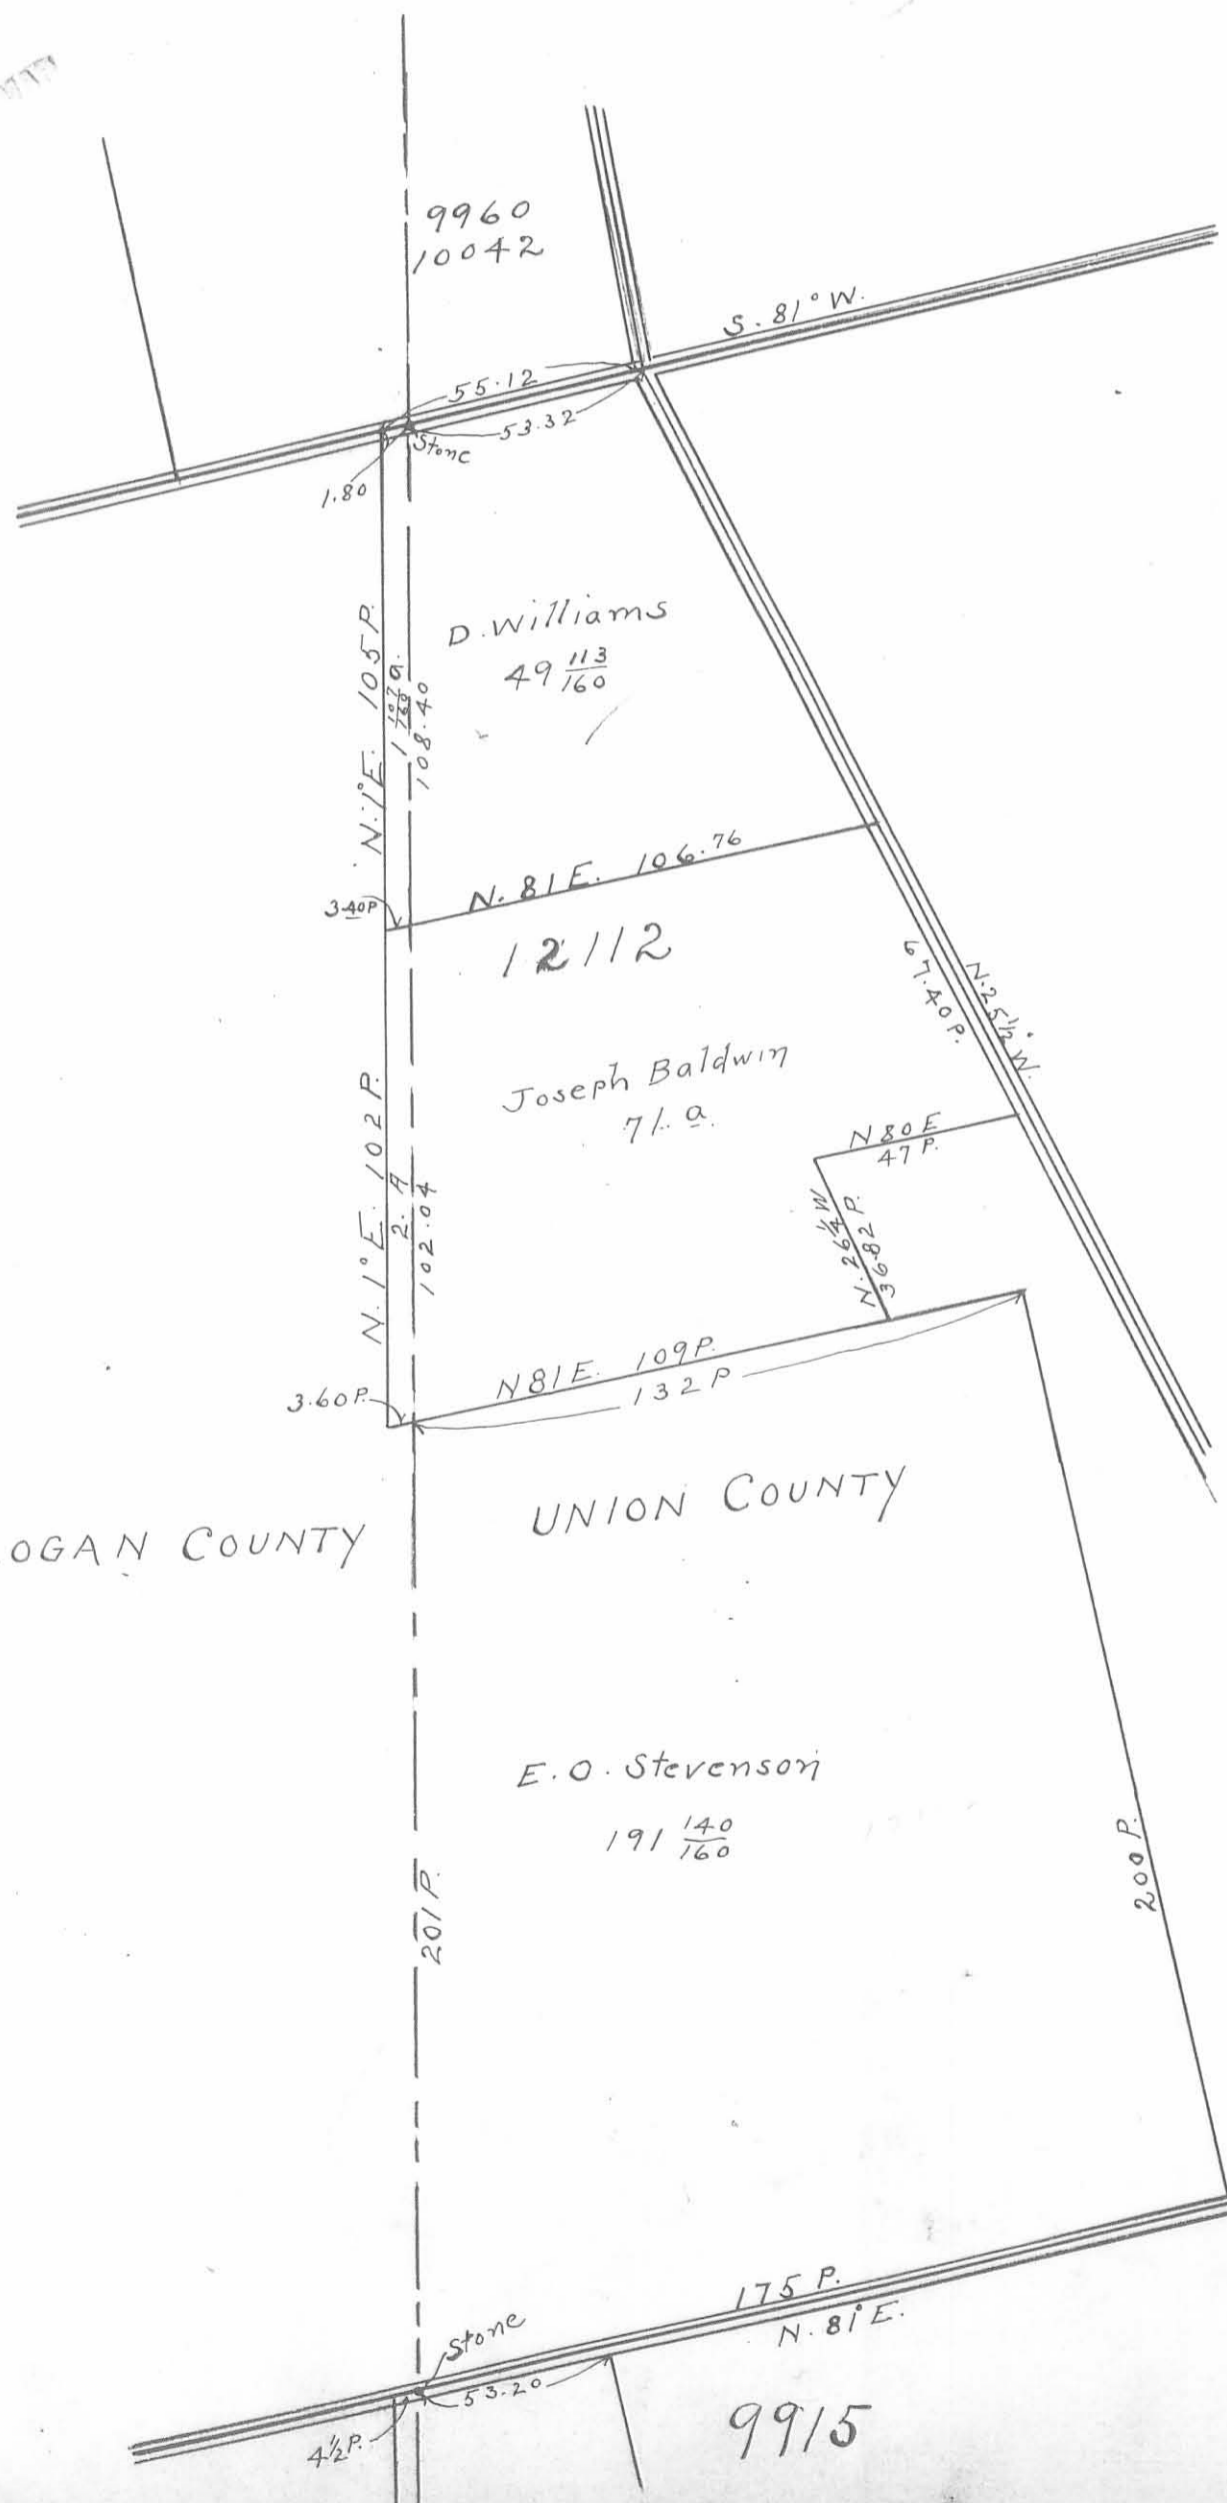

165  
180  
-----  
1320  
165  
-----  
277

105  
4.5  
82.5  
-----  
86.0  
79.25