

Road No. 267
 King Road
 Bokoschek Tap.
 V.M.S. 9937


length 3955 Feet
 .75 Mile.

Old Lane 20'
 10' Added To West side as shown.

stakes 1-3-5-7-9-11 etc.

INDEXED ON MAP

(1671)

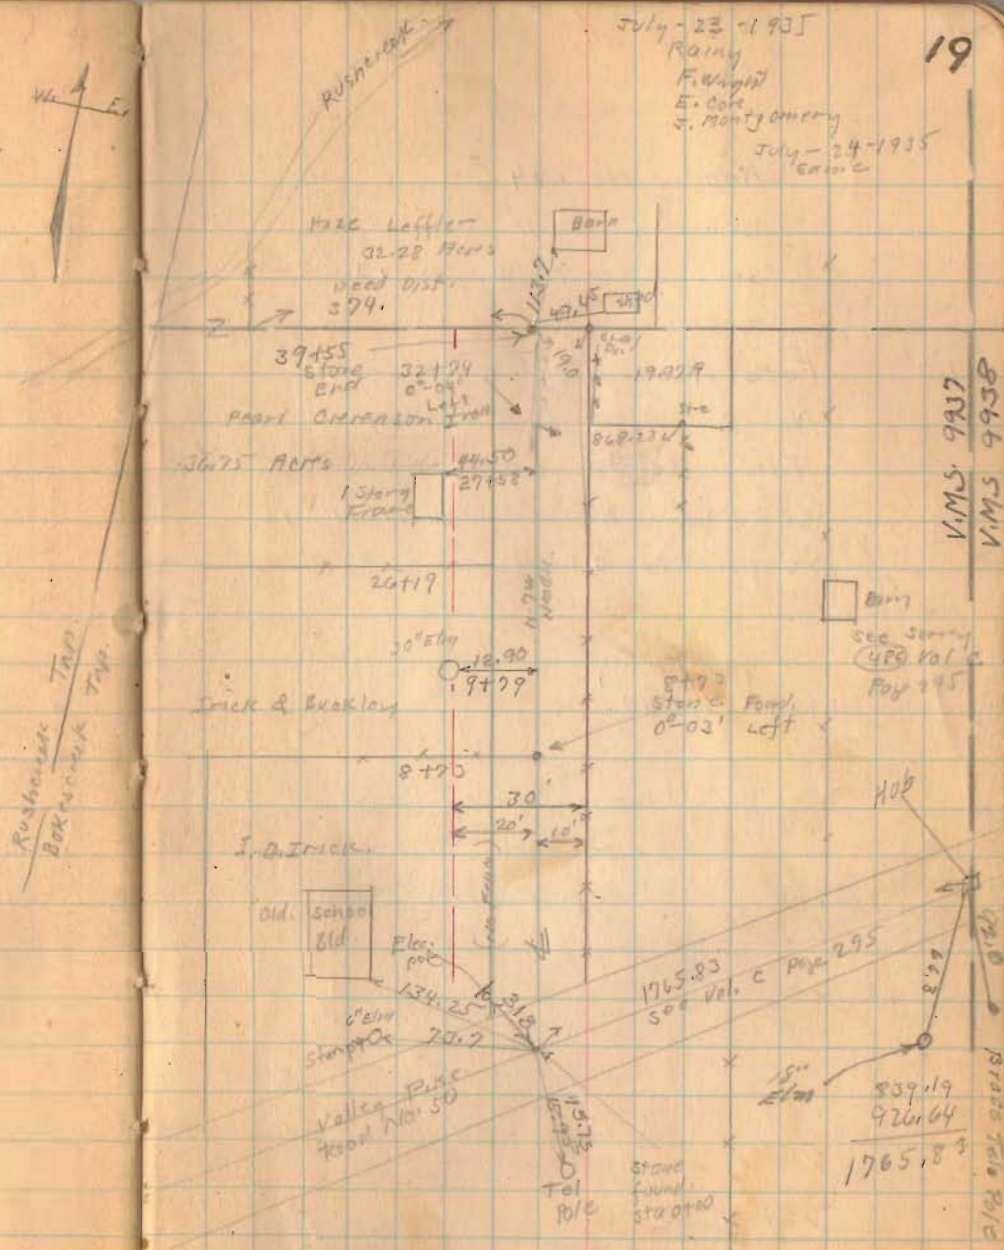

July - 23 - 1935
 Rainy
 F. Wright
 E. Cole
 J. Montgomery
 July - 24 - 1935
 Rainy

19

V.M.S. 9937
 V.M.S. 9938

Barn
 See survey
 488 Vol C
 Page 295