


FB 701

C.H. 12

Begins in Rushcreek Twp.
ends in Batescreek Twp.

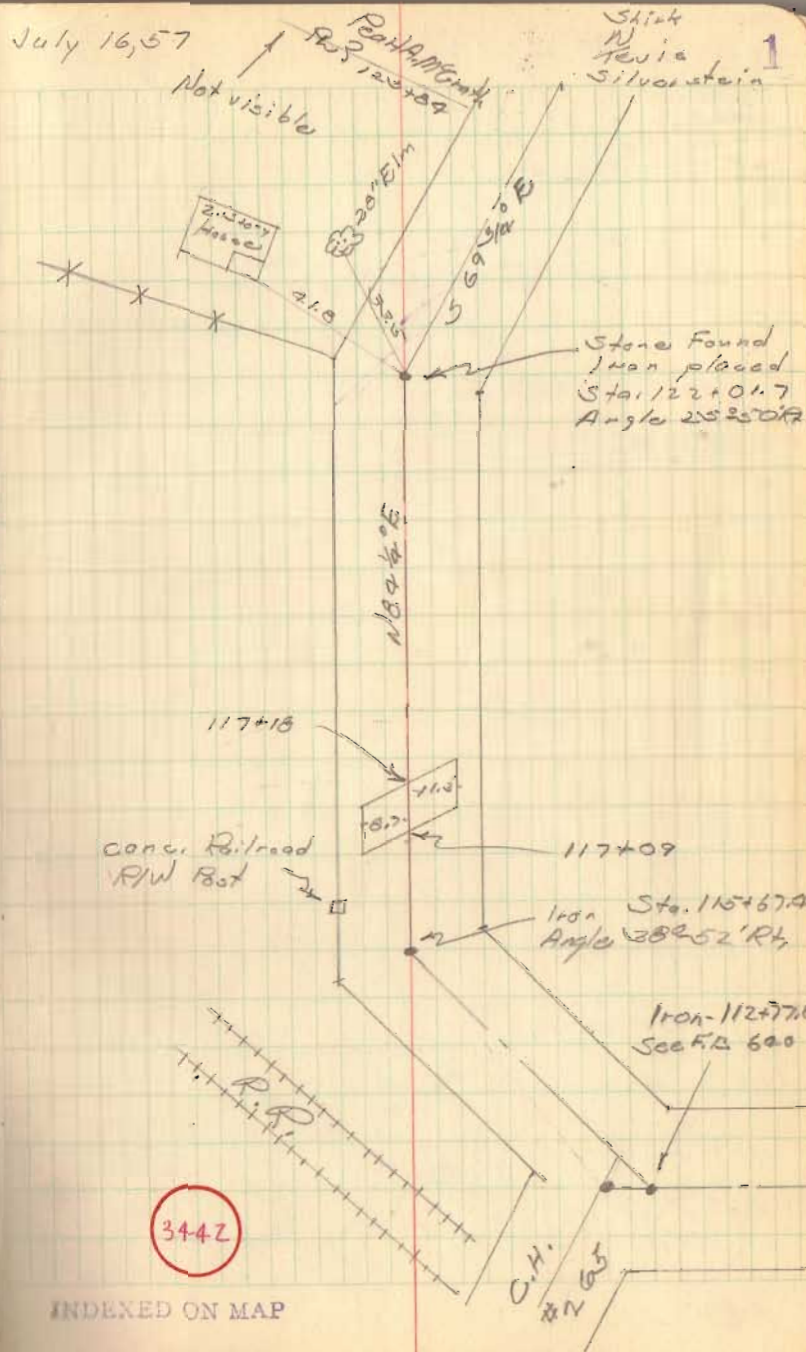

Iron Set
Sta. 102+31.2
No Angle

Iron found


Gilbert Kinney

142+31.2

"Double" Arch


10" Arch
Garrett Boring

Gilbert Kinney
142+31.2
Paul A. McGrath

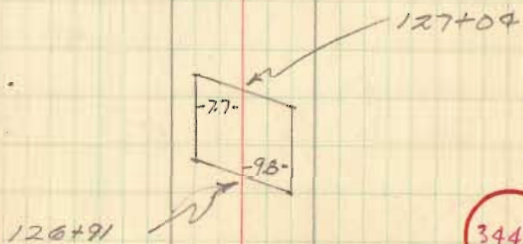


344Z

FB 701 C.H. 12

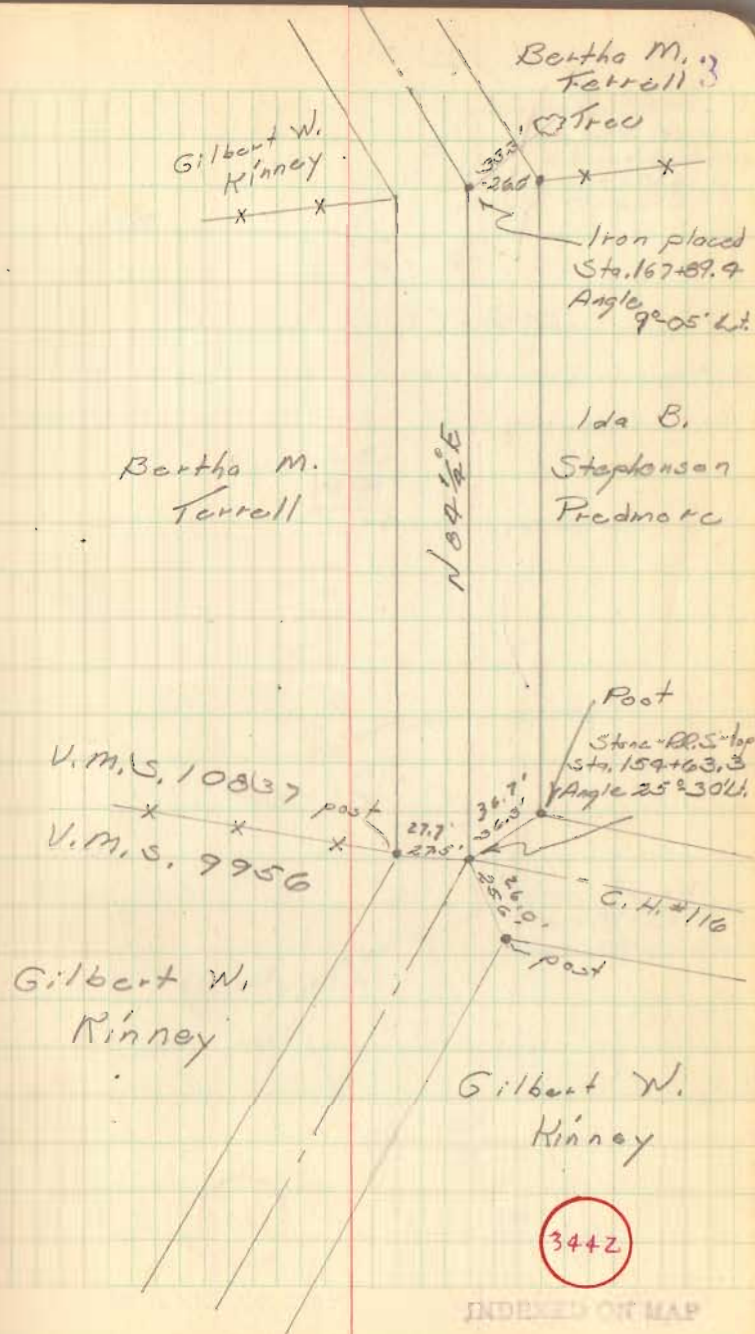

FB 701 C.H. 12

C.H. 115

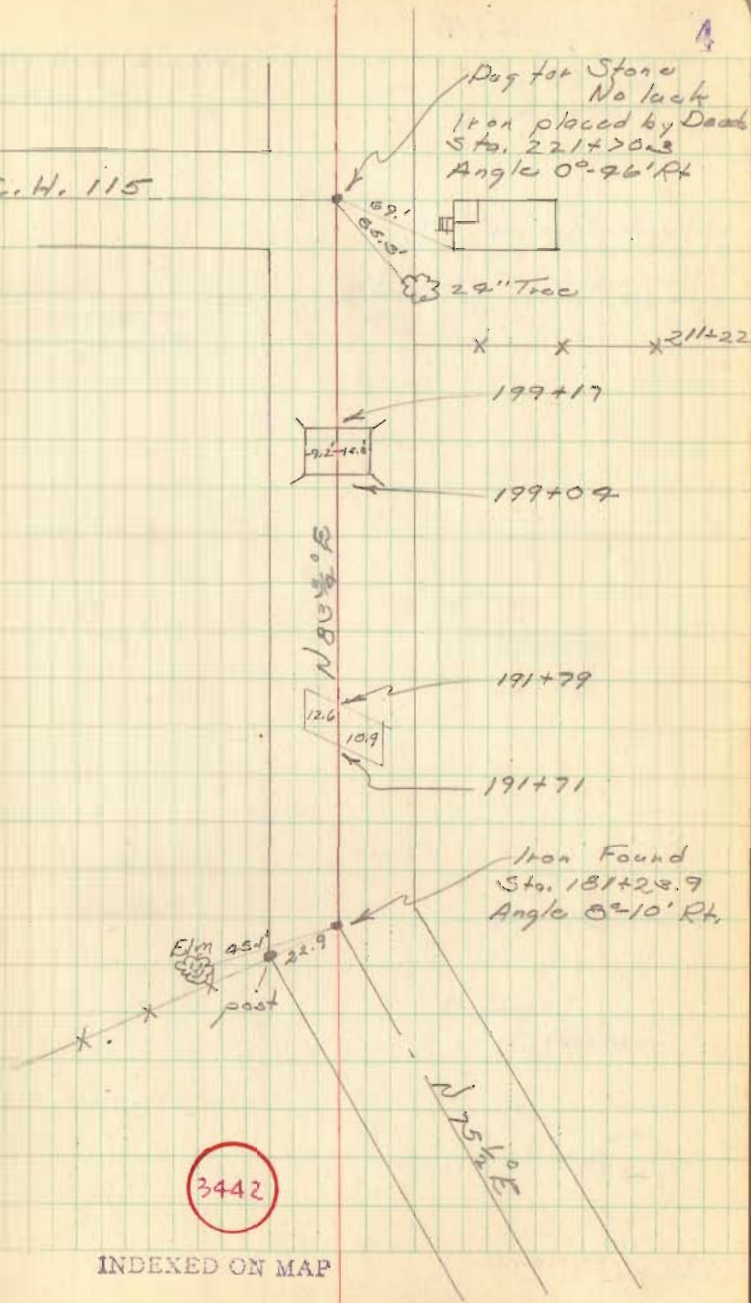

INDEXED ON MAP

Abbie Romire
248+01.8 — x x

← Iron found
No Angle

Herbert
Crankleton
21.73

Iron - No Angle
found 12" pin on June 27
C.N.
24.55 cor. post, capped nail
27.2+37
21.77 18" Walnut

240+15.7 — x x

N 09 1/4 E

Moud
Ramsey
22.78

Herbert
Crankleton
21.35

x x 230+09

Herbert
Crankleton

3442

FB 701

C.H. 12

6



V.M.S. 16070
 V.M.S. 14530

-265+76

Maud
 Ramsey
 25.00

V.M.S. 14530
 V.M.S. 13593

Maud
 Ramsey
 25.32

3942