

April 2, 1970

The following described real estate situated in the Township of Bokescreek, County of Logan, State of Ohio and being a part of Virginia Military Survey No. 9914 and being more particularly described as follows:

Beginning at a R. R. Spike in the centerline of C. H. No. 48 and in the north line of said V.M.S. No. 9914 and also being the northeast corner of Earl O. Jacob's present 40.00 Acre tract and the northwest corner of Isabell Butcher's present 86.43 Acre tract;

Thence with the line between Jacob's and Butcher, S. 4° 33' E. 258.5 feet to an iron bar, passing through a wood corner post at 30.00 feet;

Thence S. 85° 30' W. 312.9 feet to an iron bar;

Thence N. 4° 30' W. 258.3 feet to a R. R. Spike in the centerline of C. H. No. 48 and said V.M.S. line, passing through an iron bar at 238.3 feet;

Thence with the centerline of C. H. No. 48 and V.M.S. line, N. 85° 30' E. 312.2 feet to the place of beginning, containing 1.85 Acres, more or less.

The above described parcel being surveyed out of the northeast corner of Earl O. Jacob's present 40.00 Acre tract as recorded in Deed Vol. 329 Page 304, Logan County Deed Records.

I hereby certify that this is a true and accurate description of a survey made by me on March 28, 1970.


Daniel E. Gilbert
Daniel E. Gilbert, P.S.
Reg. Sur. No. 5402
428 N. Madriver St.
Bellefontaine, Ohio 43311



1D

4636

INDEXED ON MAP

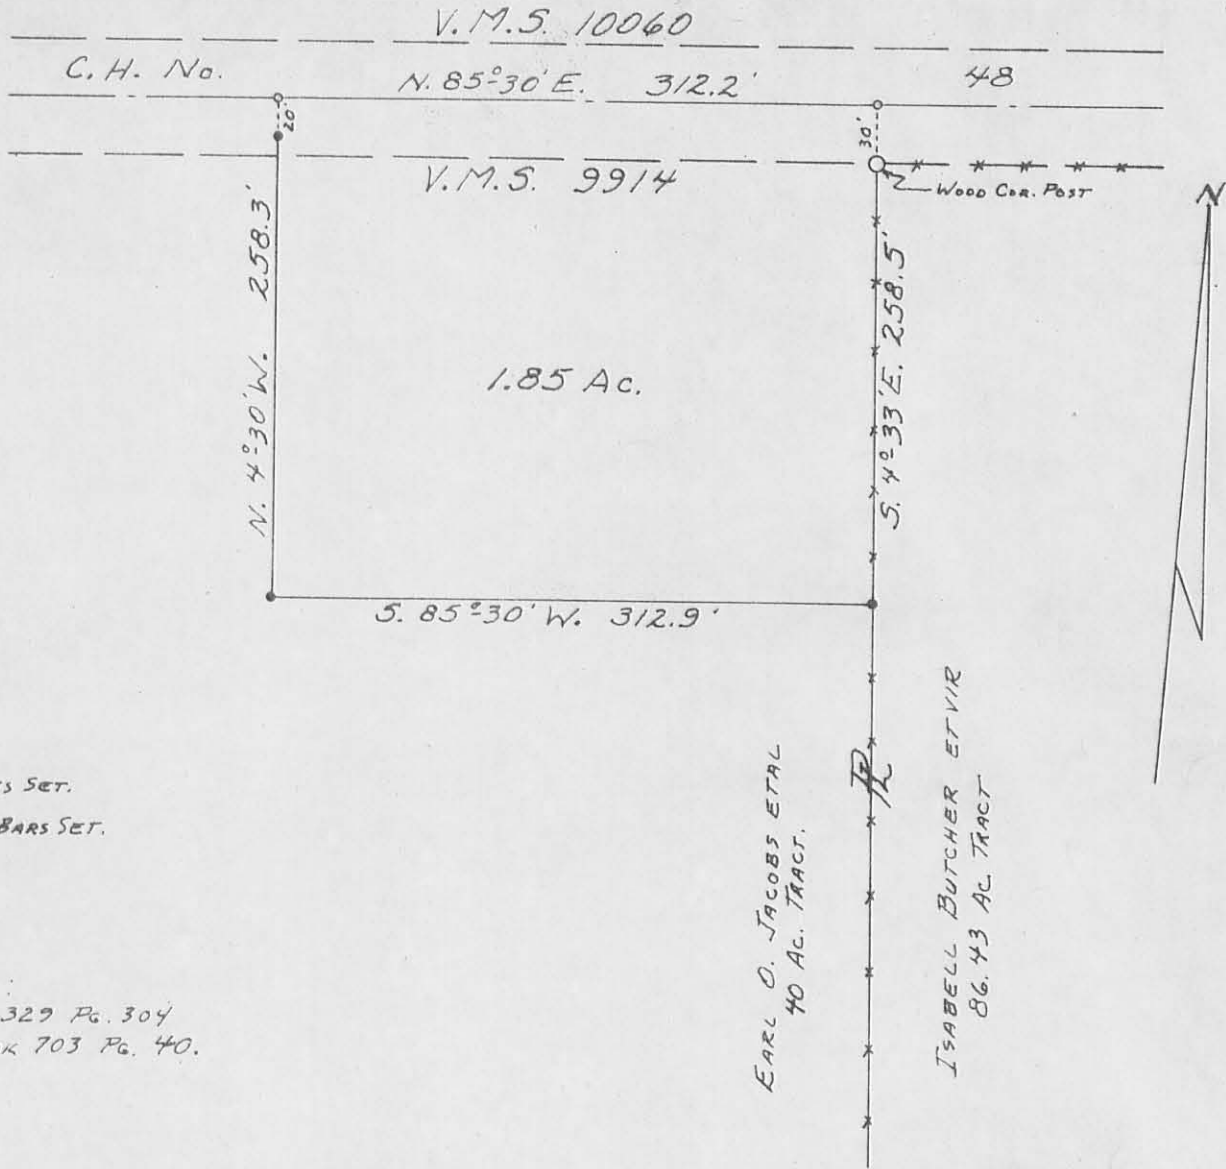

- - R.R. SPIKES SET.
- - $\frac{5}{8}$ " ϕ IRON BARS SET.

REFERENCES:
 DEED Vol. 329 Pg. 304
 FIELD BOOK 703 Pg. 40.

SURVEYED AND PLATED BY:
 DANIEL E. GILBERT, P.S.
 REG. SUR. No. 5402
 428 N. MADRIVER ST.
 BELLEFONTAINE, OHIO 43311



JACOBS SURVEY
 V.M.S. No. 9914
 BOKESCREEK TOWNSHIP
 LOGAN COUNTY, OHIO
 MARCH 28, 1970

SCALE: 1" = 100'

IP
 4636

INDEXED ON MAP