

FB 708

C.H. No. 125  
BOKESCREEK TWP

JTA.

23+64.4 Stone Found 12" deep  
ANGLE 1° 07.2' Lt

23+47.9 1/2"  $\phi$  Bar Found Bent - Replaced  
w/ 3/4"  $\phi$  Bar - No Angle

8+39.6 1/2"  $\phi$  Bar Found - No Angle

6685

INDEXED ON MAP

0+00 1/2"  $\phi$  Bar Found 8" Deep  
3'  $\pm$  S. of E. of pavement

Dodson - Nichols  
Clugerman - Wosyk

July 5, 1977  
90° 4'

V.M.S. 6154

Survey Line

23+64.4

V.M.S. 775-6155

23+30.9 R2


23+47.9 R2

15023.4

GAIL R.  
PETERSON

8+39.6 R2

J. Carroll Potts

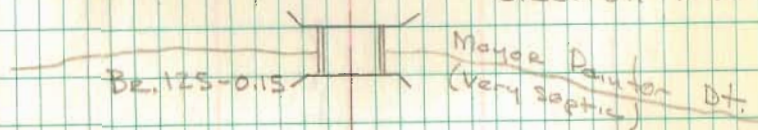

S.R. 47

0+00

C.H. No. 125

FB 708

48+66.6 P-K Nail Found - Set 1" Bar  
0.32W. of nail  
ANGLE 1°43.0' Rt.

41+98.7 Nail Found - Set 3/4" Bar  
No ANGLE  
Dug 4'x5'x4' deep hole found  
nail only.

23+64.4

Dodson - Nichols  
Chugerman - Wasylk

July 6, 1977  
15° 43'

N. 150.59' E

R No Fence  
48+66.6

Ronald C.  
Elliott

R No Fence

41+98.7

Velma M  
Eastman

N. 140.16' E

V.M.S. 6154

Survey Line

23+64.4

V.M.S. 775-6155



C.H. No. 125

FB 708

50+69.2 1" Pipe Set on County Line  
No Angle

48+66.6

July 6, 1977  
95° 40'

