



DC Graff Water Works site

- A - Iron at angle in Corporation Line  
see Road 14 Book 582 Page 10  
see Recorders Vol. A Page 92
- B - Point  $\pm$  Road
- C - Axel Placed Level with surface
- D - Axel Placed 10" Below Ground level
- E - Axel Placed 10" Below surface
- F - Axel Placed 10" Below surface
- G - Axel Placed Level with surface

Complete R/W  
posts Sta. 12+0  
see Book 582  
pg 10  
see plan X-2

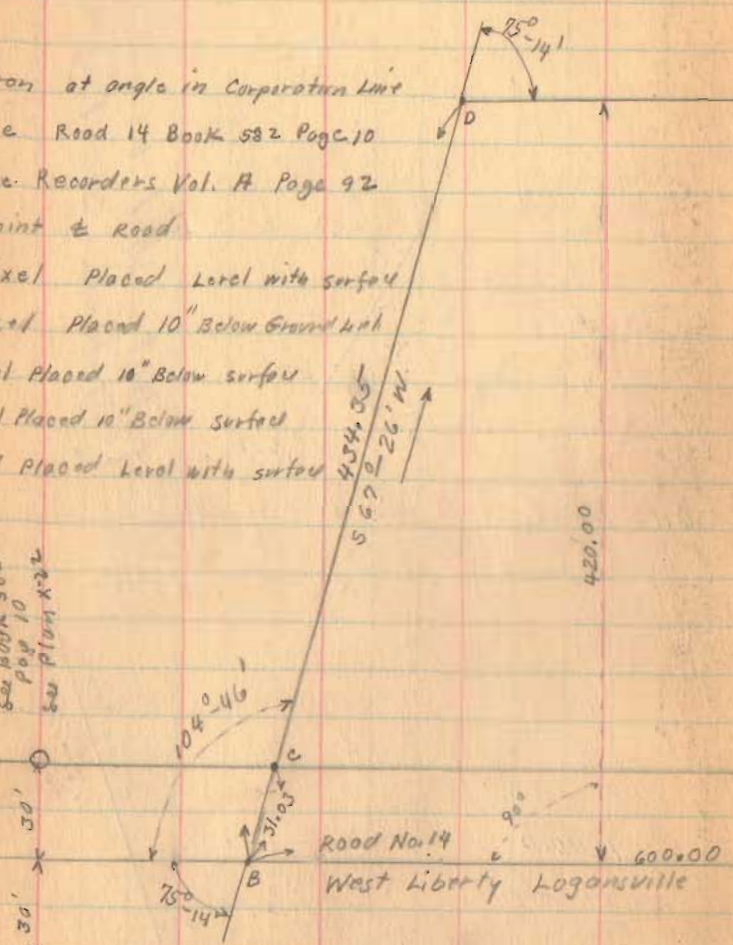


DCC, 5-1936  
cold  
F. Wright  
G. Wilgus  
G. Pisony

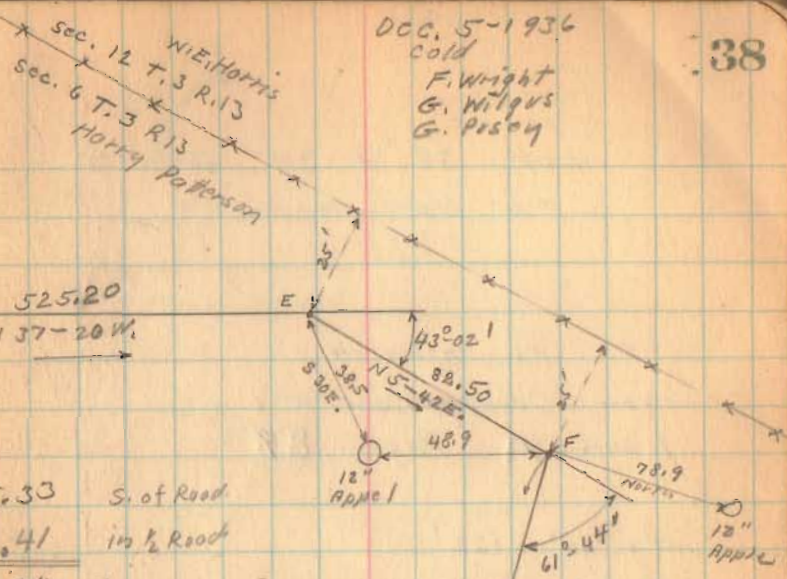

5.33 S. of Road  
.41 in 1/2 Road  
5.74 Acres Total

Complete R/W Posts Sta. 5+40  
see Book 582 Page 10  
see Plan X-22

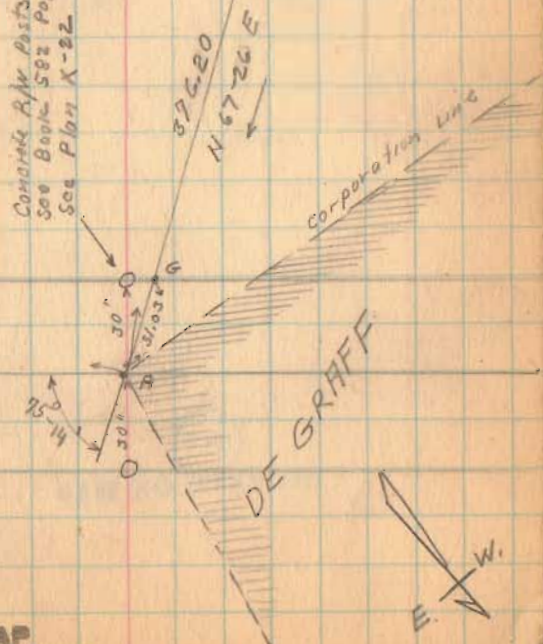

1765

INDEXED ON MAP

