

PART LOT 112
DeGraff, Ohio
surveyed for

WILBUR BRUNSON

The following described real estate situated in the
Village of DeGraff, Miami Township, Logan County, Ohio.

Being part of Lot 112 as the same is shown on desig-
nated on the recorded plat of said village and being more par-
ticularly described as follows:

Beginning at an iron pin at the Northwest corner of
said Lot 112; thence with the North line of said lot and the
South line of Miami Street S. $87^{\circ}-11'$ E. 45.0 feet to an iron
pipe; thence S. $2^{\circ}-46'$ W. 99.45 feet to an iron pipe; thence
N. $86^{\circ}-40'$ W. 66.55 feet to a chisel mark on a concrete wall,
at the East line of Mill Street; thence with the East line of
said Mill Street and the West line of said Lot 112 N. $15^{\circ}-$
 $04'$ E. 101.07 feet to the place of beginning.

2017

ID-1

INDEXED ON MAP

PART LOT 112
DeGraff, Ohio
surveyed for

WILBUR BRUNSON

The following described real estate situated in the Village of DeGraff, Miami Township, Logan County, Ohio.

Being part of Lot 112 as the same is shown and designated on the recorded plat of said Village and being more particularly described as follows:

Commencing at an iron pin at the Northwest corner of said Lot 112; thence with the North line of said lot and the South line of Miami Street S. 87°-14' E. 45.0 feet to the place of beginning of this description; thence continuing S. 87°-14' E. 56.7 feet to an iron pipe in the center of a private drive; thence with the center of said drive S. 8°-47' W. 100.45 feet to an iron pipe; thence N. 86°-40' W. 46.2 feet to an iron pipe; thence N. 2°-46' E. 99.45 feet to the place of beginning.

2077
1D-2

INDEXED ON MAP

Lot # 112
DeGraff Ohio

Survey of Northwest
corner of Lot # 112 (part "D" on
village map) for —
Wilbur Brunson
DeGraff, Ohio


See Co. Eng. FB # 667 pg 45

INDEXED ON MAP
2077


D. Dodson
V. Detrick

Mar. 28, 1953
Cool

19

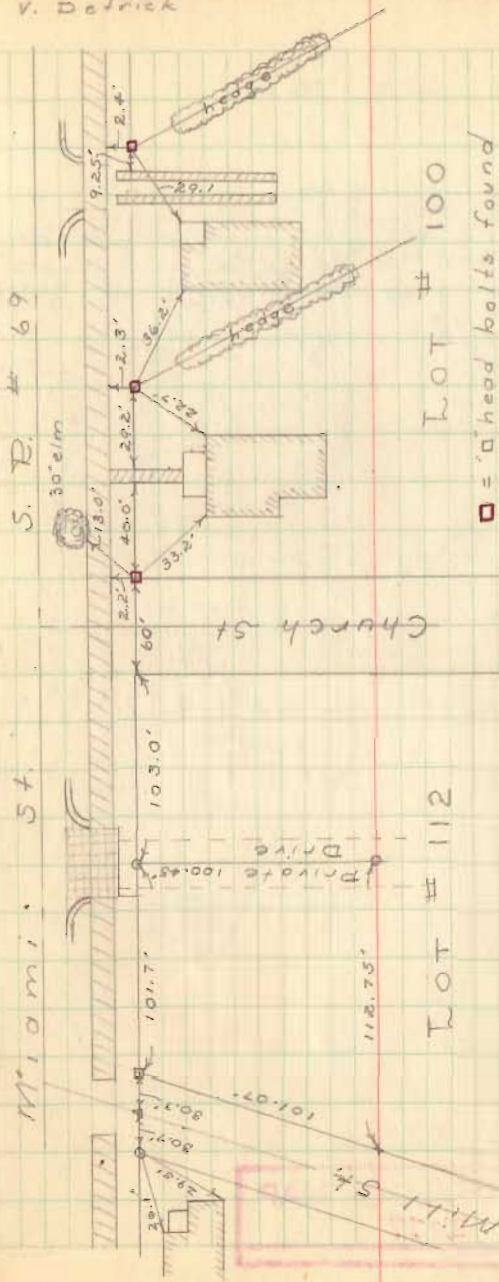

Lot # 112 (cont'd)

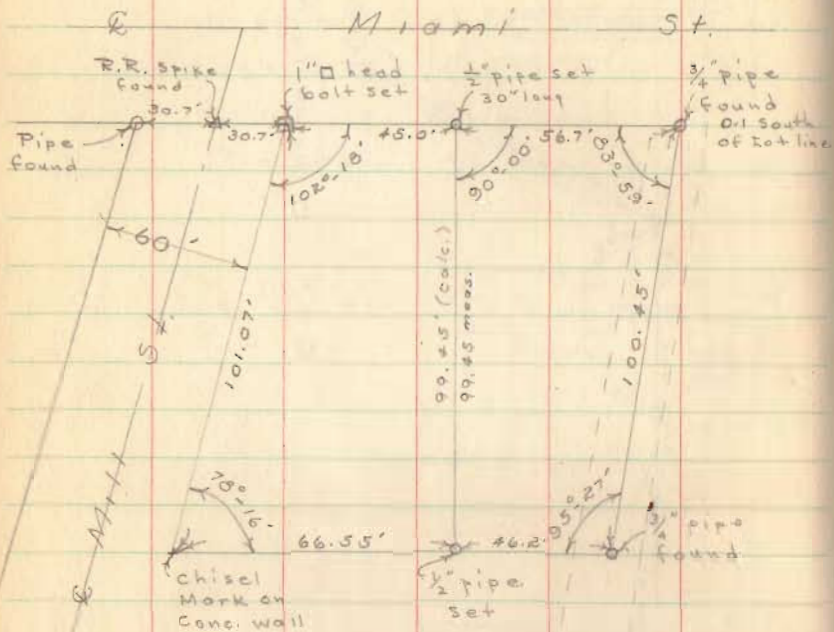

INDEXED ON MAP
2077

Mar. 28, 1893

20
11

