

Allison Survey De Graff Miami Twp. Dec. 1948 0.55 acre


The following described land in the Village of De Graff in Miami Township Logan County Ohio and being in Section 12 Town 3 Range 13.

Beginning at an iron pipe in the center of County road Number 256
(Also known as Mill Street) at the Southerly corner of E.B.Allison's
3.13 acre tract and said iron also being station 16 plus 78.4 as shown
in Logan County engineer's Book 490 Page 76 thence with the east side
of said 3.13 acre tract and also being with the center line of the
abandoned Rail Road grade N. 32° - 11' E. 285.5 feet to an iron pipe
thence S. 18° - 42' E. 174.6 feet to a two inch by two inch stake thence
S. 59° - 14' W. 234.0 feet to an iron in the center of County Road
Number 256 thence with the center of County Road Number 256 N. 9° - 30' W.
44.1 feet to the place of beginning said tract containing 0.55 of one
acre.

3129 1D

INDEXED ON MAP

Eartha Allison
DeGraff, O.

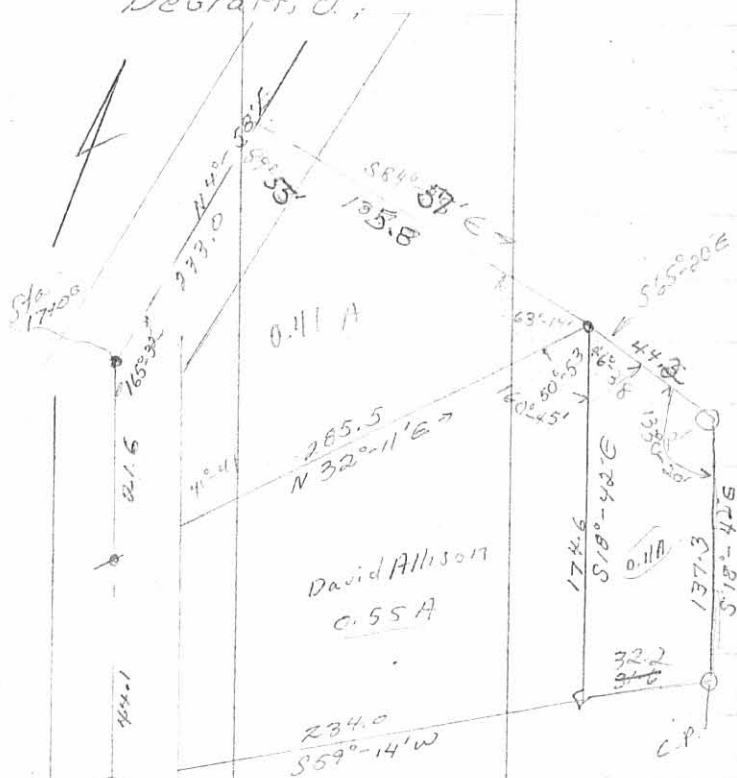

David Allison
C. 55 A


(2743 / 3123) IP
INDEXED ON MAP

Mill St
C.H. 256

Midway

See Co. Engr. F.B. 490, pg 76

Miami Twp
Sec. 12, T-3, R-13
Between Miami R Survey

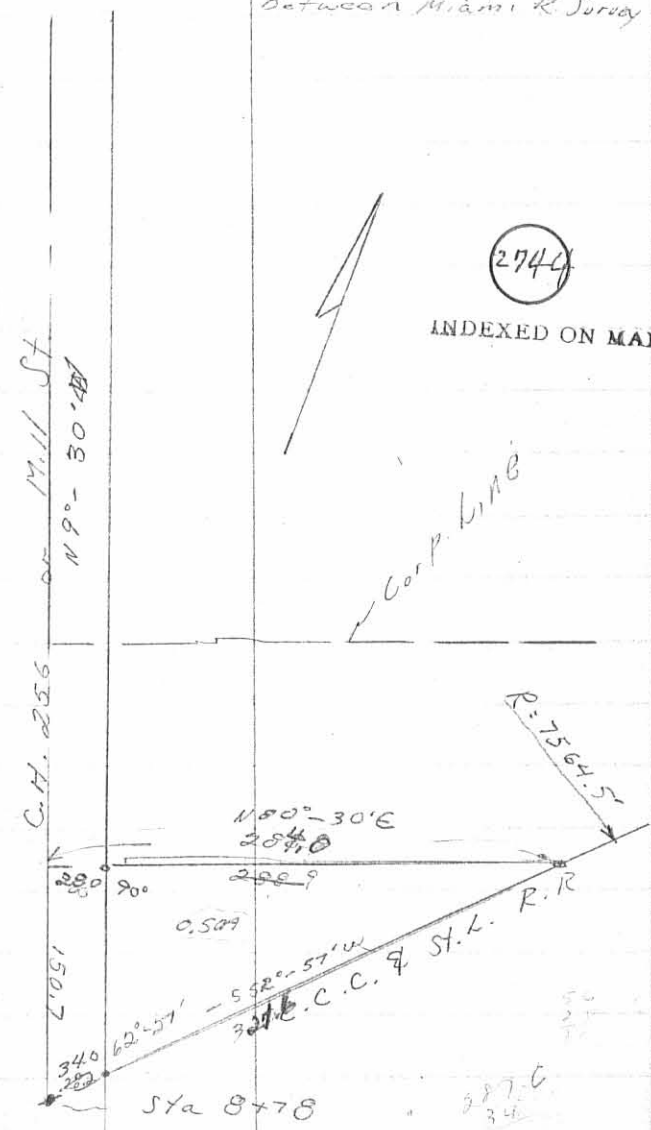

(2744)
INDEXED ON MAP

Corp. Line

Sta 8+78

277.6
34