

Stearns and Meier Description
Lot No. 102 part

The following described real estate situated in the Village of De Graff, Township of Miami, County of Logan, State of Ohio and being a part of Lot No. 102 of Bogg's Addition to said Village, and being more particularly described as follows:

Beginning at an iron bar at the southwest corner to Lot No. 102, said iron bar also being the southeast corner to Lot No. 103 of said Bogg's Addition, and also being in the north line of Race Street;

Thence with the north line of Race Street, S. 86° 12' E. 84.00 feet to an iron bar;

Thence N. 3° 02' E. 189.40 feet to an iron bar;

Thence N. 86° 19' W. 83.40 feet to an iron bar in the east line of Lot No. 103 and the west line of Lot No. 102, said iron bar being S. 3° 17' W. 2.40 feet from an iron bar at the intersection of the corners to Lot No. 101, 102 and 103;


Thence with the line between Lot No. 102 and 103, S. 3° 17' W. 189.00 feet to the place of beginning, passing through an iron bar at 68.00 feet, containing 0.364 Acres, more or less.

The above described parcel being on the west side of Lot No. 102.

I hereby certify that this is a true and accurate description of a survey made by me on October 3, 1973.

Daniel E. Gilbert
Daniel E. Gilbert, P.S.
Reg. Sur. No. 5402
1041 N. Main St.
Bellefontaine, Ohio 43311

INDEXED ON MAP
5352 ID

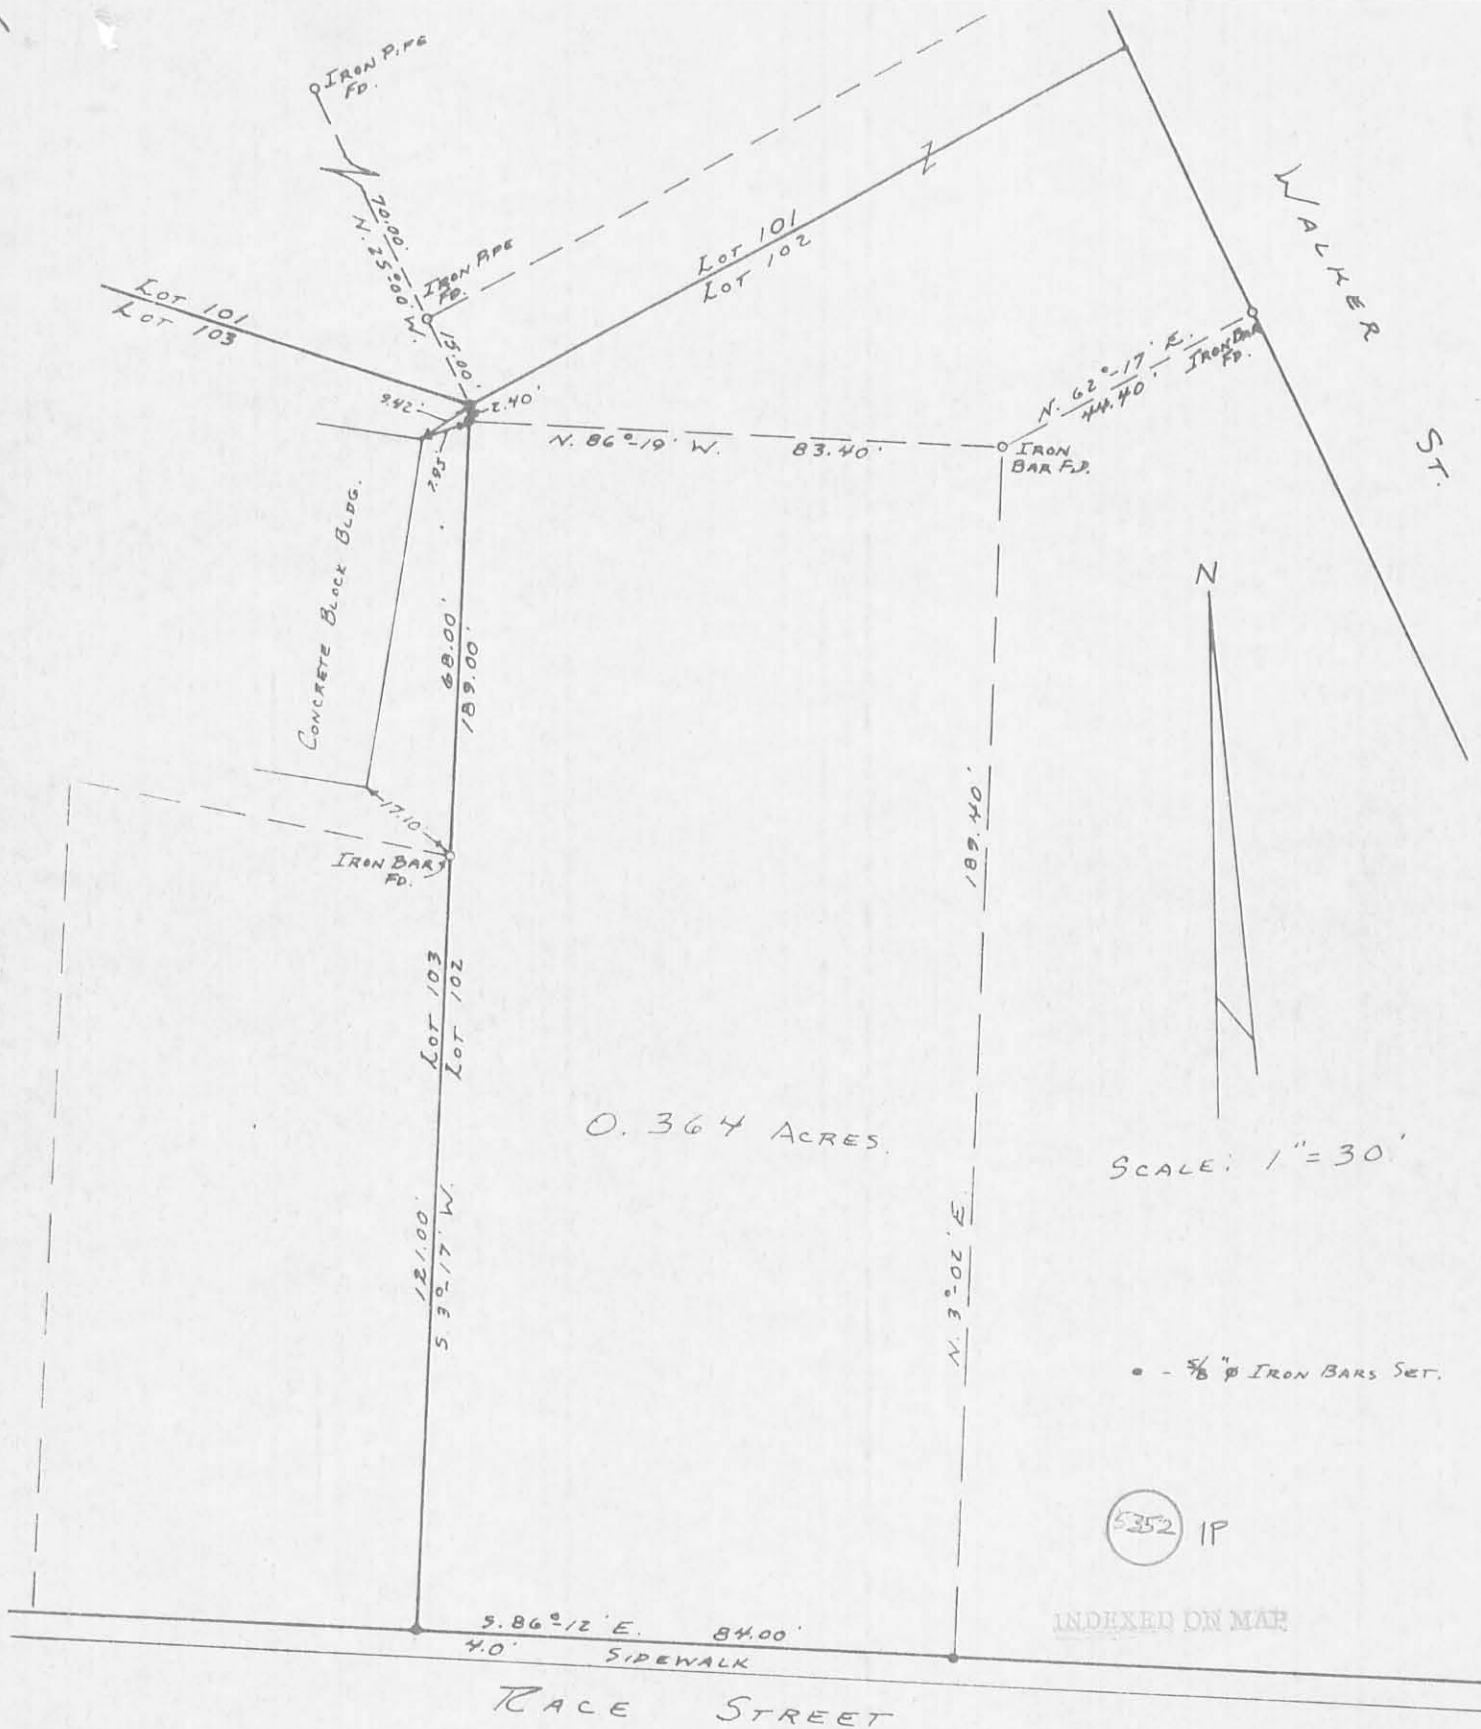

SURVEYED AND PLATTED BY:
 DANIEL E. GILBERT, P.S.
 REG. SUR. No. 5402
 1041 N. MAIN ST.
 BELLEFONTAINE, OHIO 43311

SURVEY OF PART OF LOT 102
 BOGG'S ADDITION
 VILLAGE OF DE GRAFF
 MIAMI TOWNSHIP
 LOGAN COUNTY, OHIO
 OCTOBER 3, 1973