

Copied from R.R. Map  
 Bellefontaine City  
 Engineer's file HH-13  
 Oct. 14, 1949



BOGGS

DEGRAFF  
 LOGAN COUNTY OHIO  
 1" = 50'

5851 1P

INDEXED-ON MAP

MAIN

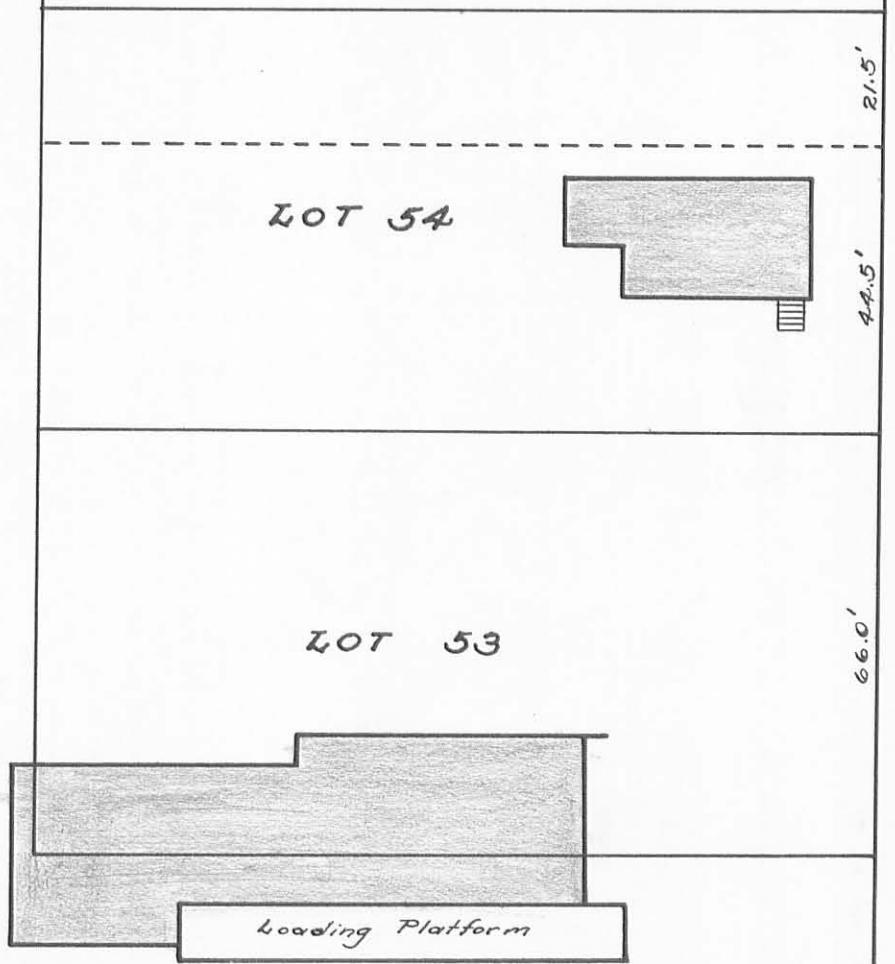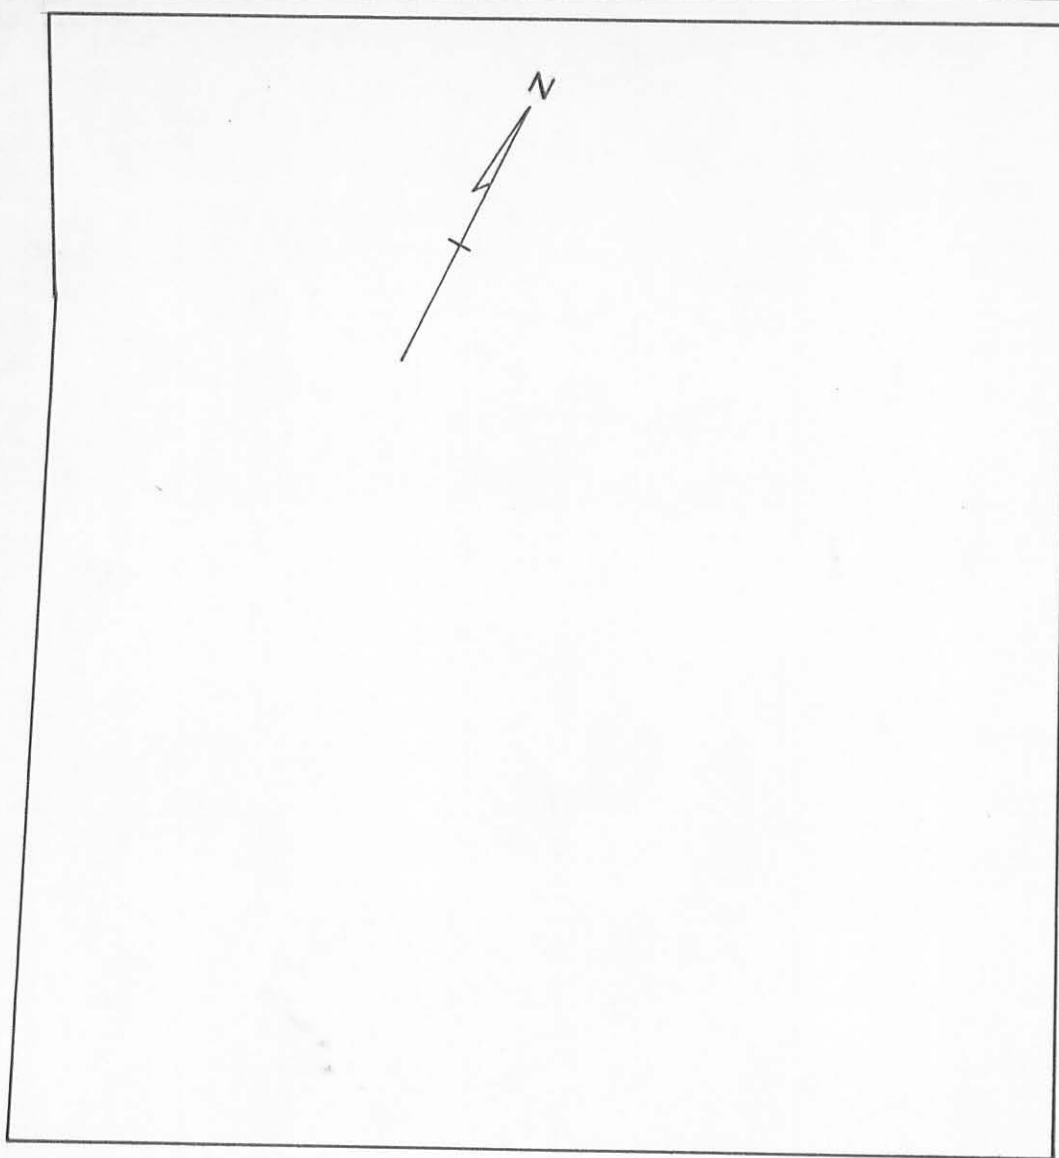

C.C.C. + St. L. Ry. Co.

Scale: 1"=30'

INDEXED ON MAP  
5851 2P


PLAT SHOWING LOCATION  
OF BUILDINGS ON  
LOTS 53 + 54 in DEGRAFF, OHIO  
1948

PART LOT 26  
DEGRAFF, OHIO  
September 13, 1969

The following described real estate situated in the Village of DeGraff, Miami Township, Logan County, Ohio and being part of Lot No. 26 of the original town as shown in Logan County Recorders Plat Book A, Volume 2, page 83 and being more particularly described as follows:

Beginning at an iron bar in the west line of Main Street at the northeast corner of said lot 26; thence with the west line of Main Street S.28° 45'E. 30.25 feet to an iron bar; thence S.63° 14'W. 132.06 feet to an iron bar in the west line of said lot 26; thence with said west line N.28° 45'W. 27.30 feet to an iron bar at h northwest corner of said lot 26; thence with lot N.61° 55'E. 132.00 feet to the place of beginning.

INDEXED ON MAP  
5851 3D

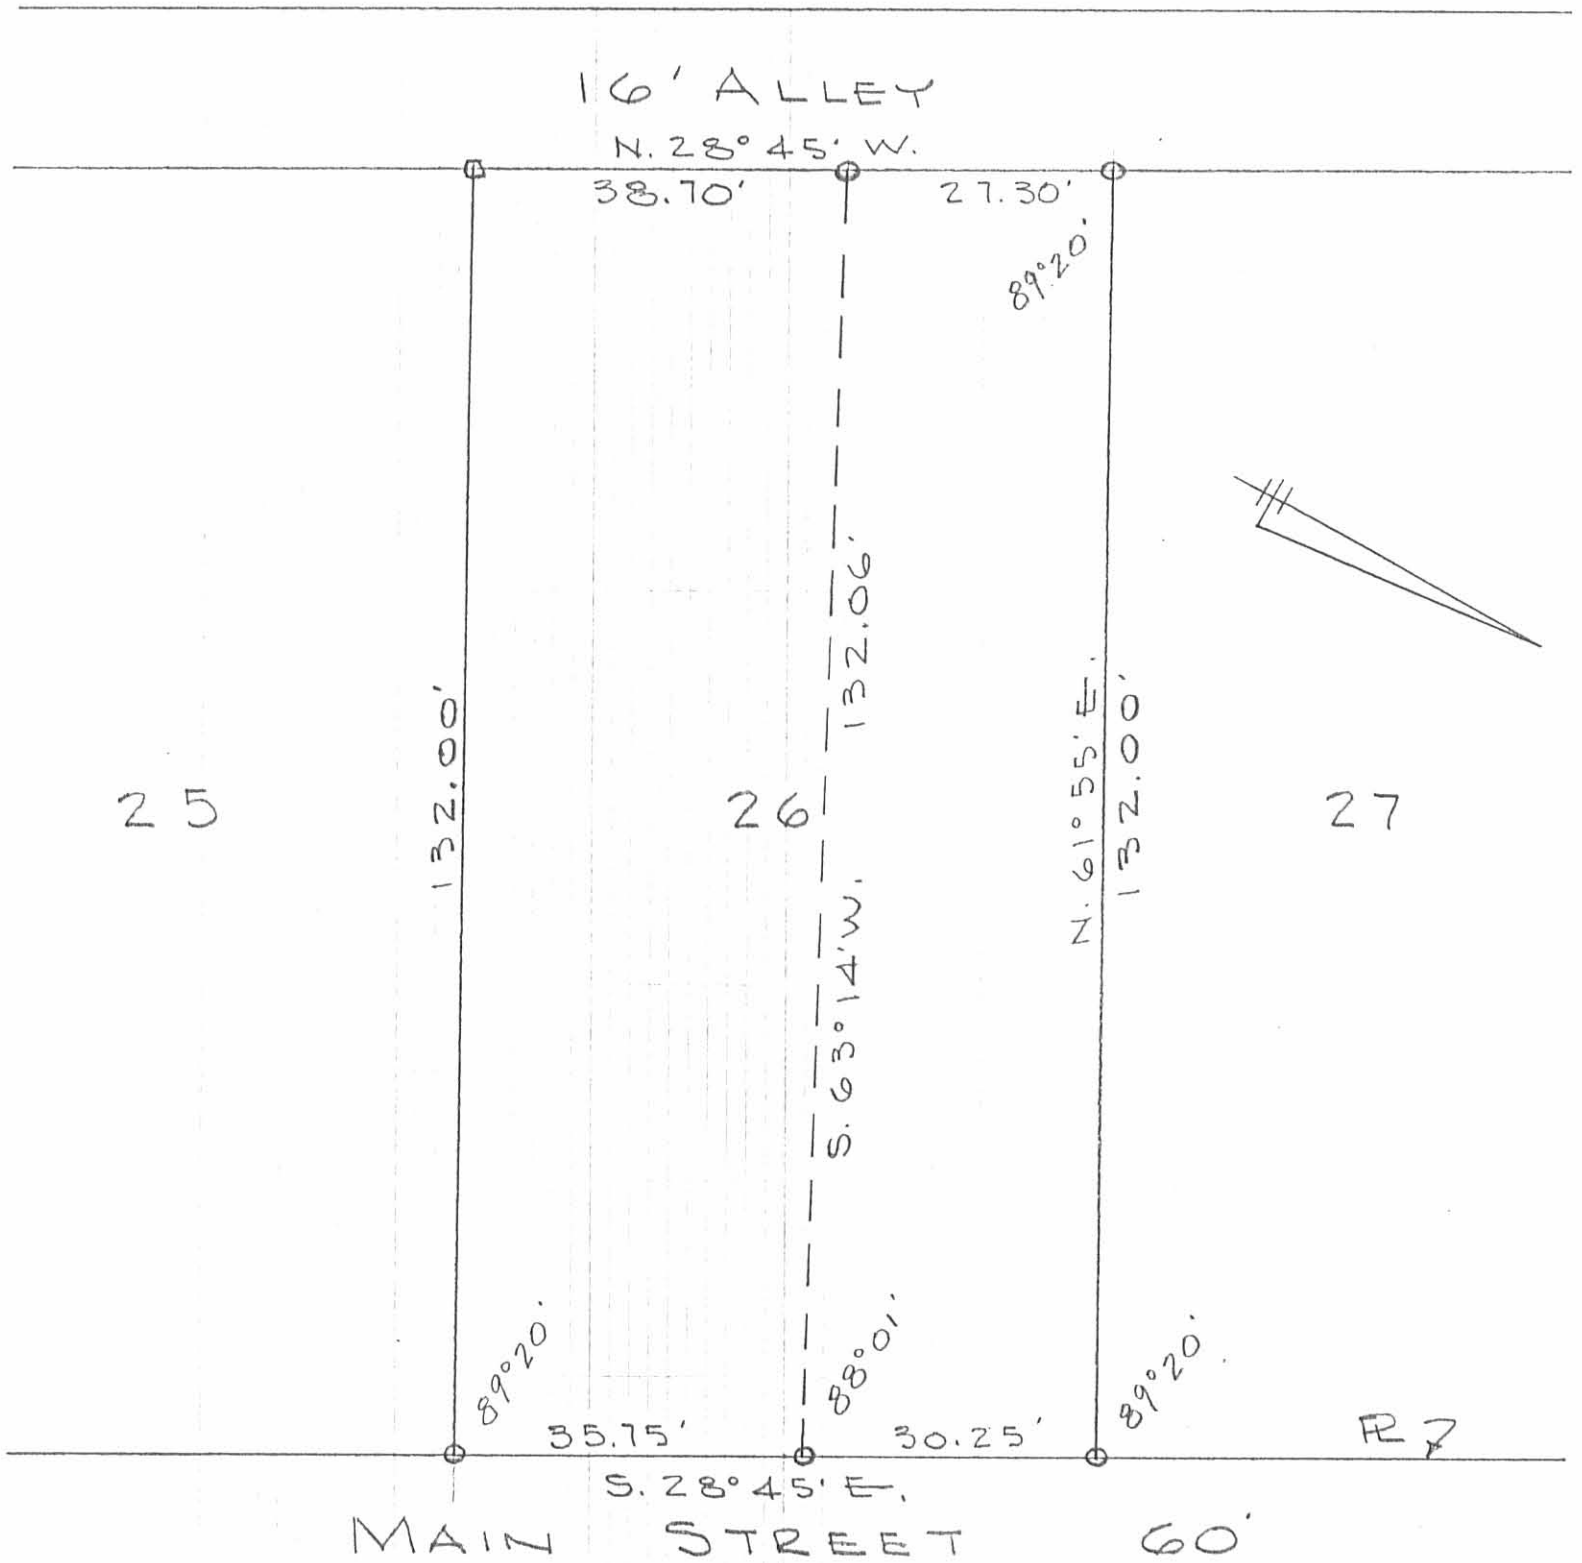


SURVEY OF LOT 26  
 DEGRAFF, OHIO  
 SEPT. 13, 1969  
 SCALE 1" = 20'  
 0 = 5/8"  $\phi$  BAR SET

INDEXED ON MAP  
 5851 3P

DAN L. DODDSON  
 REG SURVEYOR 4270  
 BELLEFONTAINE, O.



lots 53-54-55-56 pt  
DeGoff, Ohio

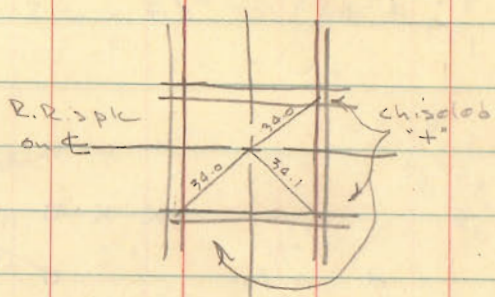

8 lots @ 66' = 528.0

1 Alley @ 16 = 16.0

1/2 Street @ 60 = 30.0

574.0 Plat



meds

573.75

- 0.25

66  
4  
264

INDEXED ON MAP  
5851

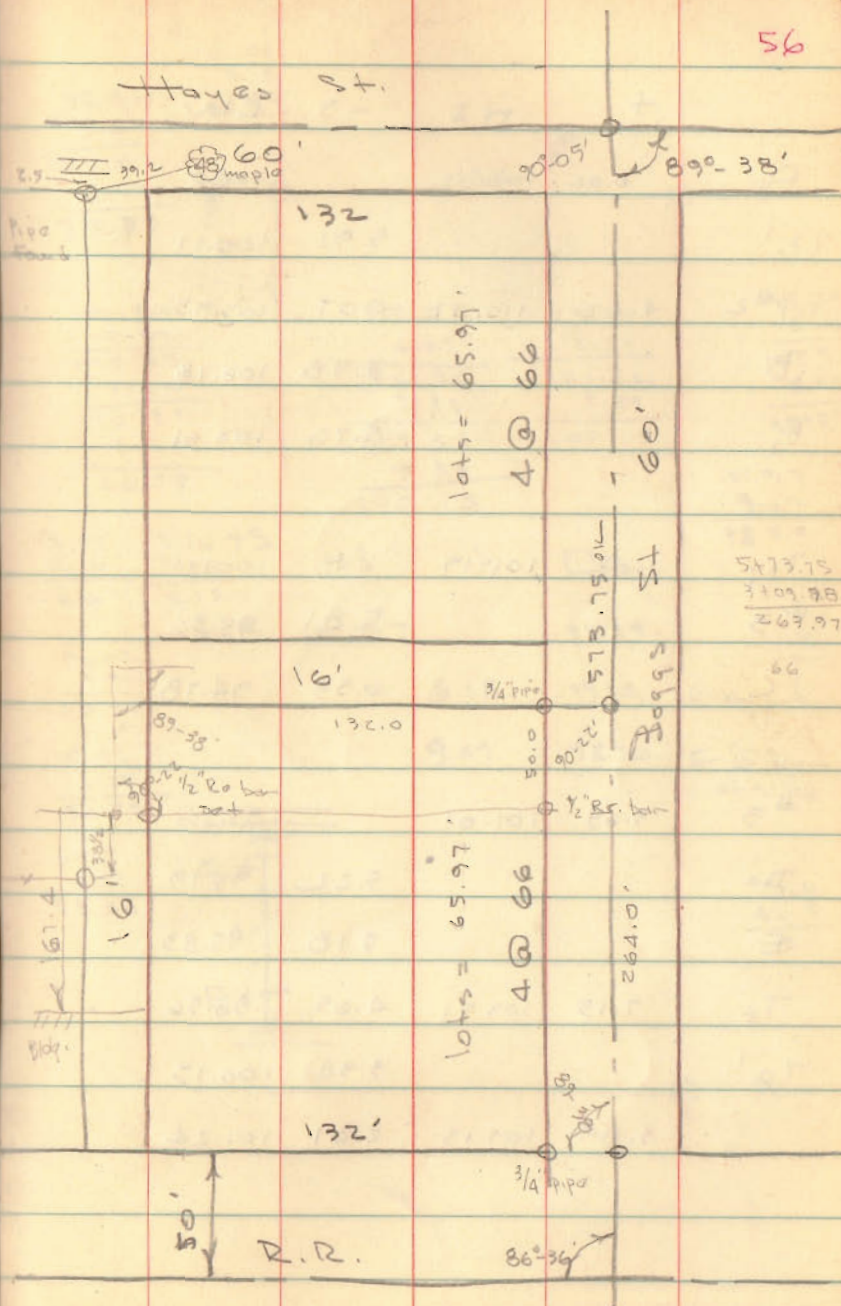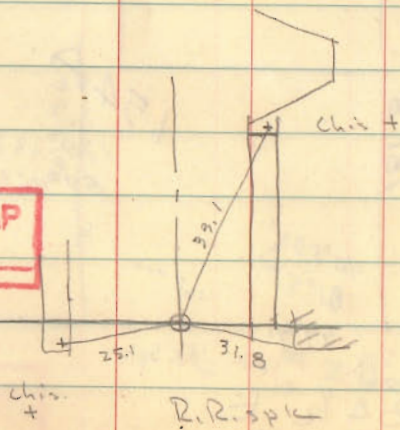

573.75  
3109.88  
263.97

lots = 65.97

4 @ 66

lots = 65.97

4 @ 66

LOT 26  
DEGRAFF OHIO

- A = 3/4" pipe Found  
 B = " " "  
 C = 5/8"  $\phi$  Bar Jet  
 D = " " " 0.7' E. of Stonewall  
 E = " " "  
 F = " " "  
 G = " " "  
 H = " " "  
 I = 3/4" Pipe Found  
 K = " " "


Points A-B-I-K shown to me by owner  
 lot surveyed several years ago  
 used these point to stake lot 26

All points fit occupation very good  
 but they don't check anything else.

Survey to split lot 26 as shown.

Dodson  
Nichols

9/13/69 47

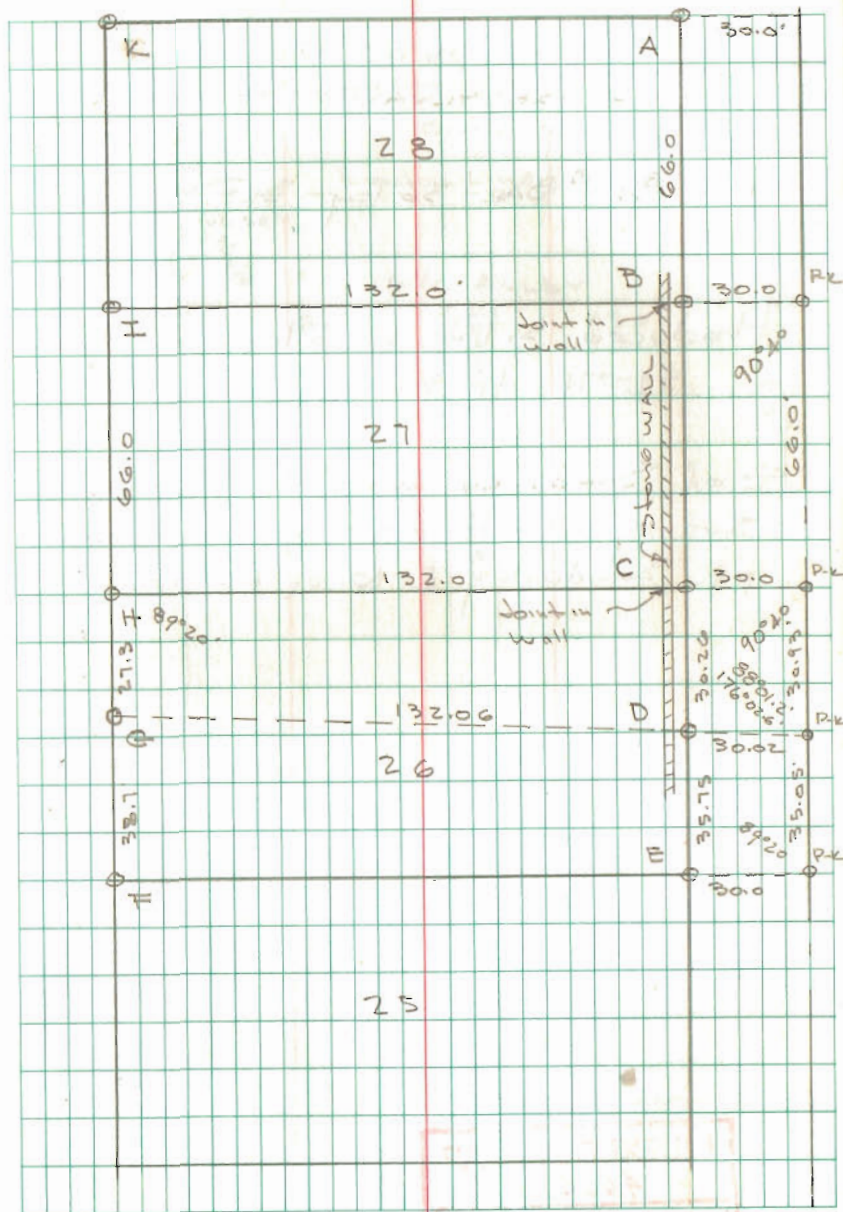

INDEXED ON MAP  
5851