

Corporation

Norman E. Quay et ux
Vol. 334 P. 118 (3-5-1971)
26-117-15-01-015.000

Lot 261

S. Main St.



132.00'
N. 70°-33'-00" E.

Dianna L. Dressback
O. R. No. 117 P. 741 (11-21-1990)
26-117-15-01-016.000

Lot 262

S. 18°-27'-00" E.
120.00'

S.R. No. 508

Clifford Baughman et ux
Vol. 395 P. 999 (5-10-1982)
25-117-00-00-022.001
25.00 Acres

120.00'

1/2" Iron Pipe Fd.

132.00'

S. 70°-33'-00" W.

Basis of Bearing
151.90'

5/8" Iron Bar Fd.

Dianna Dressback
Vol. 397 P. 602 (9-27-1982)
26-117-15-01-017.000

Lot 263

N. 18°-27'-00" W.
102.25'

Line

Reference:
Smith Allotment.
Plat Cab. A, Slide 365.

● - 5/8" x 30" Rebars Set.

1" Iron Pipe Fd.

135.16'

N. 82°-58'-00" E.

1" Iron Pipe Fd.

Lot 264


INDEXED ON MAP
6871 1P

Daniel E. Gilbert




Daniel E. Gilbert, P.S.
Reg. Sur. No. 5402
400 N. Park St.
Bellevue, Ohio 43311

Dressback Survey
Lot No. 262
Village of DeGraff
Miami Township
Logan County, Ohio
December 6, 1990

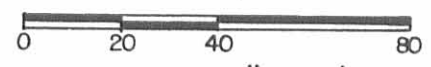

Scale: 1" = 40'

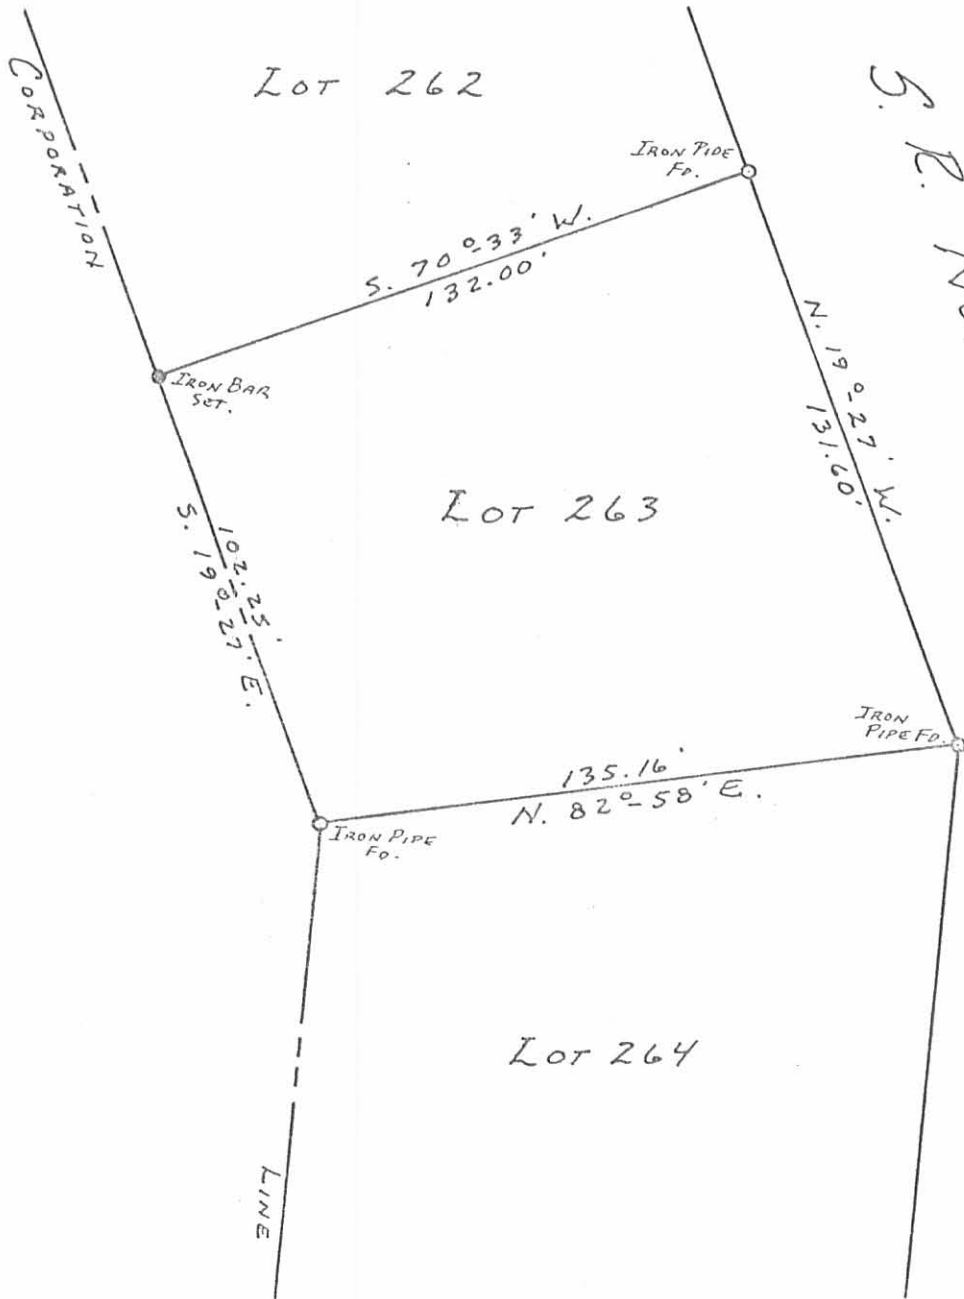

S. R. No. 508

C. H. No. 65

(687) 27

INDEXED ON MAP

SURVEYED AND PLATTED BY:
 DANIEL E. GILBERT, P.S.
 REG. SUR. No. 5402
 1041 N. MAIN ST.
 BELLEFONTAINE, OHIO 43311

DRESSBACK SURVEY
 LOT No. 263
 VILLAGE OF DEGRAFF
 MIAMI TOWNSHIP
 LOGAN COUNTY, OHIO
 APRIL 23, 1983
 SCALE: 1" = 40'