
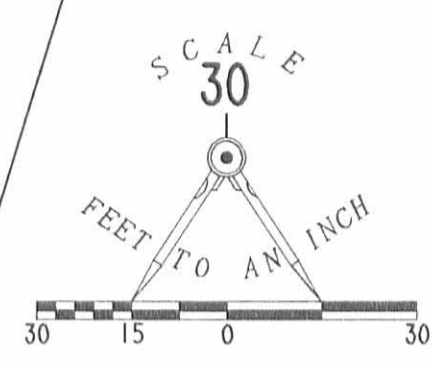


REC'D 3-30-95 SMJ OK

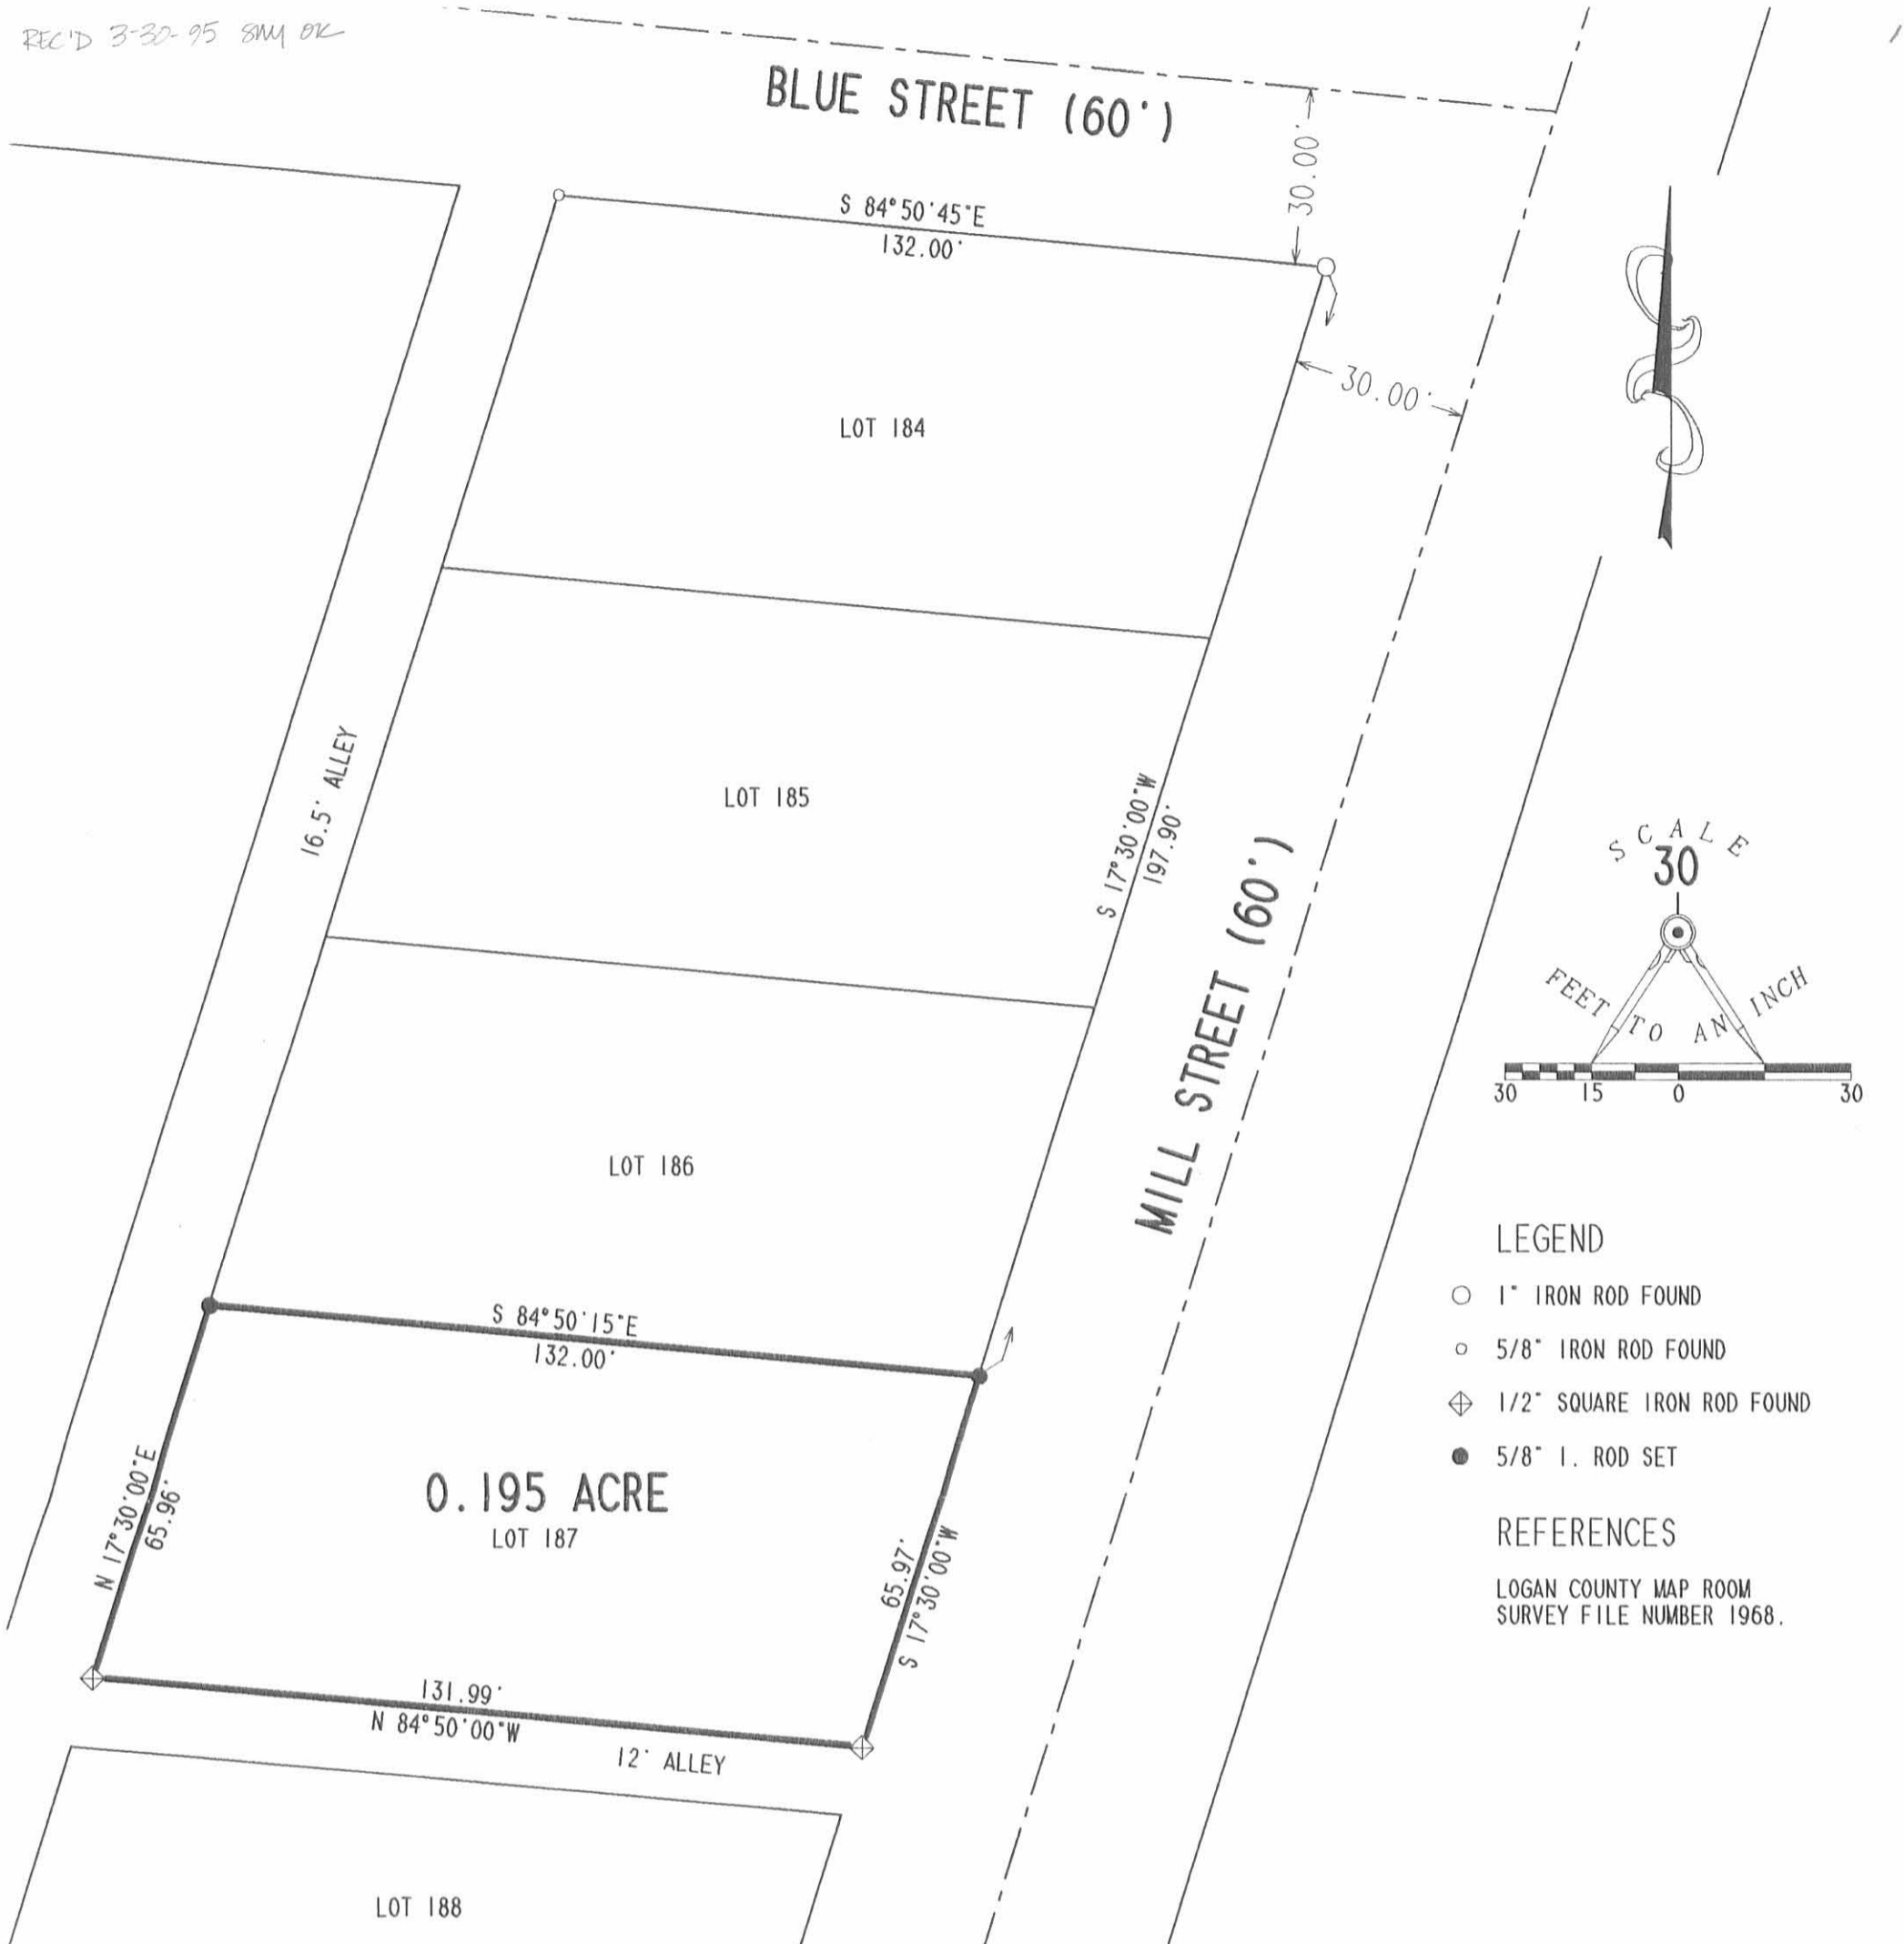


LEGEND

- 1" IRON ROD FOUND
- 5/8" IRON ROD FOUND
- ◊ 1/2" SQUARE IRON ROD FOUND
- 5/8" I. ROD SET

REFERENCES

LOGAN COUNTY MAP ROOM
SURVEY FILE NUMBER 1968.

**RETRACEMENT SURVEY OF LOT 187
MELHORN'S WESTERN ADDITION
VILLAGE OF DEGRAFF
SECTION 12, TOWN 3, RANGE 13
MIAMI TOWNSHIP
LOGAN COUNTY, OHIO**

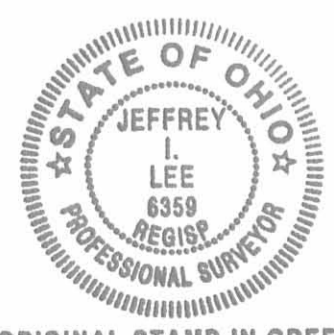

ORIGINAL STAMP IN GREEN

SURVEYED BY:
Jeffrey I. Lee
JEFFREY I. LEE
PROFESSIONAL SURVEYOR 6359
MARCH 23, 1995

COPYRIGHT 1995 BY:
LEE SURVEYING & MAPPING CO.
143 East Columbus Avenue
BELLEFONTAINE, OHIO 43311
(513) 593-7335

2 WORKING DAYS
BEFORE YOU DIG
CALL TOLL FREE **800-362-2764**
OHIO UTILITIES PROTECTION SERVICE.

INDEXED ON MAP
8998 IP