


Road 32 and 13 Harrison Twp.

A - two stakes on top of each other  
bottom Blue granite with small stone  
around it.

B - stake driven by myself  
at point where original stake had been

Dec 12 1927  
foggy.

W. H. Montgomery  
Ed. Core

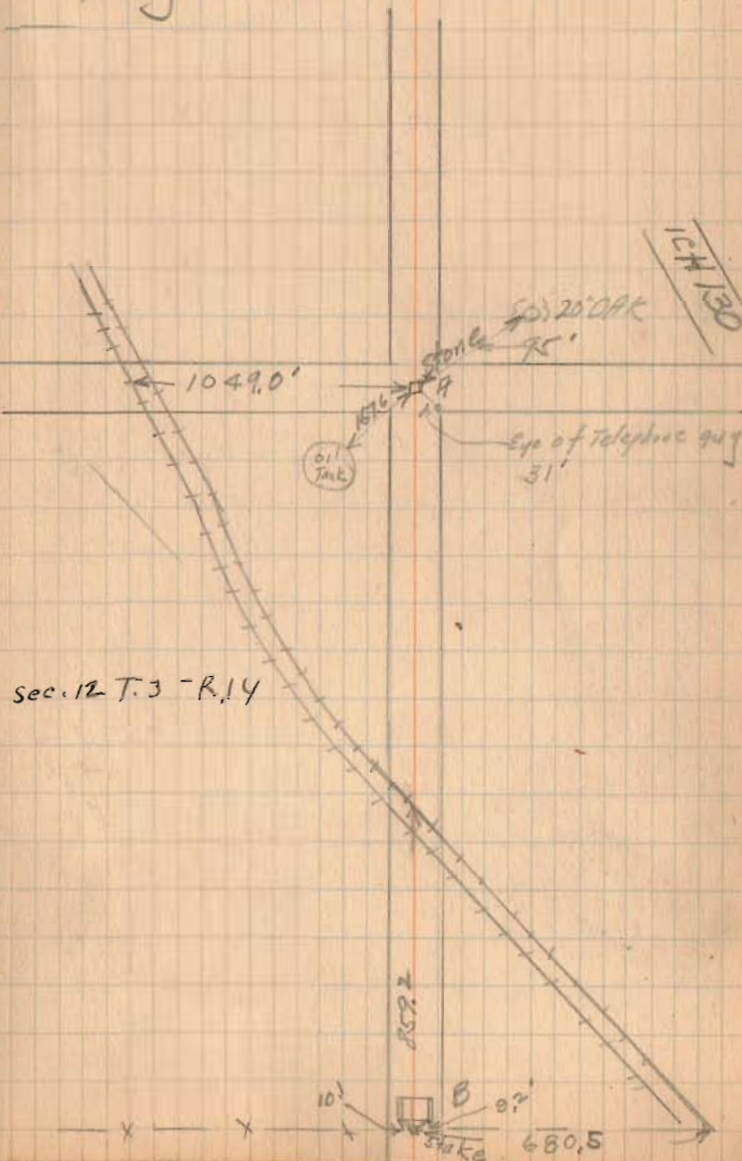

759

INDEXED ON MAP