

Twp. Road # 57
Harrison And. M^e Arthur Twp.


sketch given is Hellman Survey
Made By Wonders sept-1894
See Book 270 Page 13
see Survey 938 Drawer R M^e Arthur Twp.

Note Elec. Line was built after this
survey was made.

Anstine to Coover Book 105 Page 98
33 wide to a Point.

1107

INDEXED ON MAP

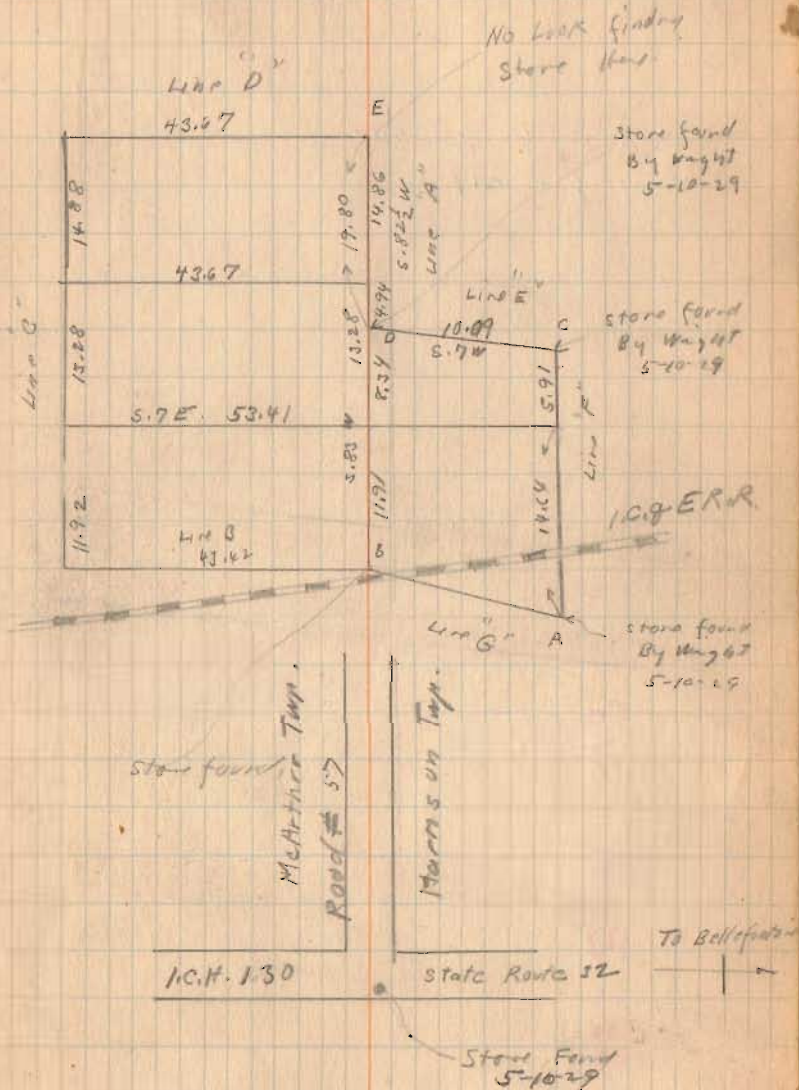

Twp. Road #57

See Anstine Survey By Dailey
Book D Page 64
Survey #219

- A - stone found
- B " "
- C " "
- D " "
- E. Dry for stone No Luck.

See Book 518
See Book 598

INDEXED ON MAP

Now Concrete
Bridle

May-10-1929
Fire Boy
Wright
McKinnon.

33

