

Road 32 Harrison Twp.
Stakes for Light Poles.

- A. Stone Found
- B. I. Pipe Found
- C. R.R. Spike placed

Produced A, B To C, as shown.


60' - Commissioners Journal 6 Page 25
" " " 6 " 73

(See Book 415 Page 61)

Aug 21 - 30

Wright 79
McKIBBEN

(1207)
INDEXED ON MAP

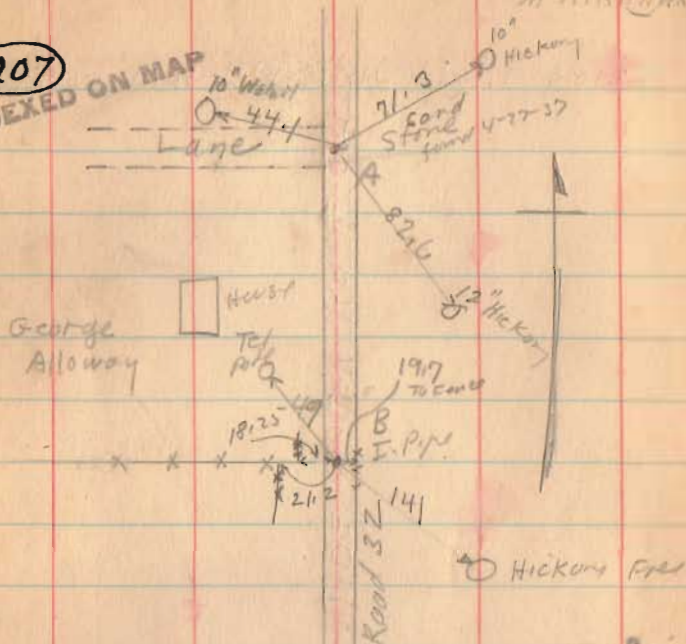

Sec 11 HARRISON TWP

