

Road 57

Harrison Twp - McArthur Twp

60' - Road. Commissioner's Journal 5 Page 4-5

(1836)

60' Road " " 6-79

Placed stakes for 50' road.

1-3-7-9-11 etc

Note: 1" # bar set on back tan

0+00 - 23+65 because of US 33

Relocation used 119.5 North of R/W Mass

on # Old US 33 to set up west end of tan.

See Book 479 Page 32-33

1726

INDEXED ON MAP

168+00

211.130

Concrete

Route 33

03

P.T. 162+96.92

July-16-1936

Clear-95°

F. Wright

G. Wilgus

T. Montgomery

Rub Roberts

Max James

25.35

21+15
710/45

91.0
15" Hickory
15+25

18+15
1" # bar set
7/9/35

Twp.

No Fence

6+12

24.0
5+00

McArthur

O.G. Hashine

26.5
3+00

28.6
1+00

86

98.0
2+13

7.35

1/2 APC
Grosville
Thurs Line

119.5
Stone
brick
on top

Dennis McKeenan


Harrison Twp.

p.c. 100+16.92

150+00
9/11/1936
Plot L-27

2-25-48
T=140103
E. 1.171

Road 57

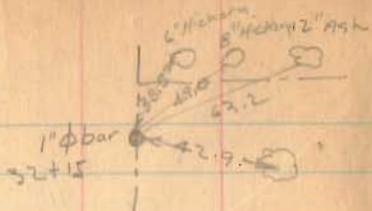

29+15 1" # bar set 7/8/65

Note: 1" # bar set on Fwd tan because of U.S. 33 Relocation

23+65

23+65 Stone Fd 7/8/65

$A = 0^{\circ} 36' \text{ Rt}$

1726

INDEXED ON MAP

21+15 1" # bar set 7/8/65
see pg 65

7-16-36 .66

Maggie Hellman

31700

31685

Alice Kelley

1" # bar set 7/8/65

29700

12.4

27700

16.0

25700

No Fence

550.0

Alice Keller

247

24+15.3

75.10

247

45.8

18.0

23+07

1.C.R.E. Elec. R.R.

23+65

23+65

$0^{\circ} 36' \text{ Right}$
Fd July 8, 1965
 $L = 0^{\circ} 20' \text{ Rt}$

No Fence

19.0

23700

Dennis M^r Kinnon

Moose

No Fence

12" Oak

Alice Keller

15" Hickory

57.9

29700

10.6

10.6

Road 57

22+24.7
13+08.5

8+76.2

37+13.5
29+65


1348.5

40 A. on East

1726


INDEXED ON MAP

67

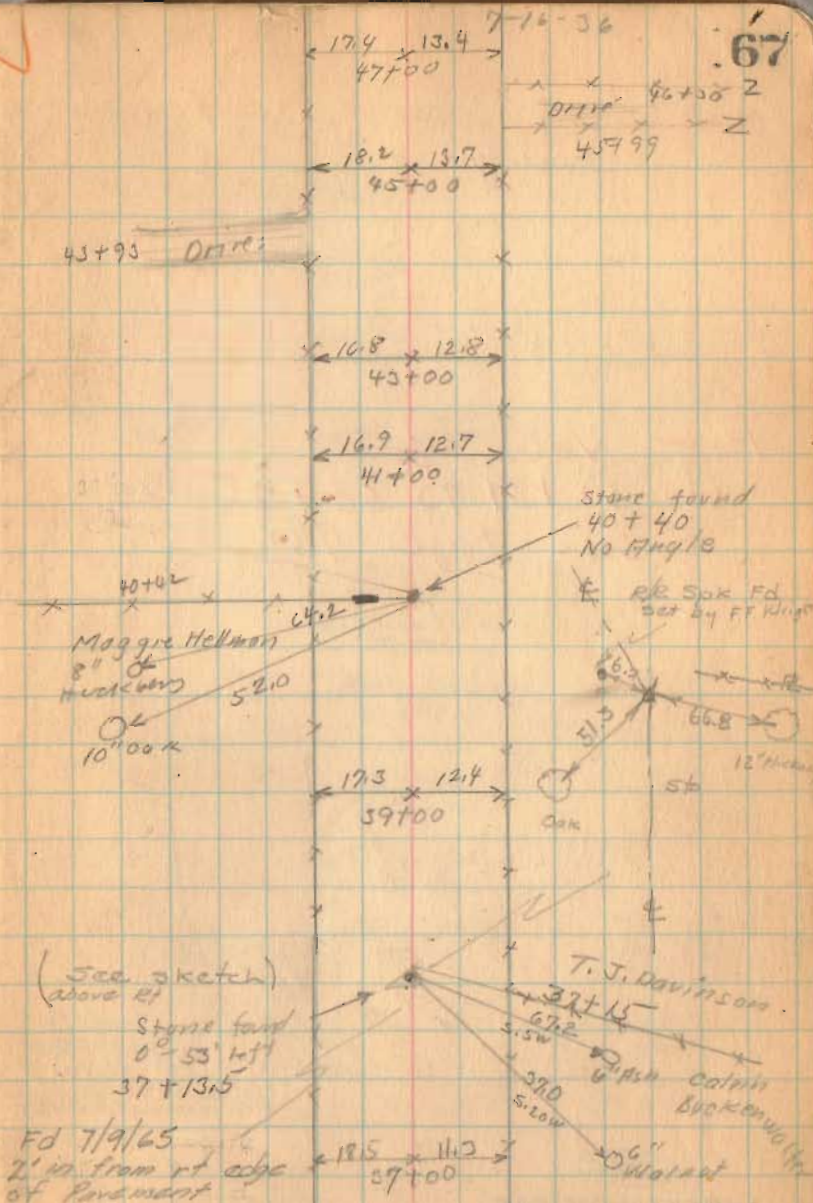

Road 57

FOR NEW &
sta. 30+21 TO 68+25
see Page 76

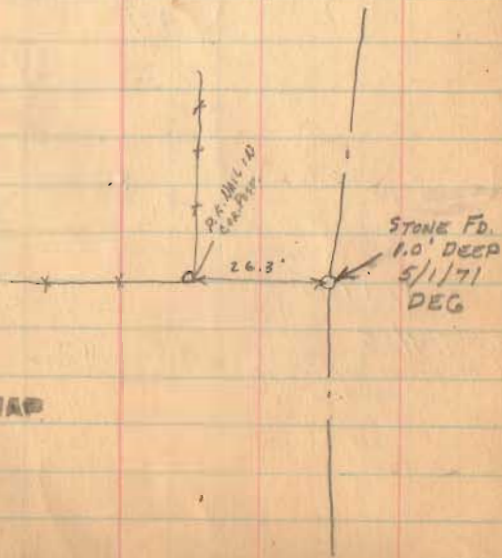


1726

INDEXED ON MAP

7-16-36

68

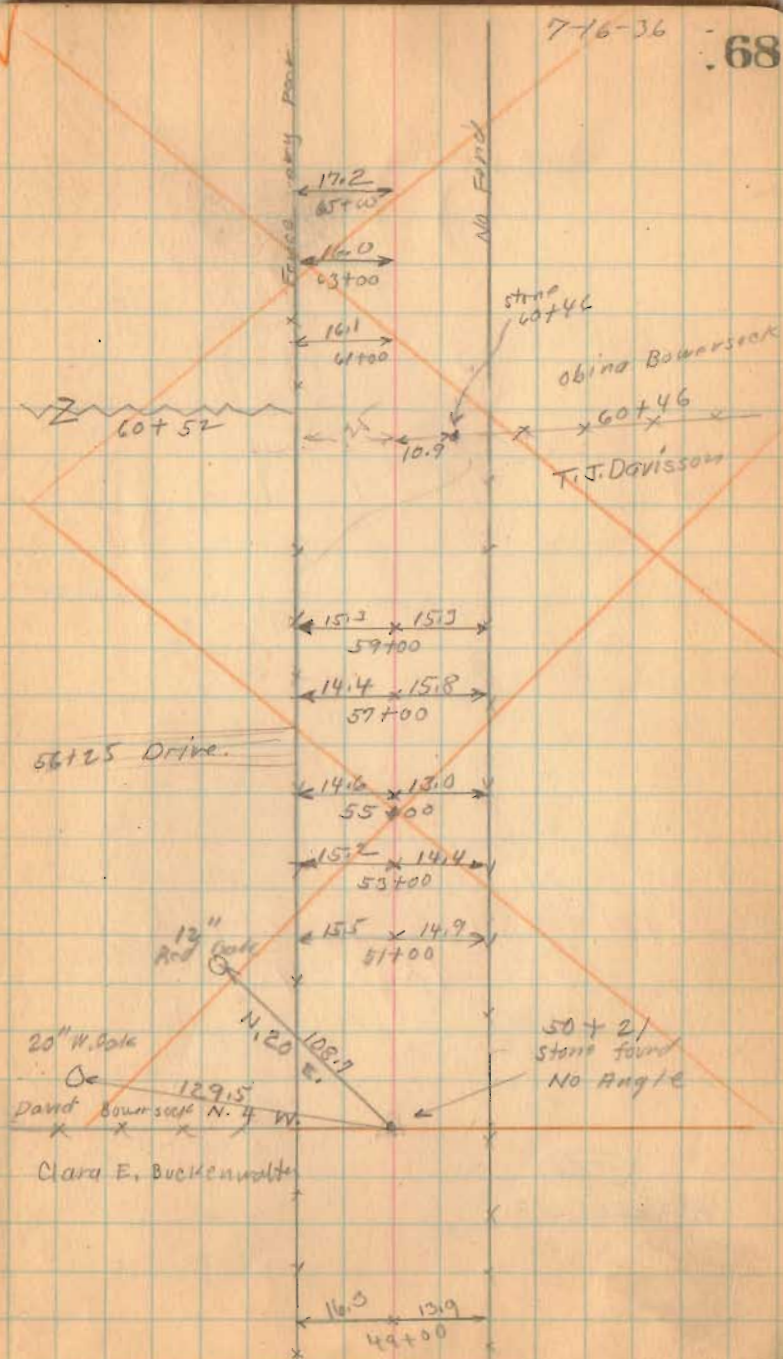

Road 57

7-16-36

69

10" Hickory
Board St. 17p 47

22.3
50.0

Isabell
Wallace

Road 56

10" Pass
Sta. Pass
Board St.
Page 47

David Bowersox

68+08
Place
Iron


23-54 Left.

2 45+65


For New &
Sta. 50+21 To 68+25
See Page 76

1726

INDEXED ON MAP

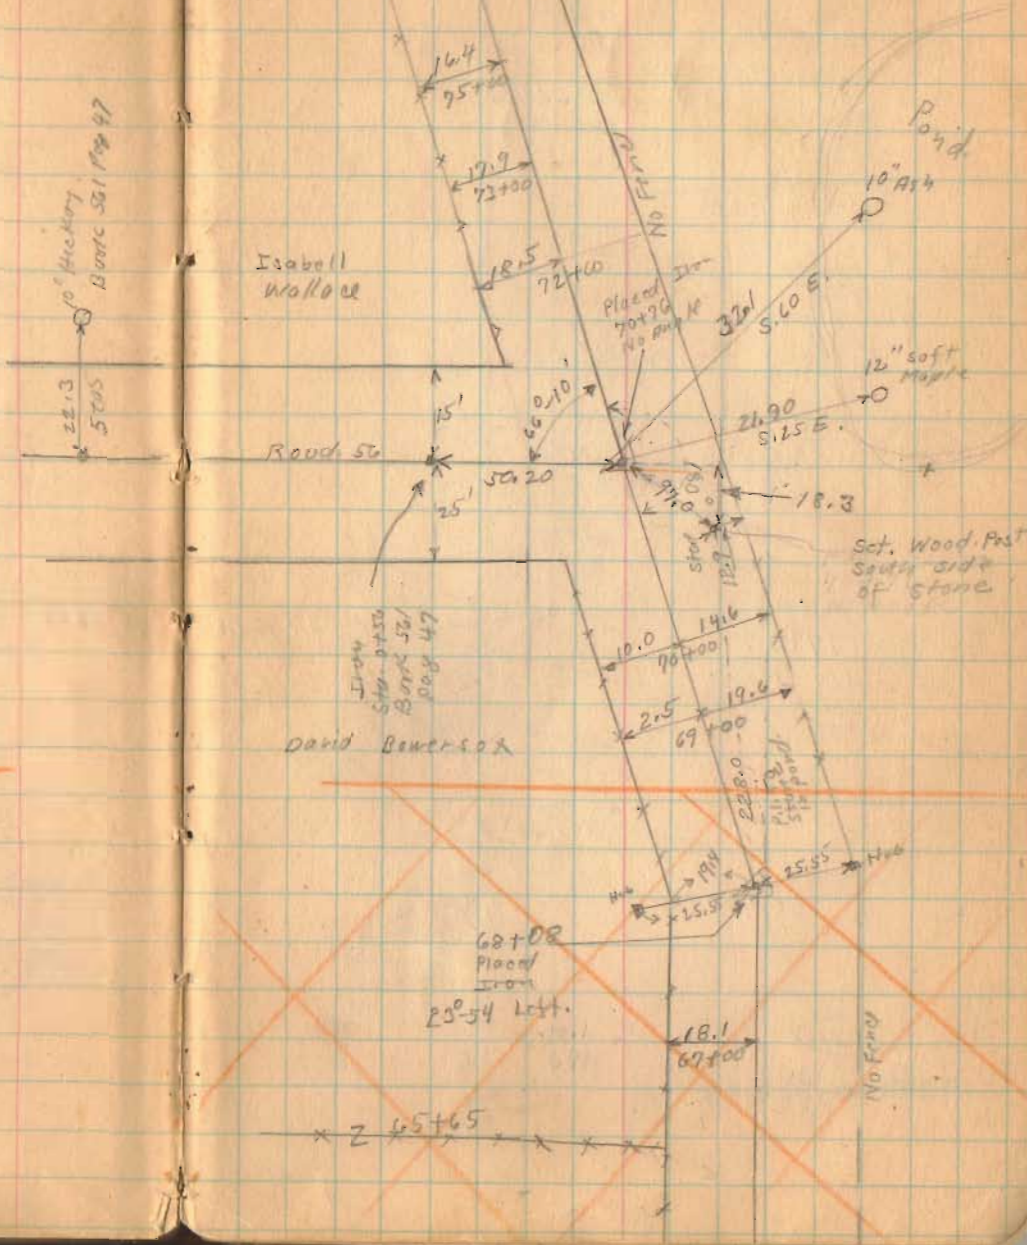


Road, 57

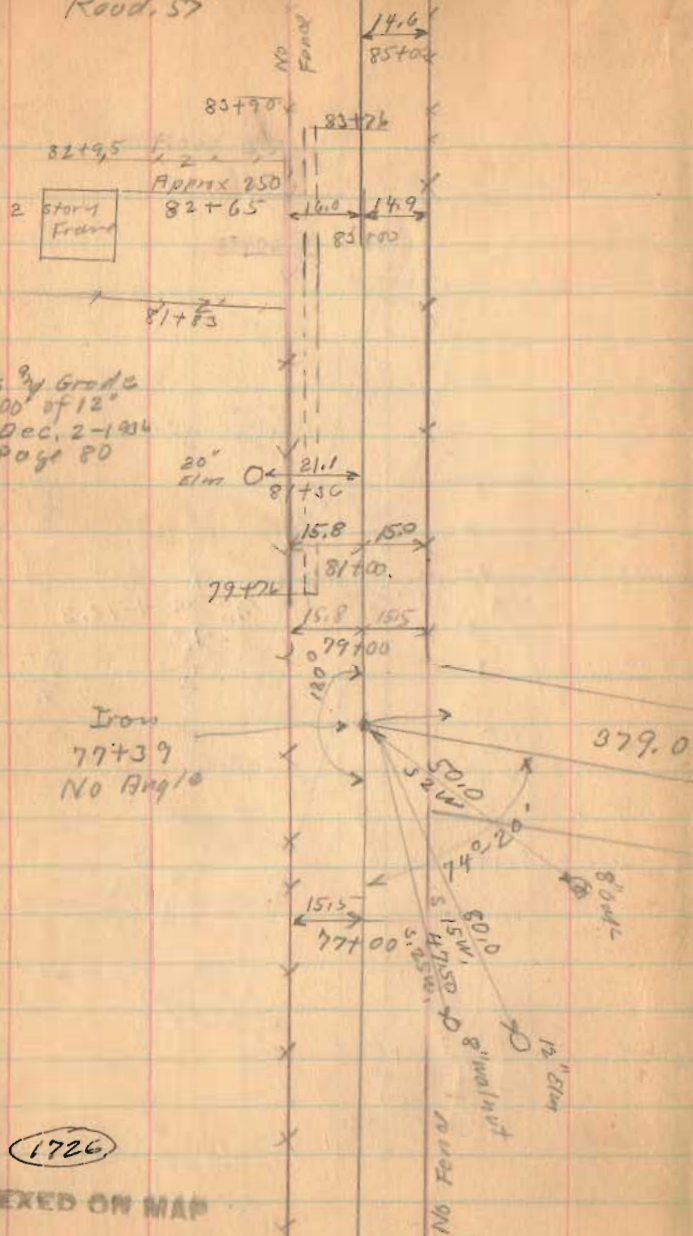

7-16-36

70

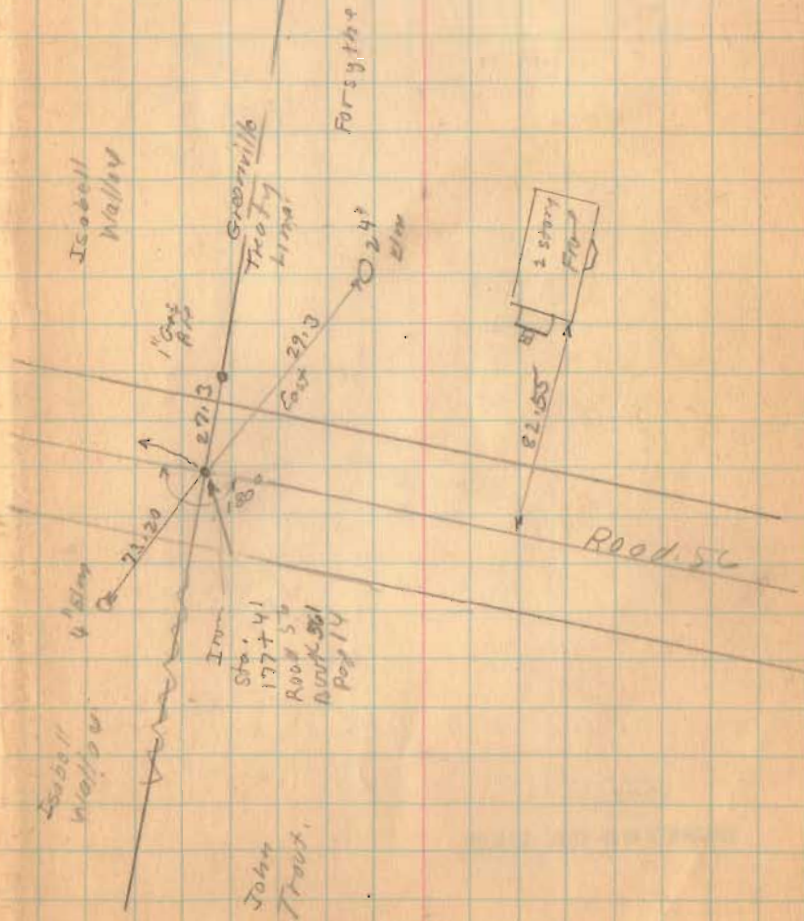

Road 57

(1726)

INDEXED ON MAP

July 17 1936

Clark

F. Wright

J. Montgomery

G. Wilgus

Max James

Joe Roberts

71

Wilson Downs
92+87
I. Wallow

Red Granite
stone with
cross

Placed Iron
87+58
No flag


Madison
Kemp

796.0

I. Wallow

Granite
T. Forstner

A Forstner

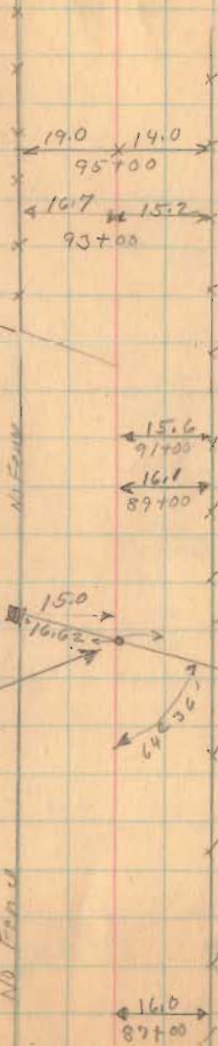


Band 157

(1726)
INDEXED ON MAP

7-17-36

72

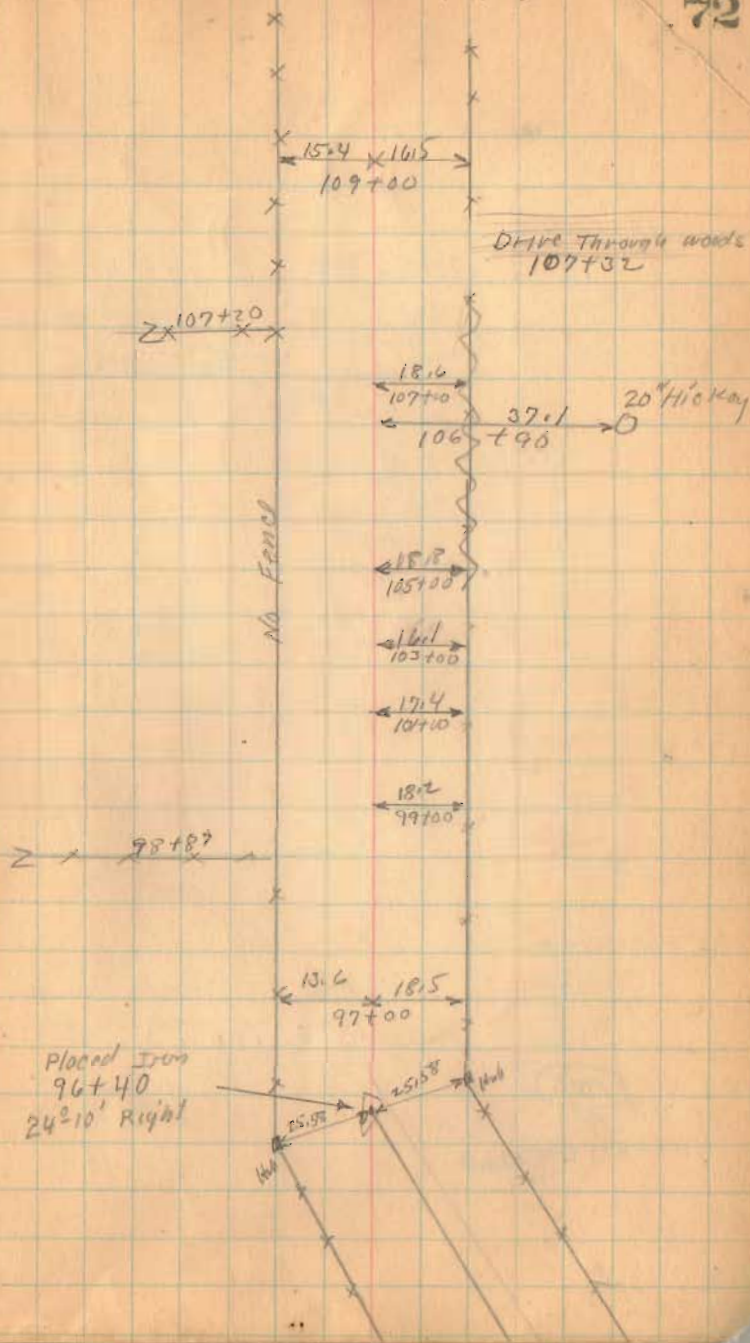

Road 57

No stakes placed
Sta 135+08 to Sta 167+47

1726

INDEXED ON MAP

7-17-36

74

W.M. Mitchell

Road 49
Patterson Pike

Placed Hub
135+08

Oliver Allebaugh


1/2 Store
Frame

Barn
Concrete
Ftd.

E. W. Troyer
LON
129+03
A. W. Miller



Concrete
Stairs

1 Store
Frame

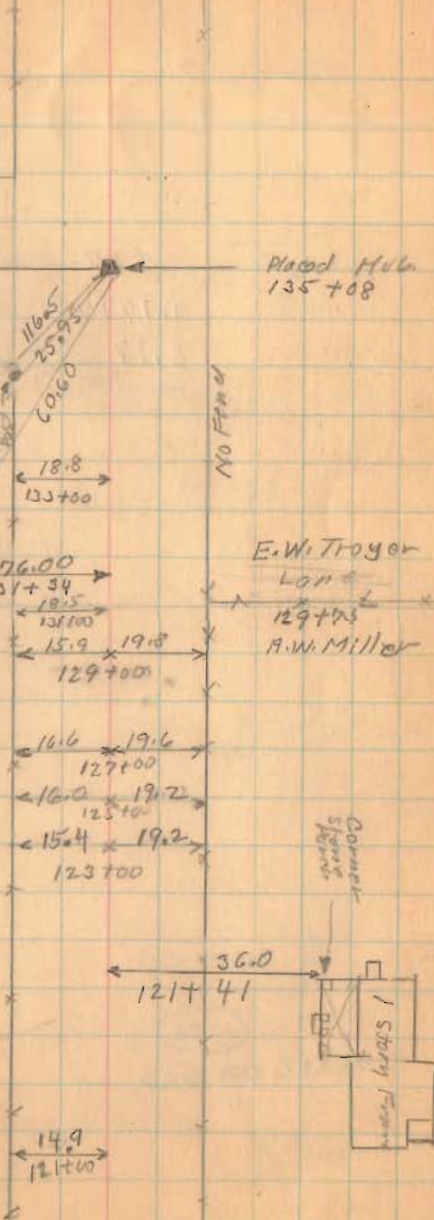

Road 57


Length 16,747 Feet
 " 3.17177 Miles
 " 3.17 "

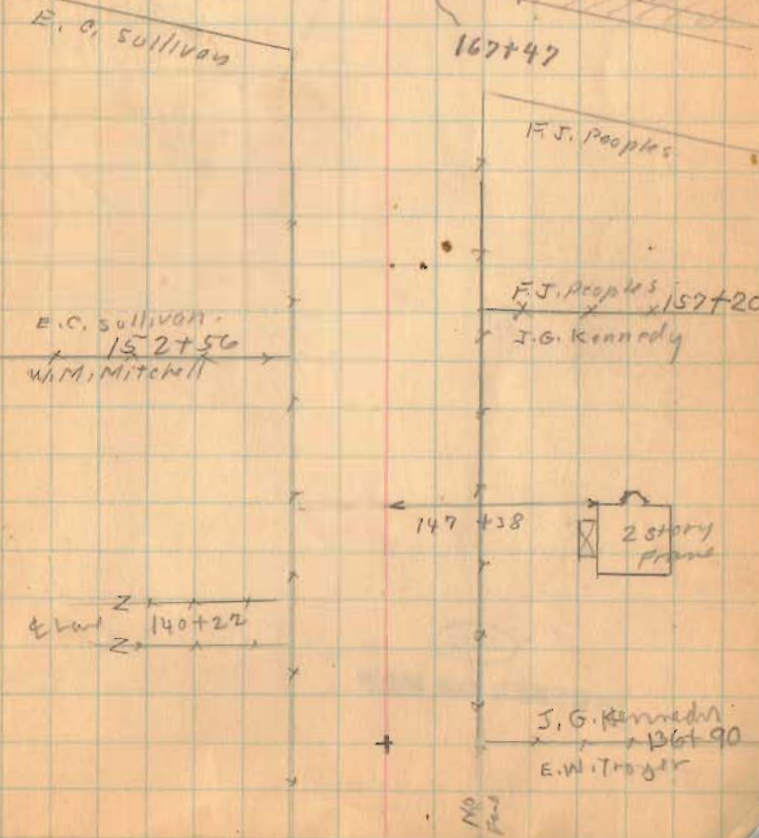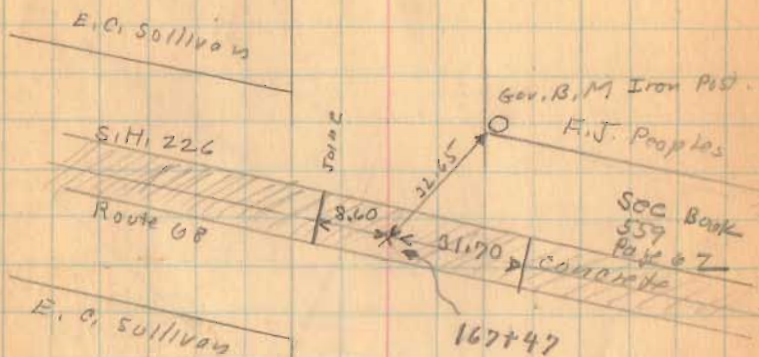

1726

INDEXED ON MAP

Road 57

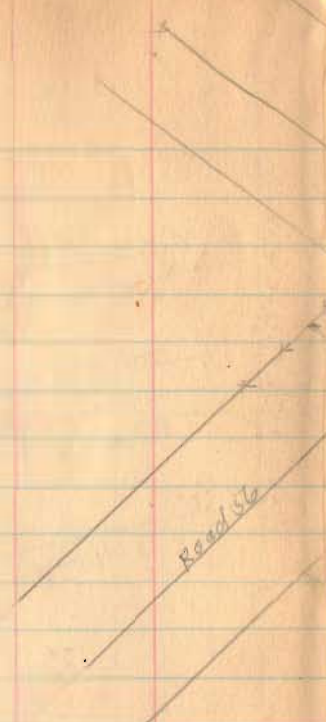

✓
 Drive Post 69
 Stone at Sta 70+76
 New Sta 70+73.5

Sept. 12-1936
 cloudy
 F. Wright
 G. Wright
 Max James,
 Joe Roberts,

Road 56

Plaid Iron
 22°-28 left
 68+25

Iron
 (Pl. Page 69)

Stone
 60+46
 22°02 left

57.1
 N. 62 W.
 100' Roberts

South

Oblio Borel
 T.W. Dawns
 5/16
 6' oak

50+21
 Stone
 0°-36' Right

1726

INDEXED ON MAP