


CLAIR A. INSKEEP  
 CIVIL ENGINEER  
 INSKEEP BLOCK  
 BELLEFONTAINE, OHIO

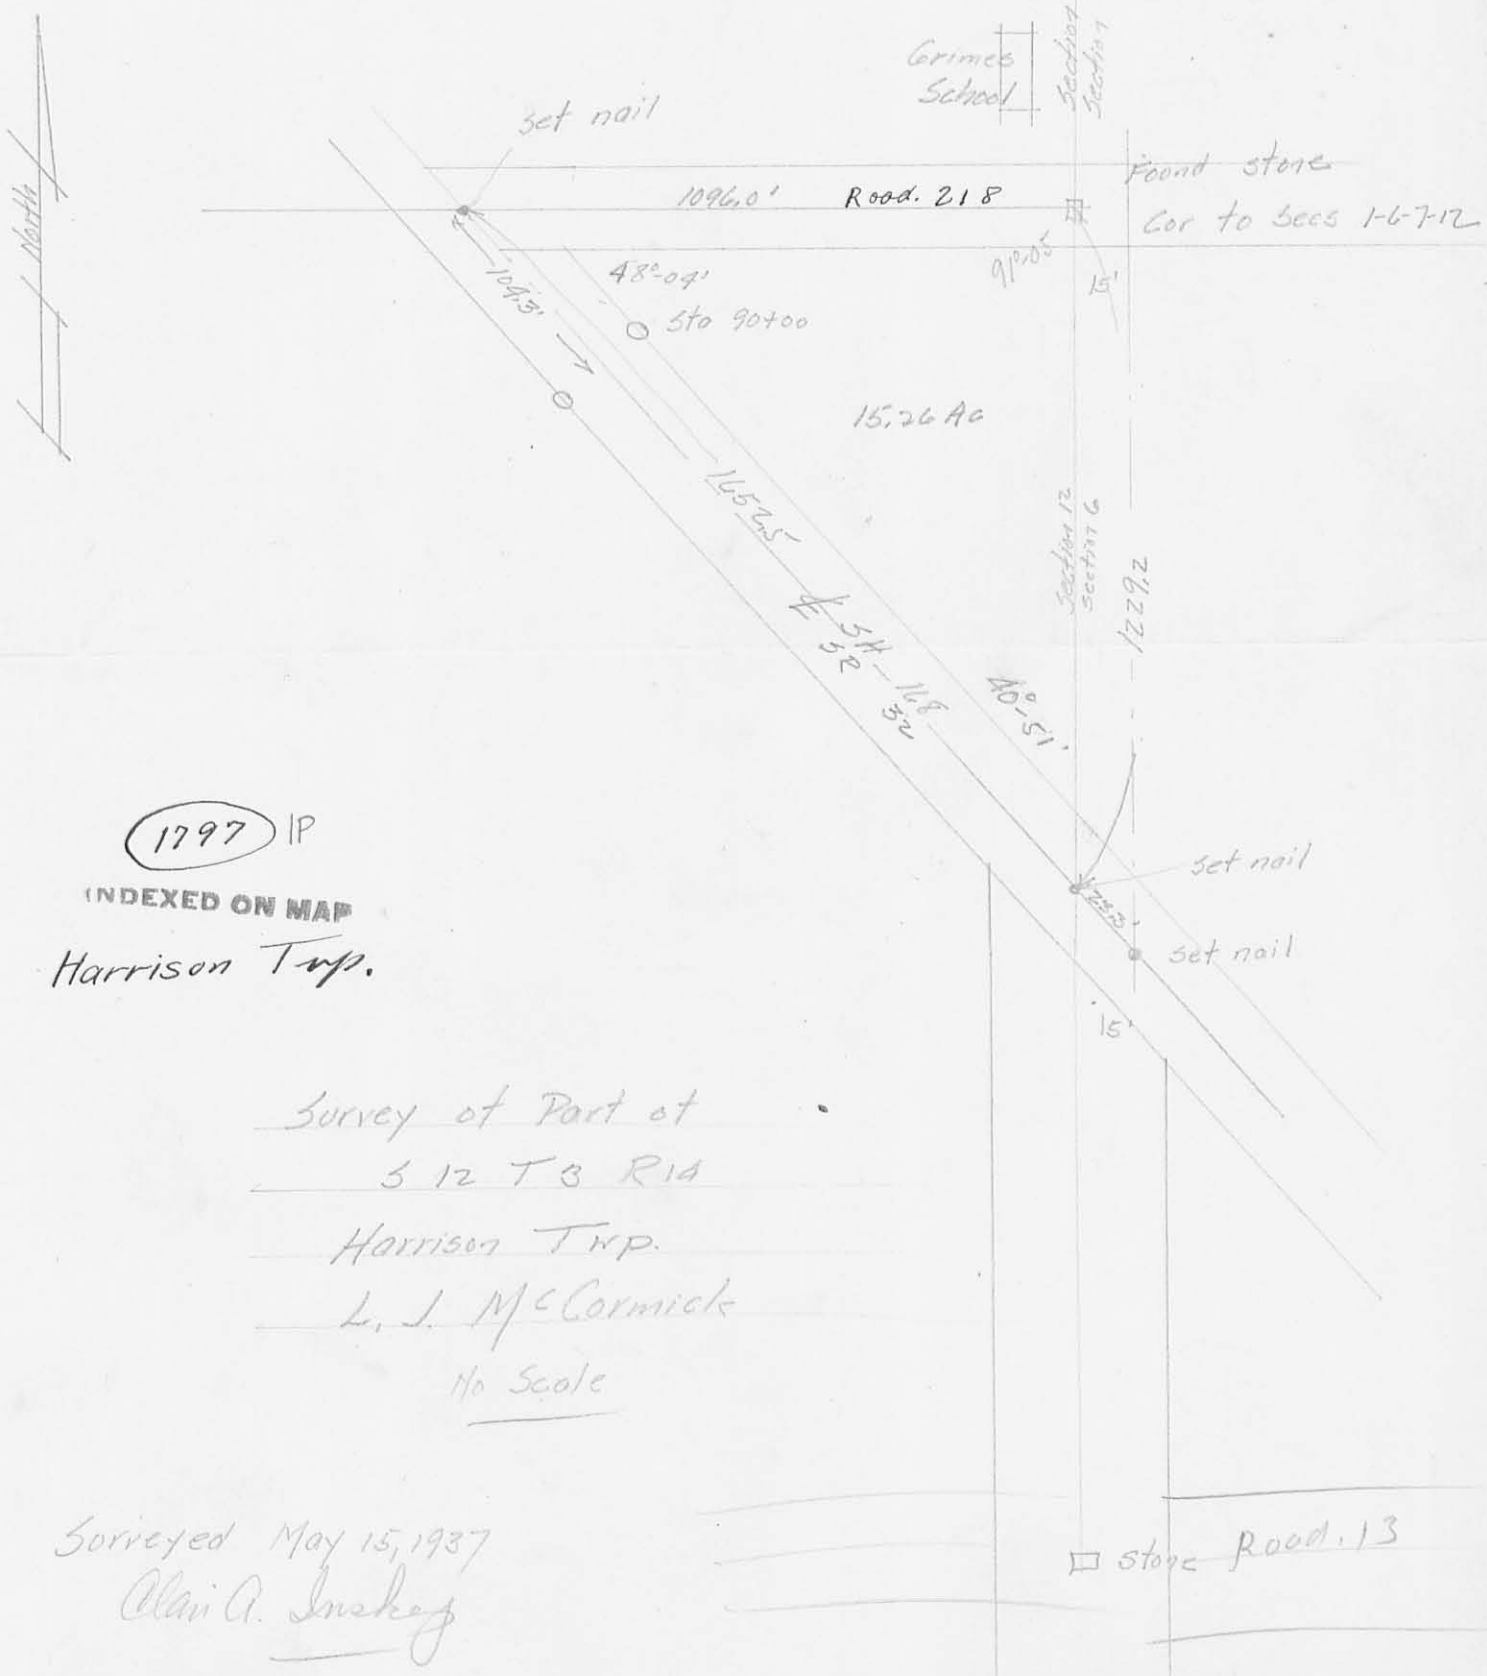

1797 IP  
 INDEXED ON MAP  
 Harrison Twp.

Survey of Part of  
 3 12 T 3 R 14  
 Harrison Twp.  
 L. J. McCormick  
 No Scale

Surveyed May 15, 1937  
 Clair A. Inskeep

□ stone Road. 13