

DETRICK SURVEY

Sec. 21, T-3, R-14
Harrison Township
November 9, 1957

The following described real estate situated in Harrison Township, Logan County, Ohio and being part of the east $\frac{1}{2}$ of the southwest $\frac{1}{4}$ of Section 21, Town 3, Range 14 of the Between the Miami Rivers Survey and more particularly described as follows:

Commencing at an iron pipe at the intersection of the center lines of County Highway No. 11 and County Highway No. 46, said pipe being the northeast corner of said southwest $\frac{1}{4}$ section, said pipe also being Sta. 80+04 as shown in the Logan County Engineer's field book No. 687, page 78; thence with the center line of said County Highway No. 46 S. 5°-00' W. 330.0 feet to an iron pin at the southeast corner of the present Gretna Brethren Church property, said pin being the beginning point of this description; thence continuing with said center line S. 5°-00' W. 150.0 feet to an iron pin; thence N. 85°-07' W. 152.0 feet to an iron pin; thence N. 5°-00' E. 150.0 feet to an iron pin at the southwest corner of said Church property; thence with the south line of said Church property S. 85°-07' E. 152.0 feet to the place of beginning.

Containing 0.52 of an acre more or less.

2815


INDEXED ON MAP

on Plat Book

Gretnd Church
Harrison Twp

Dadson
Geoslin

Nov. 9, 1957 39

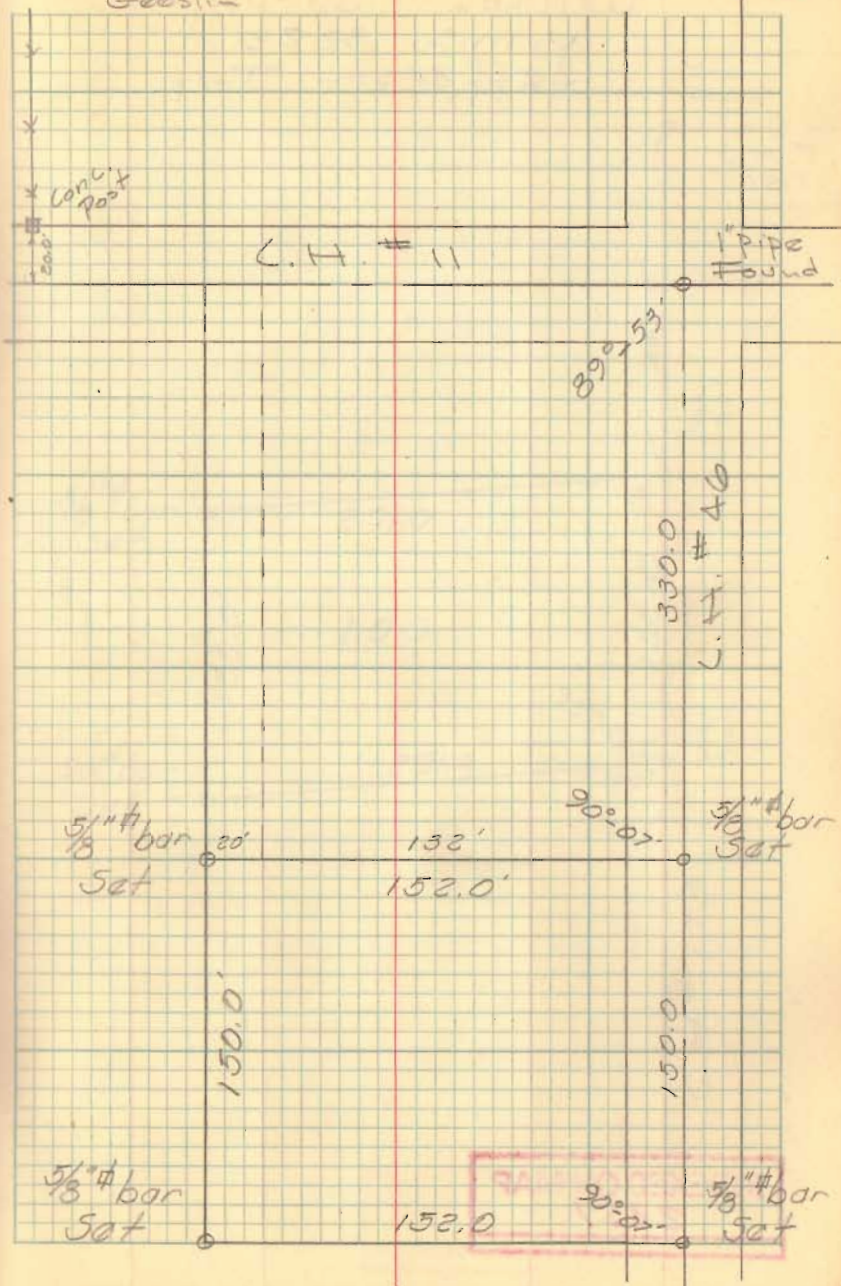

INDEXED ON MAP
2015

INDEXED ON MAP
2015

Gretna Church
Harrison Twp

Bk 3 pg 39

INDEXED ON MAP
2815

Dodson
Gretna

11/9/57

30

