


Survey
1850

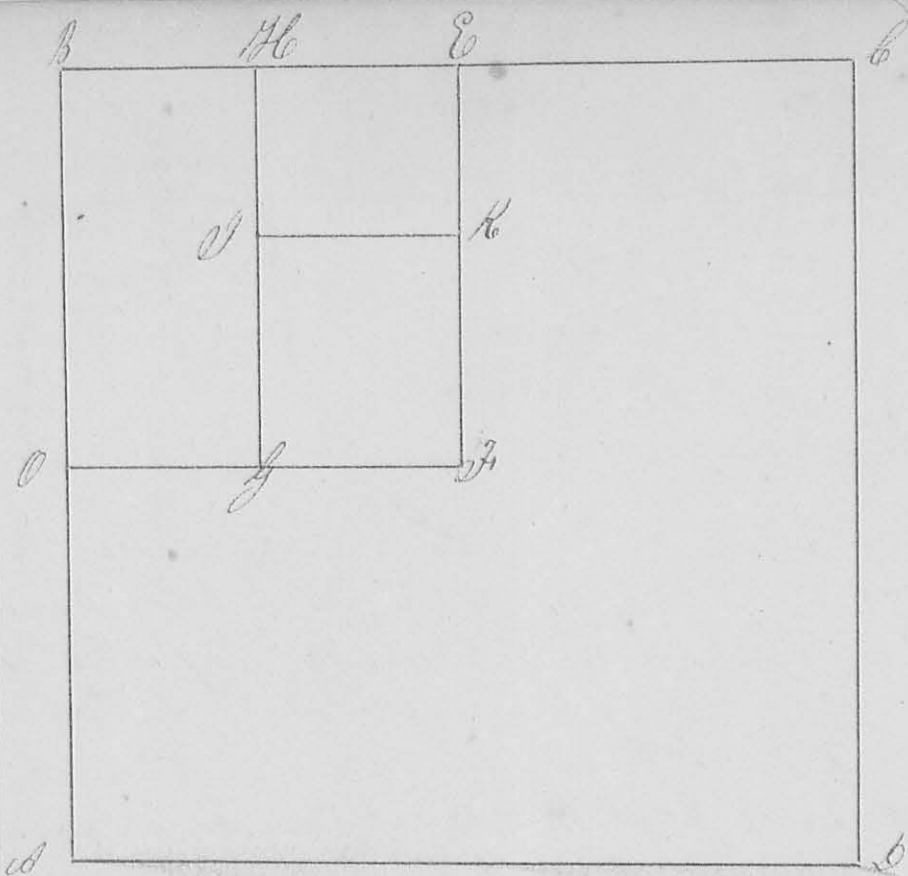

8515

Surveyed Nov 20 1845 for David Nevin & others the North East quarter of Section eleven, Town three, Range 14 East Mrs, having first ascertained the Boundaries of said Section to be as follows

AB = 321.4 p, BC = 326 p
 CD = 326 " DA = 324 " Containing 656 ⁵⁰/₁₀₀ Acres

The North West quarter Begins at the North West Corner and runs East 162.5 poles to a Stake at E N 1/2 W 9 links from White Oak 22 D, then South 162 poles to Stake at J, N 70 1/2 W 3 links from Bur Oak 20 D, then West 162.3 poles to a Stake S 44 1/4 W 53 links from White Oak 18 D then North 161.4 poles to the Beginning Containing 164 ¹²/₁₀₀ Acres
 Corner at G, Bur Oak, 20 D, N 82 W 32 links
 " " J, Red Oak, 20 D, S 74 1/2 E 24 "
 " " K, Stake

BO = 161.4, BH = 81.4 p, HE = 81.1 p, EK = 69 p, KF = 93 p JG = 81 p
 OG = 81.2 p HJ = 161.7 p, JD = 92.7 p, JH = 69 p, JK = 81 p
 Lot No 1 contains 82 ¹⁰/₁₀₀ Acres, No 2, 35 Acres, No 3 27 ⁶/₁₀₀ Acres