


FB 588

Road 126 Jefferson Tap

40' Road Road Record No. 2  
Page 478

(stakes not on stationing)

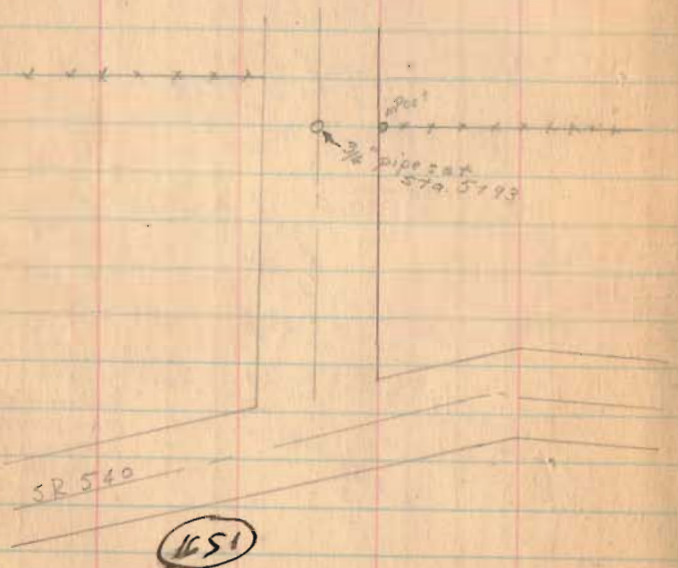

INDEXED ON MAP

April - 26 - 1935

1935

F. Wright

E. C. Cope

G. Wilson

1935

Bridge 126 - 0.35

E. Richardson

16+48

10' 20'

Peoples S. & Loan  
of Urbana

R. Wimmer

5+93

5+91

W. Wilgus

H. G. Galt  
1257' left  
5+93

Sta. 154+25.3

Sta. 149

ROAD NO. 2  
See Page 15

100' Sta. 0+00

100' Sta. 151+54

100' Sta. 152+00

100' Sta. 152+50

100' Sta. 153+00

100' Sta. 153+50

100' Sta. 154+00

100' Sta. 154+50

100' Sta. 155+00

100' Sta. 155+50

100' Sta. 156+00

100' Sta. 156+50

100' Sta. 157+00


100' Sta. 157+50

100' Sta. 158+00

100' Sta. 158+50

FB 588

Road 126

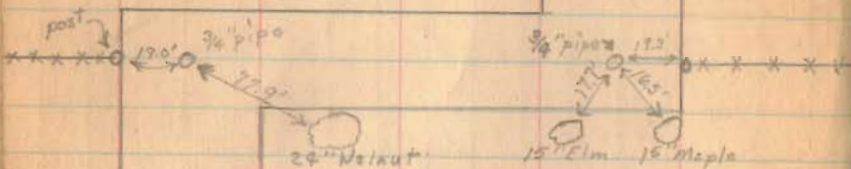

29" Walnut

15" Elm 16" Maple

1651

INDEXED ON MAP


F-26-33

3

V.M.S.  
3325

V.M.S. 3326


Eirikendson

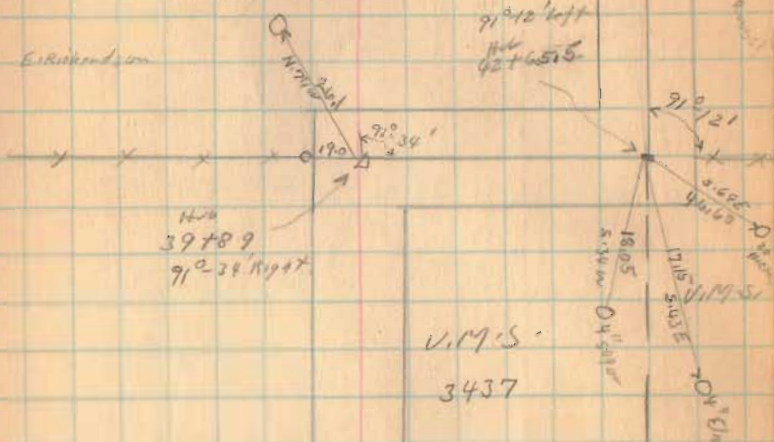

H.W.  
39789  
9/238 R.P.P.T.

V.M.S.  
3437

V.M.S.  
3436

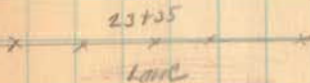




FB 588

Road 126

1651

INDEXED ON MAP

4-26-55

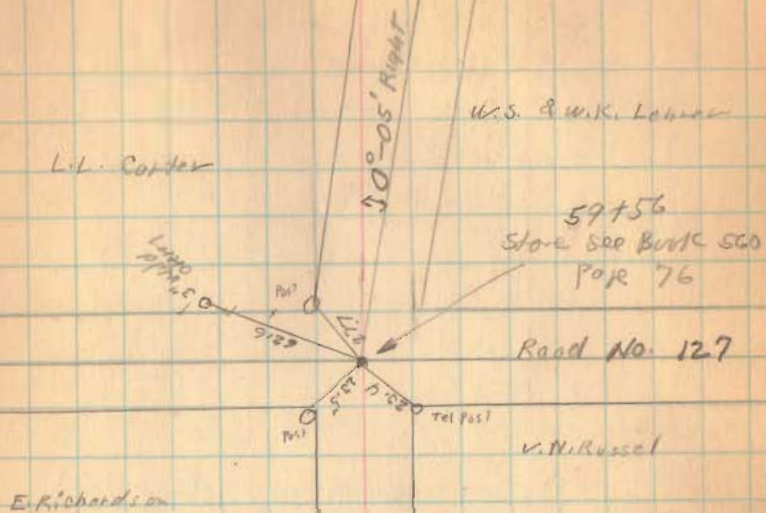

Resurvey T.R. 126 (S.R. 540 to T.R. 127)  
Jefferson Twp., Logan Co., Ohio

FB 710

15+00 Set RR Spike, P.O.T.

9+46.81 Set RR Spike, P.O.T.

5+90.63 Fd.  $\frac{3}{4}$ " pipe  
Angle Lt  $1^{\circ} 41' 13''$

5+00 Set RR spike, P.O.T.

1+00 Set RR spike, P.O.T.


0+12.62 Set PK near ep of S.R. 540

0+00 Fd.  $\frac{1}{2}$ "  $\phi$  iron (6" deep)

Nichols  
Simmons  
Archer

8 Aug. 96

14

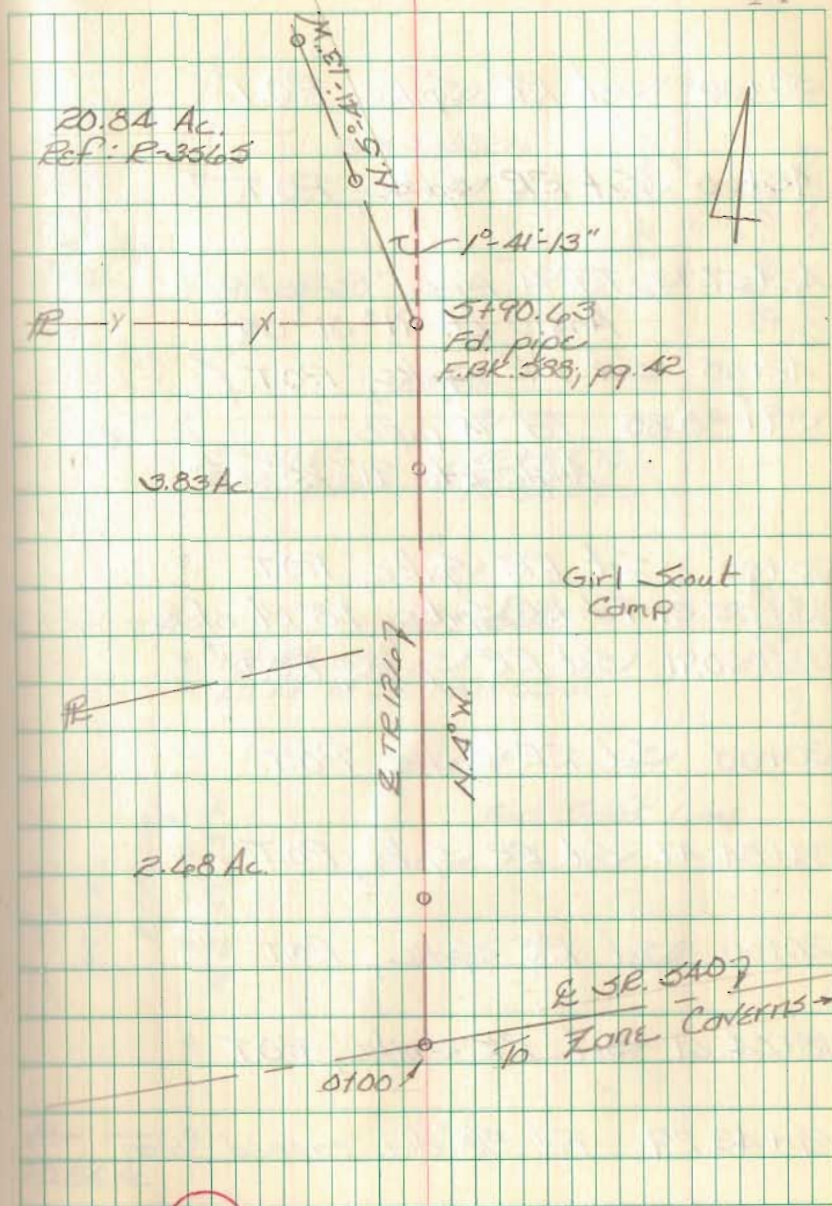



Resurvey T.R. 126 (S.R. 540 to T.R. 127)  
Jefferson Twp., Logan Co., Ohio

FB 710

50+00 Set RR Spike, P.O.T.

45+00 Set RR Spike, P.O.T.

42+57.73 Fd.  $\frac{3}{4}$ " pipe  
Angle Lt.  $91^{\circ}01'05''$

42+00 Set RR Spike, P.O.T.

39+80.85 Fd.  $\frac{3}{4}$ " pipe  
Angle Rt.  $91^{\circ}25'30''$

35+00 Set RR Spike, P.O.T.

33+55.31 Fd. RR Spike, 1.8' Rt. of L

32+30.91 Set RR Spike, P.O.T.

30+00 Set RR Spike, P.O.T.

24+84.47 Set RR Spike, P.O.T.

20+00 Set RR Spike, P.O.T.


18+04.61 Set RR spike, P.O.T.

14+43.29 Fd.  $\frac{9}{8}$ " dia. capped iron

Nichols  
Simmons  
Archer

8 Aug. 96

15

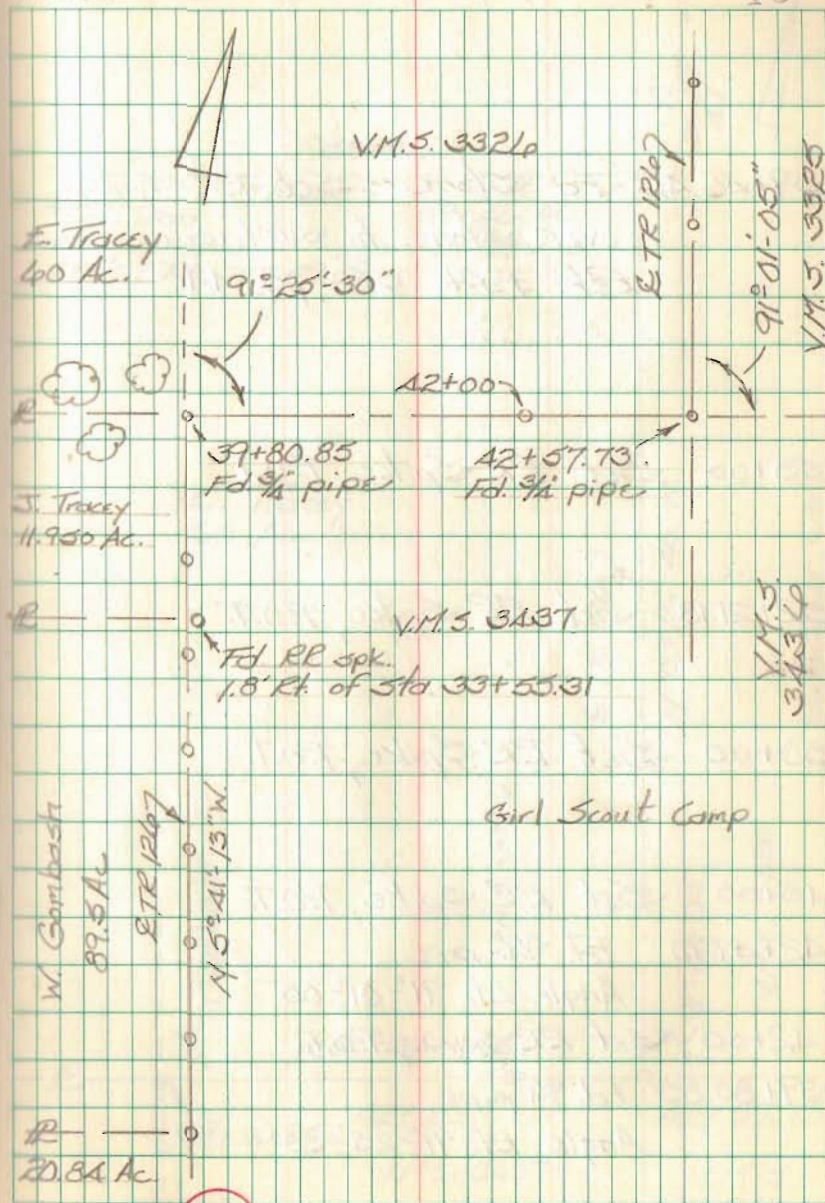



Resurvey T.R. 124 (S.R. 540 to TR 127)  
Jefferson Twp., Logan Co., Ohio

FB 710

59+16.16 Fd Stone - Set RR Spike  
over stone to surface.  
Ref: F.P.K. 588; pg. 44

55+00 Set RR Spike, P.O.T.

52+21.18 Set RR Spike, P.O.T.

50+00 Set RR Spike, P.O.T.

45+00 Set RR Spike, P.O.T.

42+57.73 Fd  $\frac{3}{4}$ " pipe  
Angle Lt.  $91^{\circ}01'05''$

42+00 Set RR Spike, P.O.T.

39+80.85 Fd  $\frac{3}{4}$ " pipe  
Angle Rt.  $91^{\circ}25'30''$

Nichols  
Simmons  
Archer

8 Aug. 96

16

