



Zanesfield Cemetery Survey
 V.M. 5. 3137 - Jefferson Twp.

FB 701

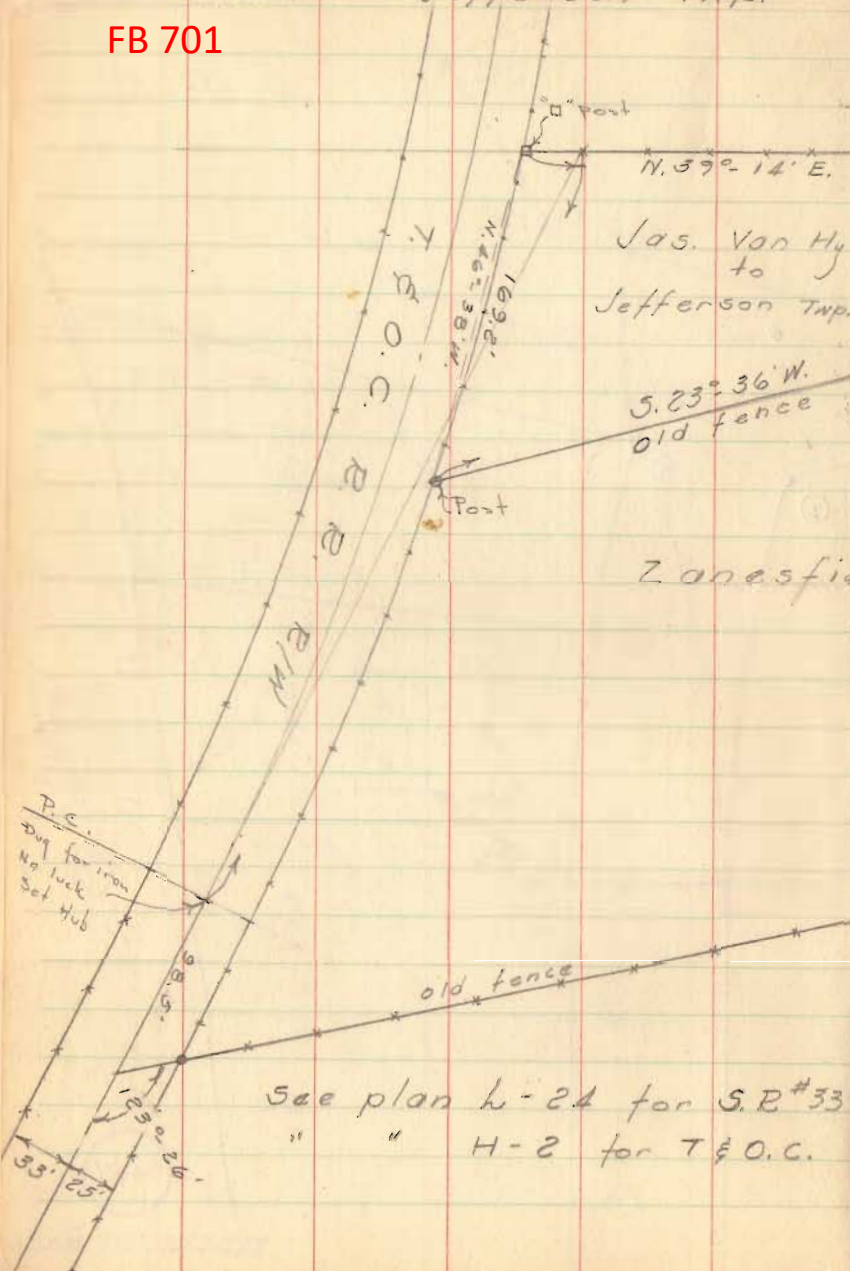

Dodson
 Detrick
 Gilbert

Feb. 26, 1958
 40°

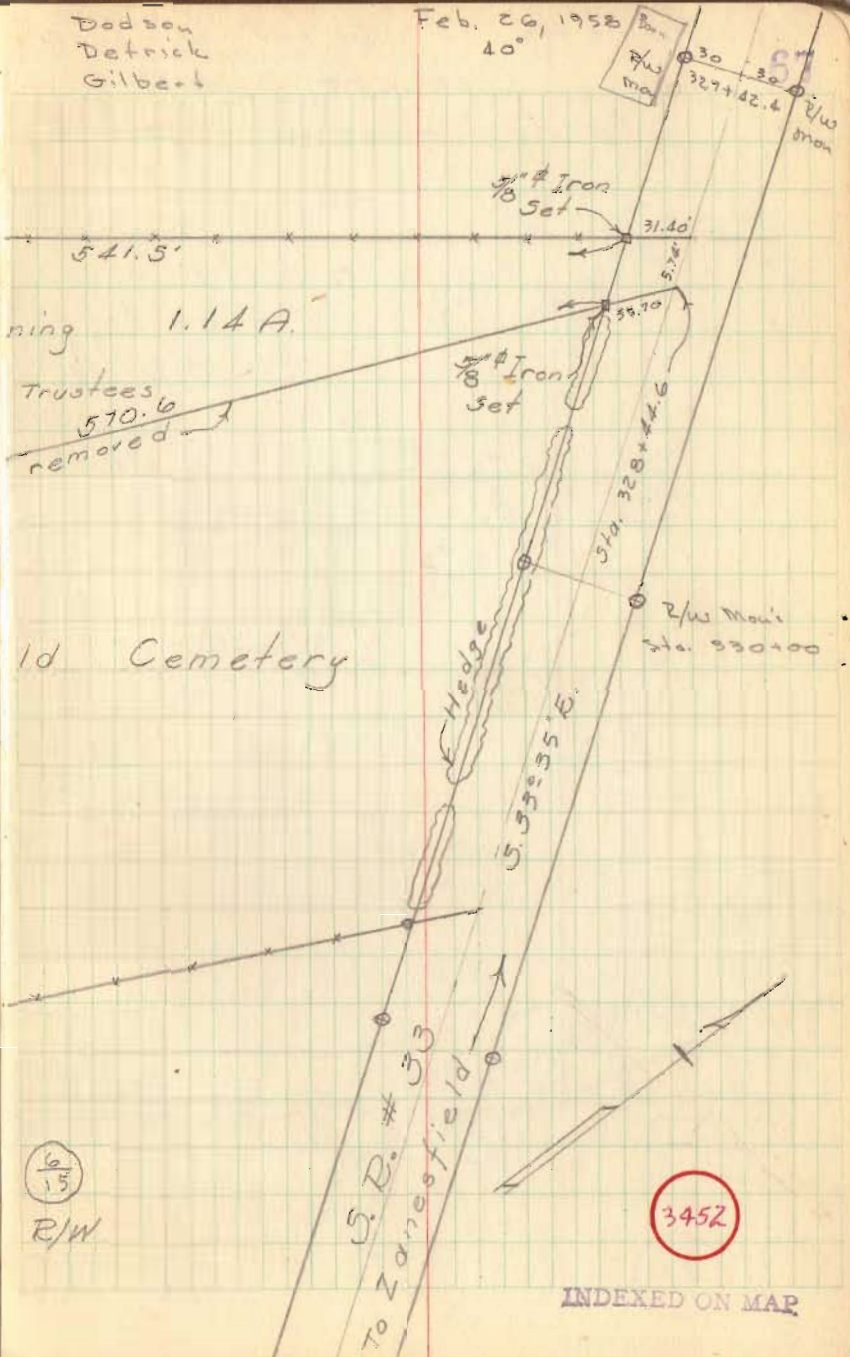

Jas. Van Hyning 1.14 A.
 to
 Jefferson Twp. Trustees.

Zanesfield Cemetery

INDEXED ON MAP