

PLAT OF DEDICATION OF THE RIGHT OF WAY for  
**MARMON ROAD**

located in the County of Logan, Township of Jefferson, State of Ohio and being in VMS 3138, 4195 + 4604 and as delineated on the Plat, containing 8.74 acres in right of way and being 60 feet in width.

The undersigned certify that the attached plat correctly represents their dedication of right of way for MARMON ROAD to the County of Logan for use as a public road, the amount of land dedicated by each being shown by their signature

- |   |            |   |
|---|------------|---|
| <u>John W. Shoots</u>   | 6.12 Acres | Vol. 282, pg. 361<br>Vol. 291, pg. 606<br>Vol. 284 pg. 293<br>Vol. 290, pg. 332 |
| <u>Zelta M. Van Hyning</u>                                    | 1.16 Acres |   |
| <u>Leota M. Van Hyning, Executrix for James A. Van Hyning</u> | 1.15 Acres | Vol. 272 pg. 221  |
| <u>George H. Bibart, June P. Bibart (husband &amp; wife)</u>  | 0.28 Acres | Vol. 282, pg. 221   |
| <u>Curtis Black, Thelma Black (husband &amp; wife)</u>        | 0.03 Acres | Vol. 236, pg. 566   |
| <u>Paul Orsborn, Zelma Orsborn (husband &amp; wife)</u>       |            |   |

Scale: 1" = 100'

STATE OF OHIO }  
COUNTY OF LOGAN } SS Before me, a Notary Public, in and for said County, personally came the above named persons who acknowledged the signing of the foregoing instrument to be their voluntary act and deed for the uses and purposes therein expressed.

In witness whereof, I have here unto set my hand and affixed my Notarial Seal this 28 day of August, 1964.

Burton D. Pratt  
Notary Public, Logan County, Ohio  
my commission expires August 6-1969

Plat approved this 13<sup>th</sup> day of JUNE, 1966.  
Chester R. Kurtz  
COUNTY ENGINEER, LOGAN COUNTY, OHIO

Dedication approved and accepted this 13<sup>th</sup> day of JUNE, 1966.  
Harvey A. Ennill, William A. Tol, Don Downing  
COUNTY COMMISSIONERS, LOGAN COUNTY, OHIO

Filed this 15<sup>th</sup> day of June, 1966.  
Recorded this 17<sup>th</sup> day of June, 1966  
Plat Book E-6, Page 81.  
Ruth Loyer  
RECORDER, LOGAN COUNTY, OHIO

C. H. No. 291  
The road is hereby approved and accepted this \_\_\_ day of \_\_\_, 196\_\_.  
COUNTY ENGINEER, LOGAN COUNTY, OHIO

Surveyed and Platted by Bernard Hurst, Jr.  
Bernard Hurst, Jr.  
Registered Surveyor 4868  
Registered Engineer 26568

FB 708

C.R. 291 JEFFERSON TWP.

- "A" = R.R. SPR SET ON LINE "B-C-D"
- "B" = 3/4" PIPE FO (CEN. ALONG RD CURVE)
- "C" = 3/4" PIPE FO. (W. R/W @ P.T.)
- "D" = 3/4" PIPE FO. (E. R/W @ P.T.)
- "E" = 1"  $\phi$  SET
- "F" = 1"  $\phi$  SET ( $\Delta = 26^\circ 20.7' RT$ )
- "G" = 1"  $\phi$  SET
- "H" = 1"  $\phi$  SET


4029

INDEXED ON MAP

D. DODSON  
L. GEEGLIN  
C. NICHOLS

5/4/72  
5/5/72  
5/11/72 50°

26

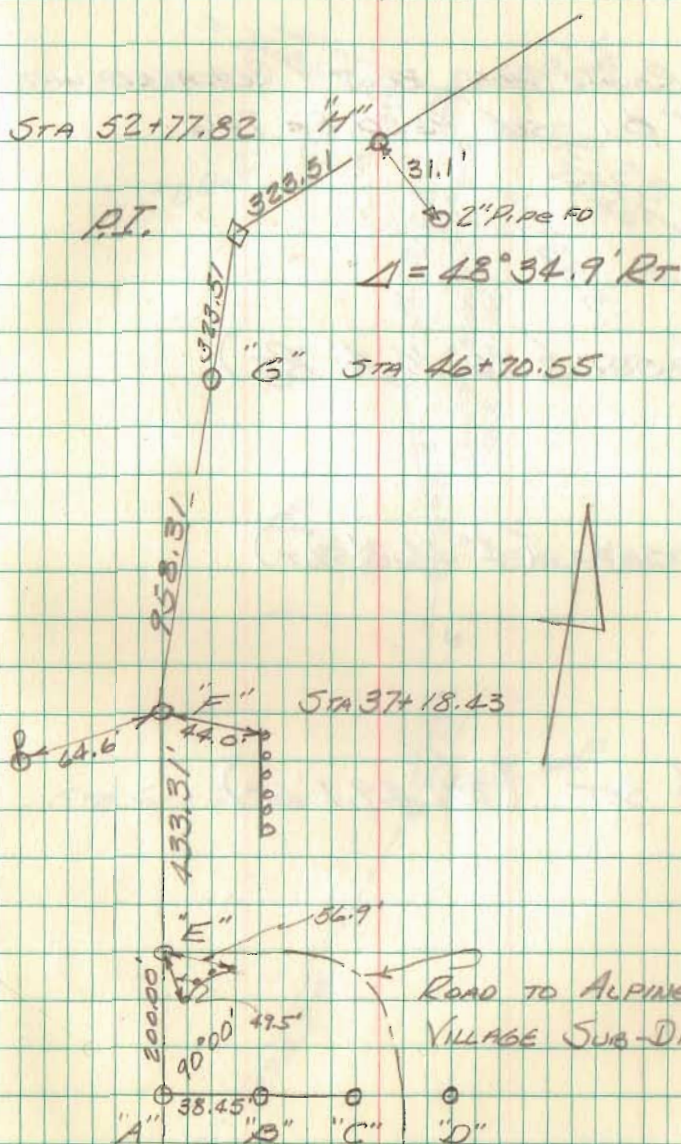

FB 708

C.R. 291 JEFFERSON TWP (cont)

FD ROUND HEAD BOLT / REPLACED WITH  
1"  $\phi$ . SEE PG 50 BK 706

1"  $\phi$  SET (10° 14.4' Rt)

1"  $\phi$  SET (4° 44.8' Lt)

1"  $\phi$  SET (29° 49.1' Lt)

"H"


D. DODSON  
L. GEESLIN  
C. NICHOLS

5/4/72

5/5/72

5/11/72

50°

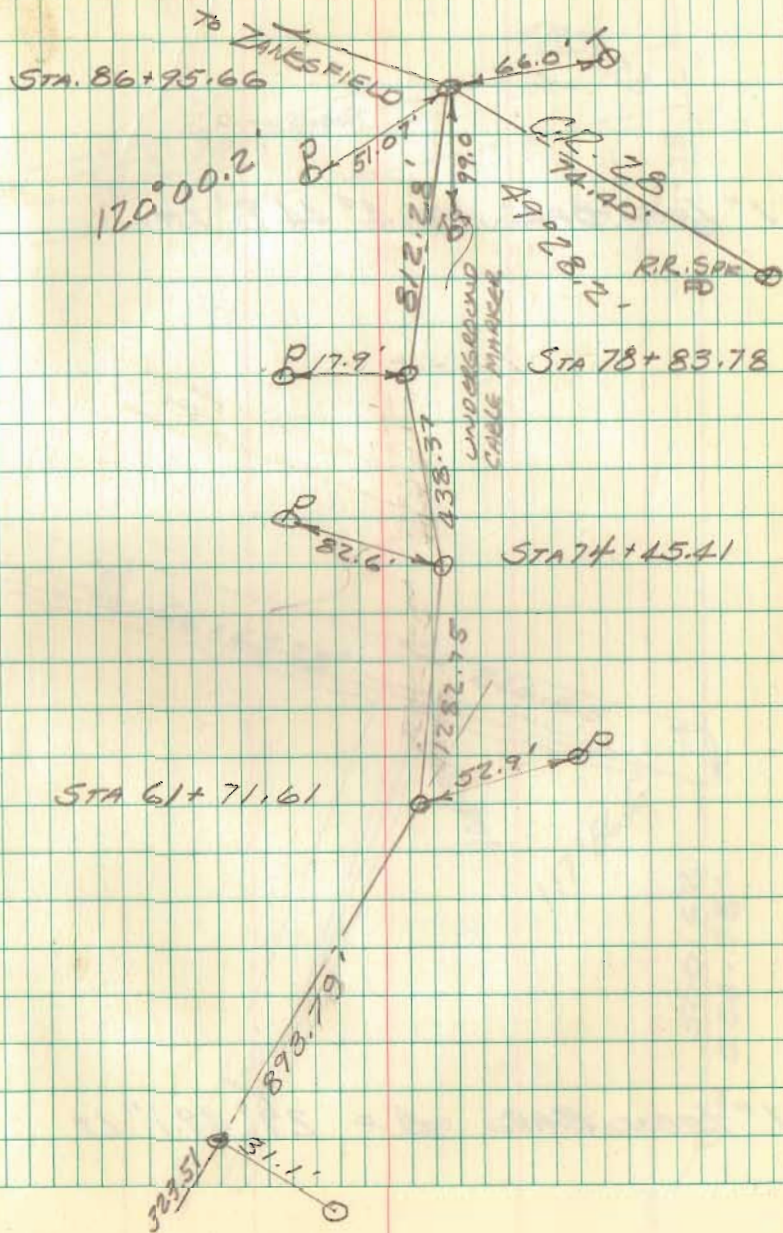

FB 708

C.R. 291 JEFFERSON TWP.

1" IRON BAR  $\Delta = 4^{\circ} 44.8' \text{ LT.}$

1" IRON BAR  $\Delta = 29^{\circ} 49.1' \text{ LT}$

L. GEESLIN  
C. NICHOLS

5/18/72

68°

28

