

GODWIN SURVEY
V.M.S. 6447
JEFFERSON TOWNSHIP

The following described real estate situated in Jefferson Township, Logan County, Ohio and being part of Virginia Military Survey 6447 and more particularly described as follows:

Beginning at an iron bar in the center of Jefferson Township Road No. 182 at the northeast corner of Eugene H. Godwin's 1.33 acre tract, said iron bar being Station 49+12.3 as shown in Logan County Engineer's field book 607, Page 42; thence with the center line of said road S. 55°37' E. 12.3 feet to an iron bar; thence with said centerline S. 63°56' E. 85.9 feet to an iron bar; thence with said centerline S. 73°42' E. 55.4 feet to an iron bar; thence S. 4°58' W. 270.0 feet to an iron bar; thence S. 89°45' W. 156.6 feet to an iron bar at the southeast corner of said E. H. Godwin's 1.33 acre tract; thence with said Godwin's east line N. 6°44' E. 327.4 feet to the place of beginning.


Containing 1.02 acres more or less.

The above described tract being part of Harold W. Godwin's 34.98 acre tract.

4147 ID

INDEXED ON MAP

Eugene H. Godwin
1.33 Ac.

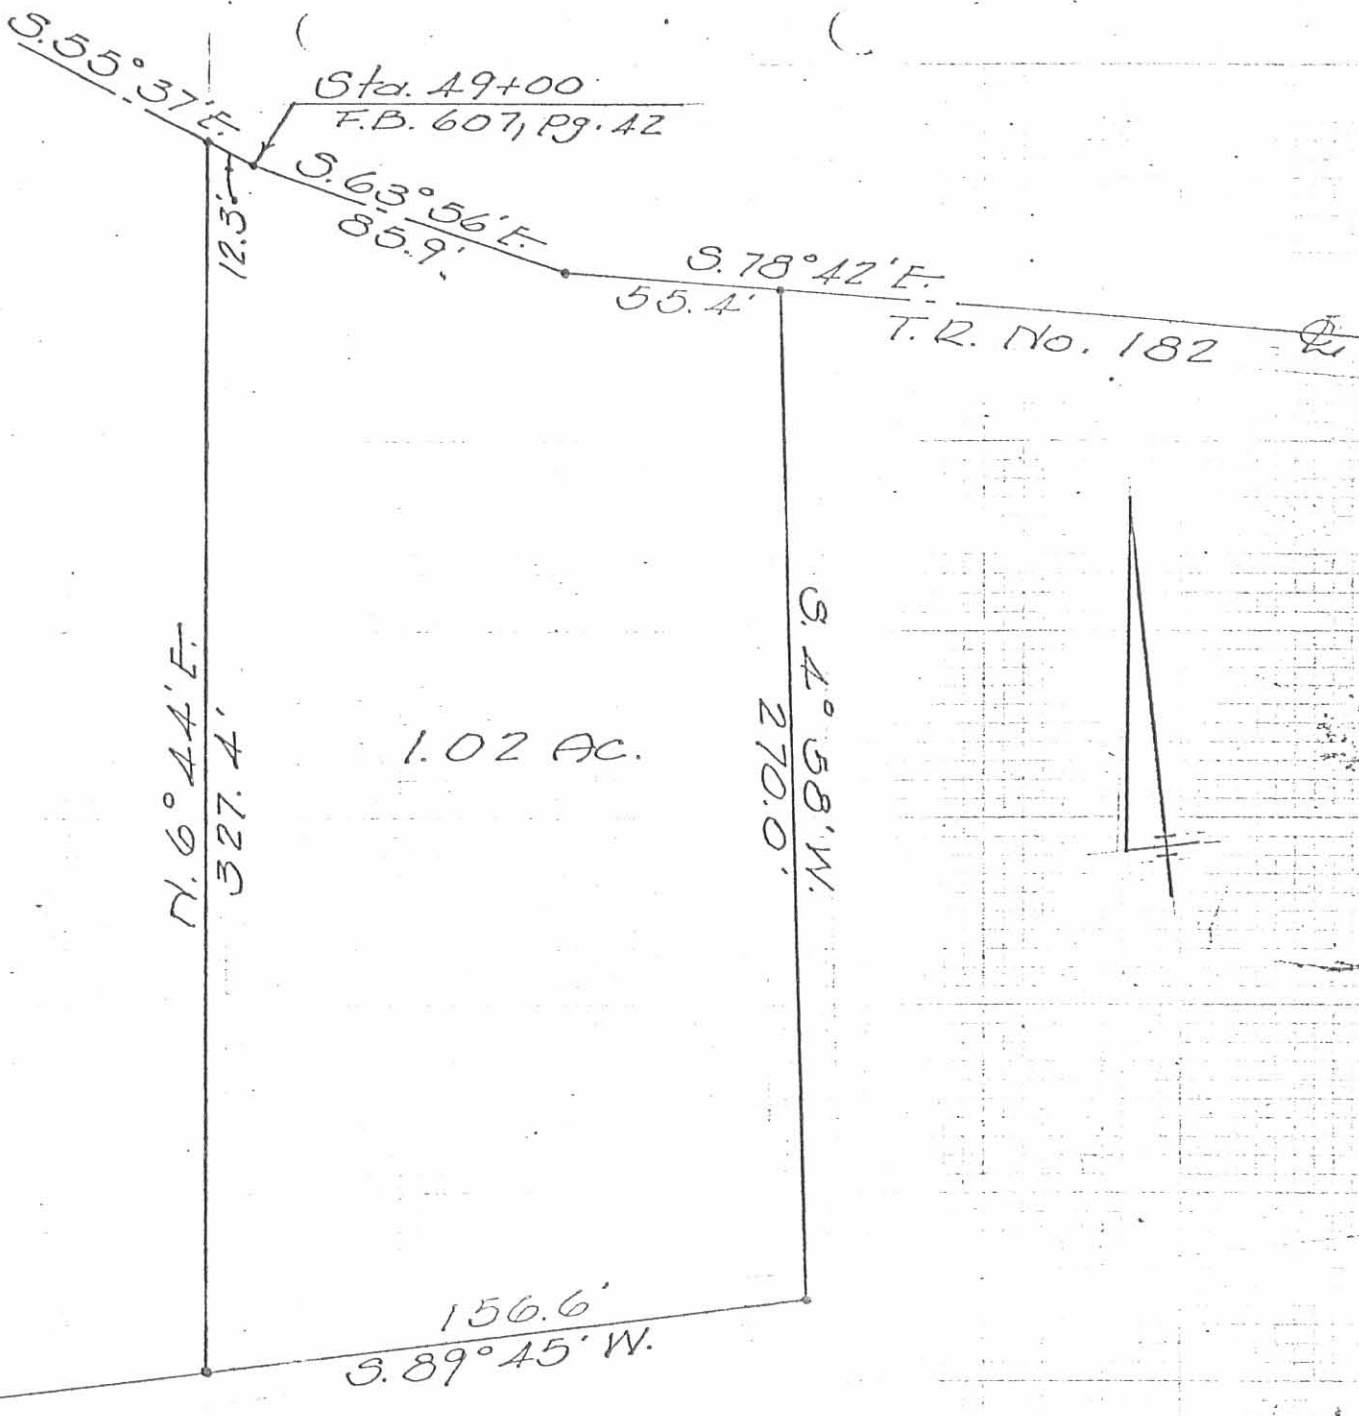

1.02 Ac.

GODWIN SURVEY
V.M.S. 6447
JEFFERSON TOWNSHIP
LOGAN COUNTY, OHIO
JUNE 15, 1967
SCALE 1"=50'

• = Iron Bar

4147 IP

INDEXED ON MAP

Dan L. Dodson
Reg. Surveyor 4270
Bellefontaine, Ohio

GODWIN SURVEY


179.20
18.20
16.912

146.24	
117.11	
263.35	559.60
	263.35
	962.5

DODSON
ARTIS

6/15/47
90°

57

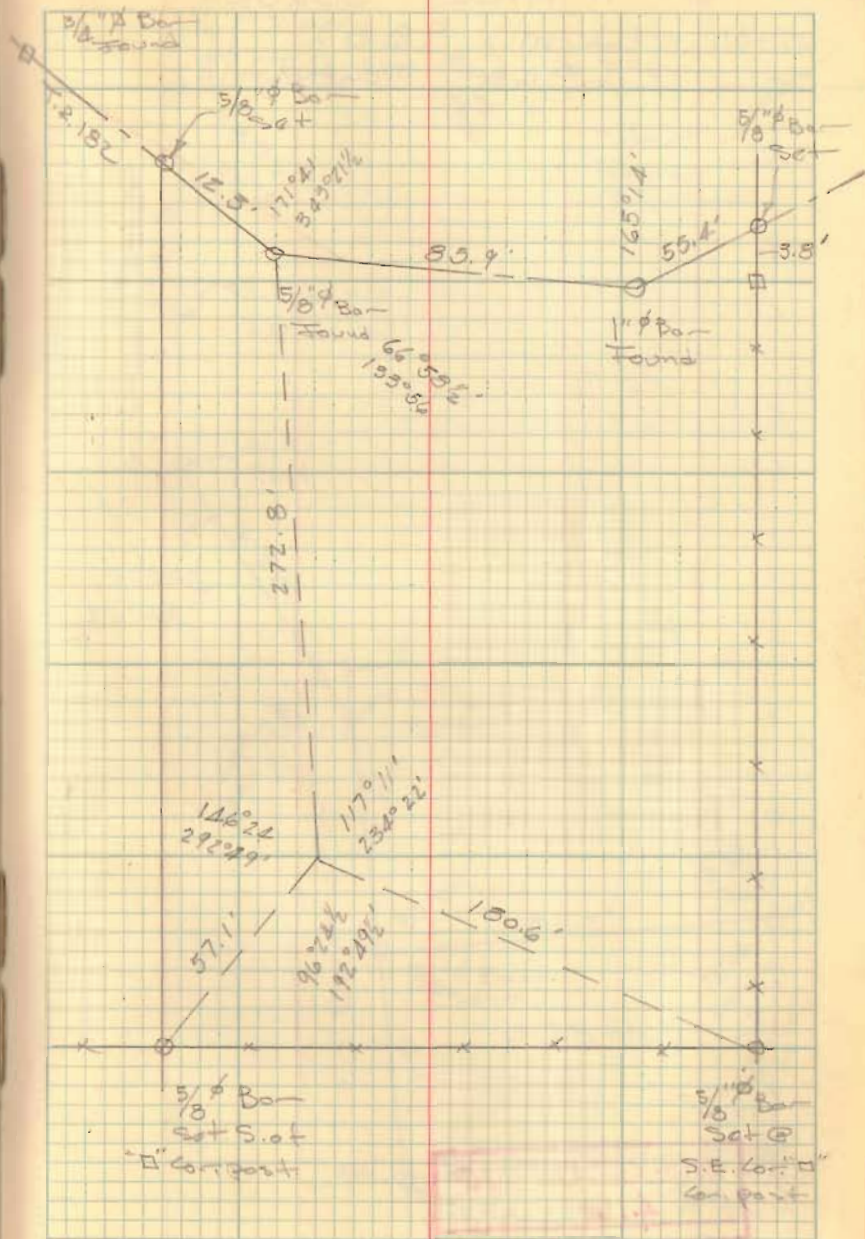

INDEXED ON MAP
4147