


12th Mo. Dec 17th 1825

Survey No 50

8194

I made a division of survey No 9949 north of the green river
 treaty line, for James Caldwell and James Frazer, of Virginia.
 Beginning at a stake in
 the south line of the sur-
 vey 199 poles from either
 corner thence N 75° 11' 40"
 poles to 2 beeches in the
 north line of the survey
 dividing it into 2 equal
 parcels

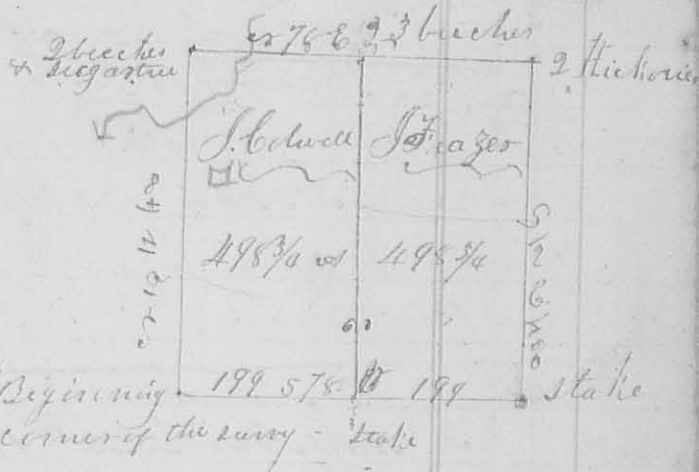

James Bowyer }
 William Bowyer } (Ck.)


James McMillan Surveyor

1^{mo} (Jan) 3rd 1826

Survey No 51

8195

Surveyed 6 1/2 acres of land for Andrew Willson - Begin-
 ning at a buck, ironwood, and sugar tree in the south
 line of William Cochran's Survey No 3236. Thence N 87° 17' 50" poles
 to 3 beeches, corner between said Willson and Burnside, thence
 N 77° E 127 poles to a poplar and
 2 beeches in the east line of
 said survey, and on the bank
 of a branch of Mill Creek
 thence with said line S 10° E

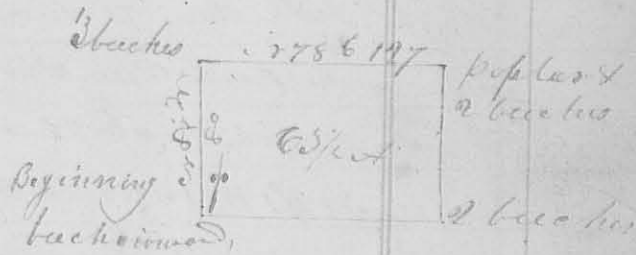

80 poles to 2 beeches, an original corner of the survey
 thence with the original line S 79° W 128 poles to the
 beginning containing sixty three & half acres in the
 S.E. corner of Cochran's said survey James McMillan S.S.C.

1^{mo} (Jan) 14th 1826

Survey No 52

8188

Surveyed 4 1/2 acres of land for Obenizar Jane. Beginning at
 a large sugar tree, S.E. corner to John Bishop's land, thence
 with the south line of his land N 75° 11' 45" poles
 to a stake on the east side of the Sandusky road
 thence S 8° 11' 25.5" poles to a stake on the same side of
 said road thence S 75° E 75 poles to a stake, thence N 46°