

Compared


Surveyed for
J. W. Harmon

Pt. S.W. Qr. Section 34, Town 4, Range 14
Lake Township

Apr. 10, 1907.

(151)

NUMBER OF FEET

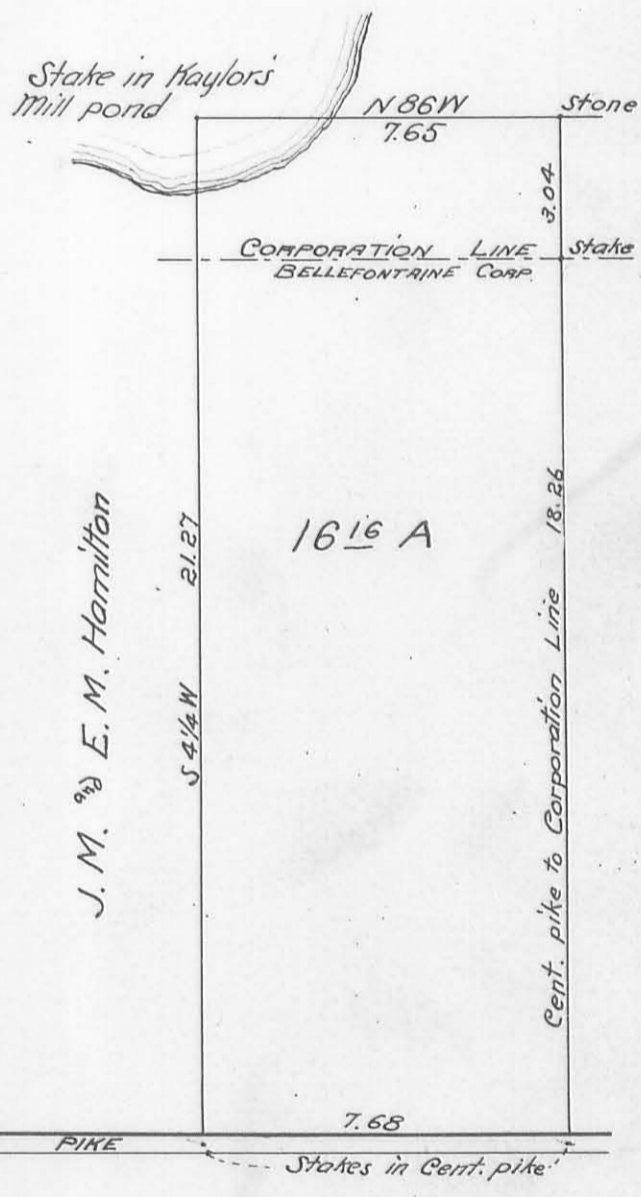

Ira Hankinson
Claud Kaylor ch. Crs.

S 86 E 20.22
SILVER LAKE PIKE 7.68

Stake at S.W. corner of Section No. 34
Wit: - Forked Apple tree S 28 E, 55 lks.

Stakes in Cent. pike