

ROAD # 185  
LAKE TOWNSHIP


PRESENT FENCES ARE 35'  
APART AT W. END 33 AT E. END

STAKES WERE NOT SET  
MEASUREMENTS WERE TAKEN  
ALSO LAND LINES MARKED

1348  
INDEXED ON MAP

8-27-29


McKunahan 23  
Liggitt

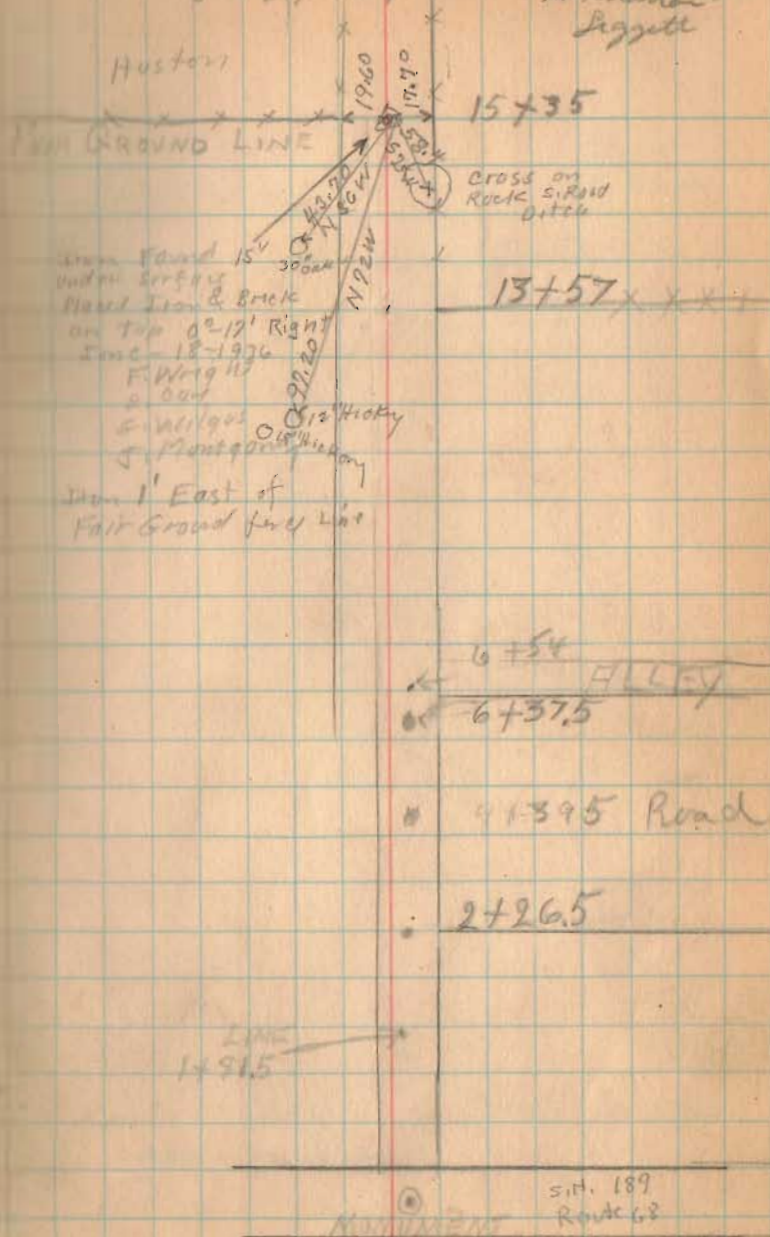

8-27-29

G. Wilgus  
M. Jones

24

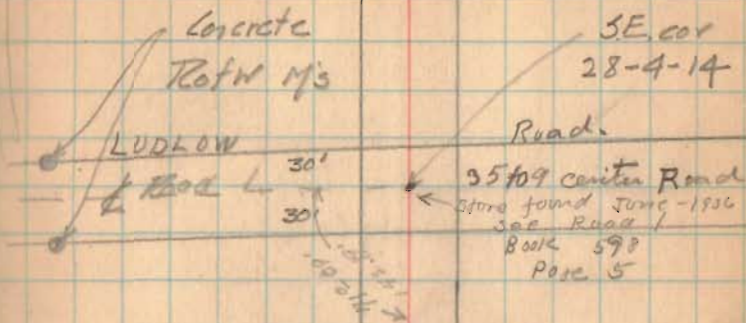

Road 18'

12471 LAND LINE

Store (found)  
corner to 27,  
28, 33, 39 - 4-14

INDEXED ON MAP

STA 15436.09  
SEE ANNOTATION  
# 3260