

Road. 216
Lake and Harrison Twp's


35' - Road Record No. 3 Page 104
109

1667
INDEXED ON MAP

Road 200

July - 12 - 1935
cloudy
E. core 26

W. E.

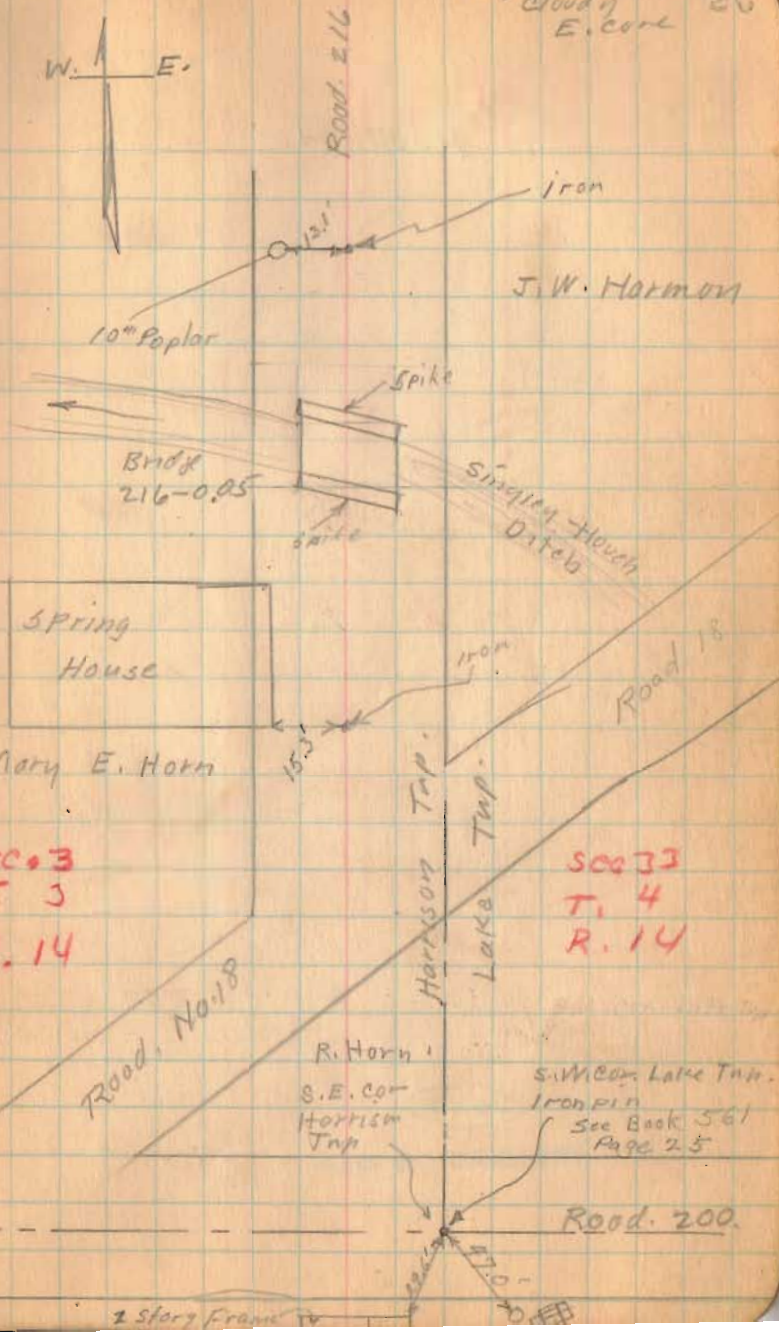

Sec. 3
T. 3
R. 14

Sec. 3
T. 4
R. 14

Road. 216

A. J. Detrick.

steel post
x x x
clarence Kerr.

36.2'

Harrison Twp.

Lake Twp.

2' post
Rail Fence
Stone
30" History

J. W. Harmon

17.5' x 17.5'

North
N 6° E

1667

INDEXED ON MAP

7-12-35 27