


Trail - Woodland Subd

R/W
Mon
P.T.

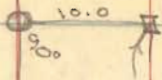

529.8
138.0

391.2
185.0

206.2

529.0'

10.0

006

160.0'

$R = 100.00$
 $T = 61.88$
 $\Delta = 63^{\circ}30'$

63°30'

100.0'

175.6


10.0'

117235-30
(235-11)


263.0'

114°24'
(120°+10')

R/W
Mon

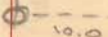

180
08
18 20

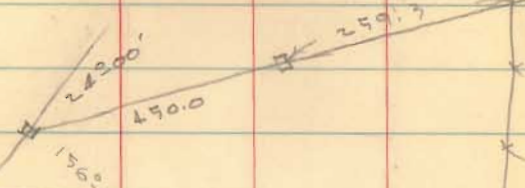

$\Delta = 242.00$
 $R = 100.00$
 $T = 85.02$

117-35
235-10



88°32'
(178-04')

464.1'

312'


179-60
88-32

91-28

1-20

INDEXED MAP
2607

WOODLAND

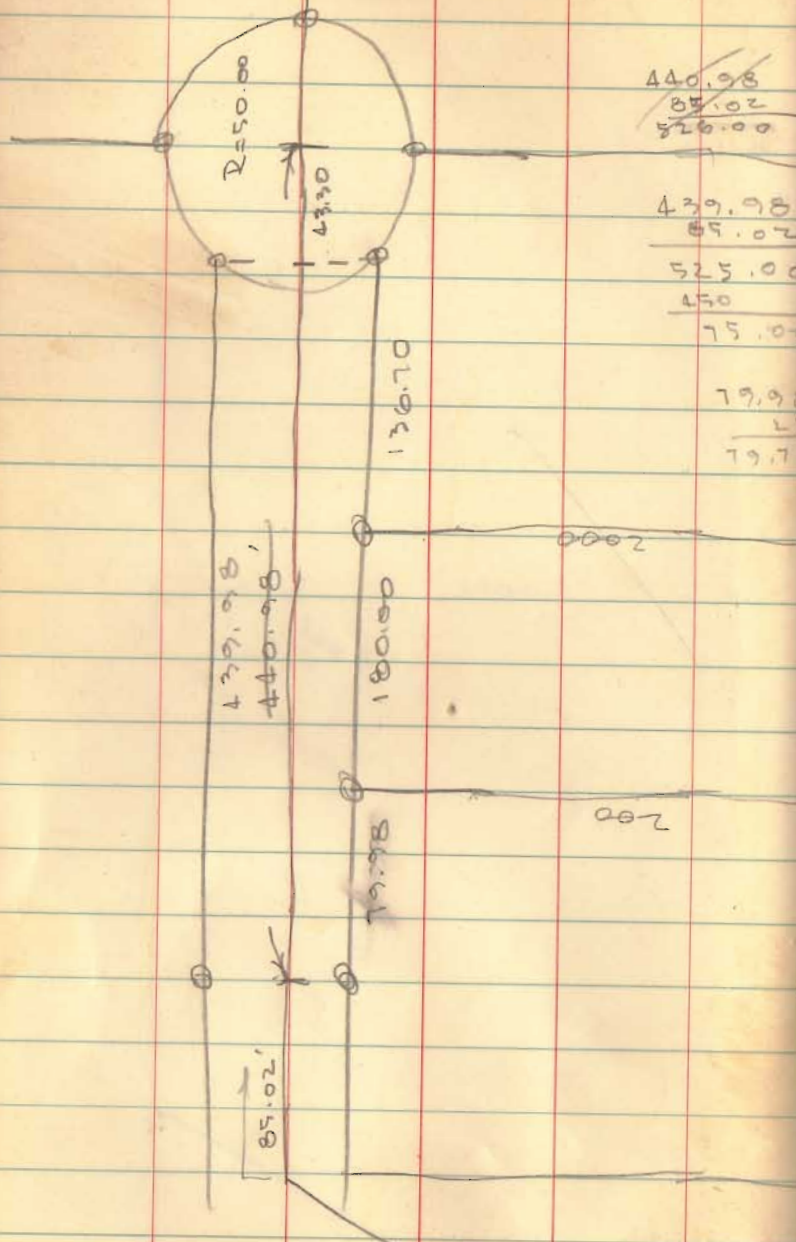

~~440.98~~
~~85.02~~
~~526.00~~

439.98
 85.02

525.00


450

75.00

79.98

25

79.73

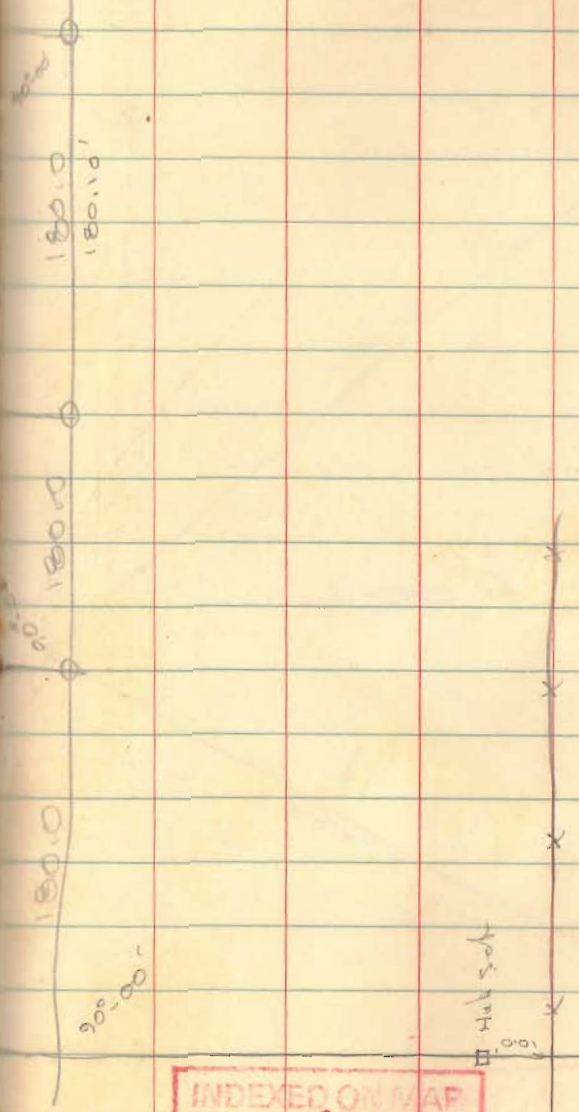

INDEXED ON MAP
 2607