



Midway Avenue Water Line, Lakeview, O.

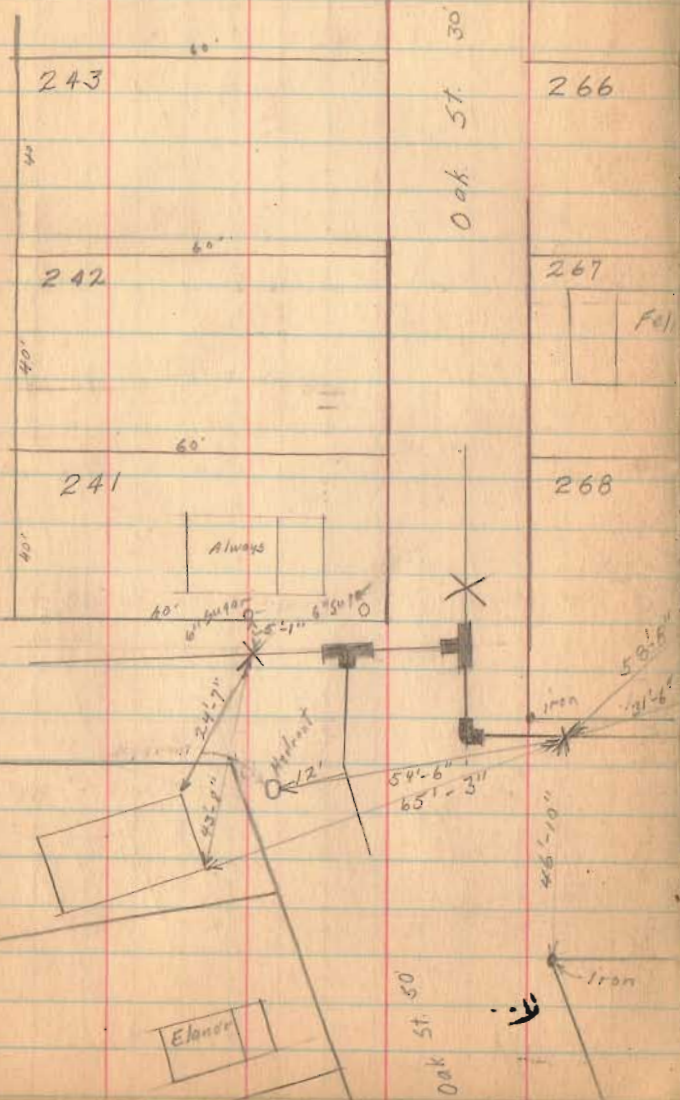

April 25, 1935 41
E.K. Corc

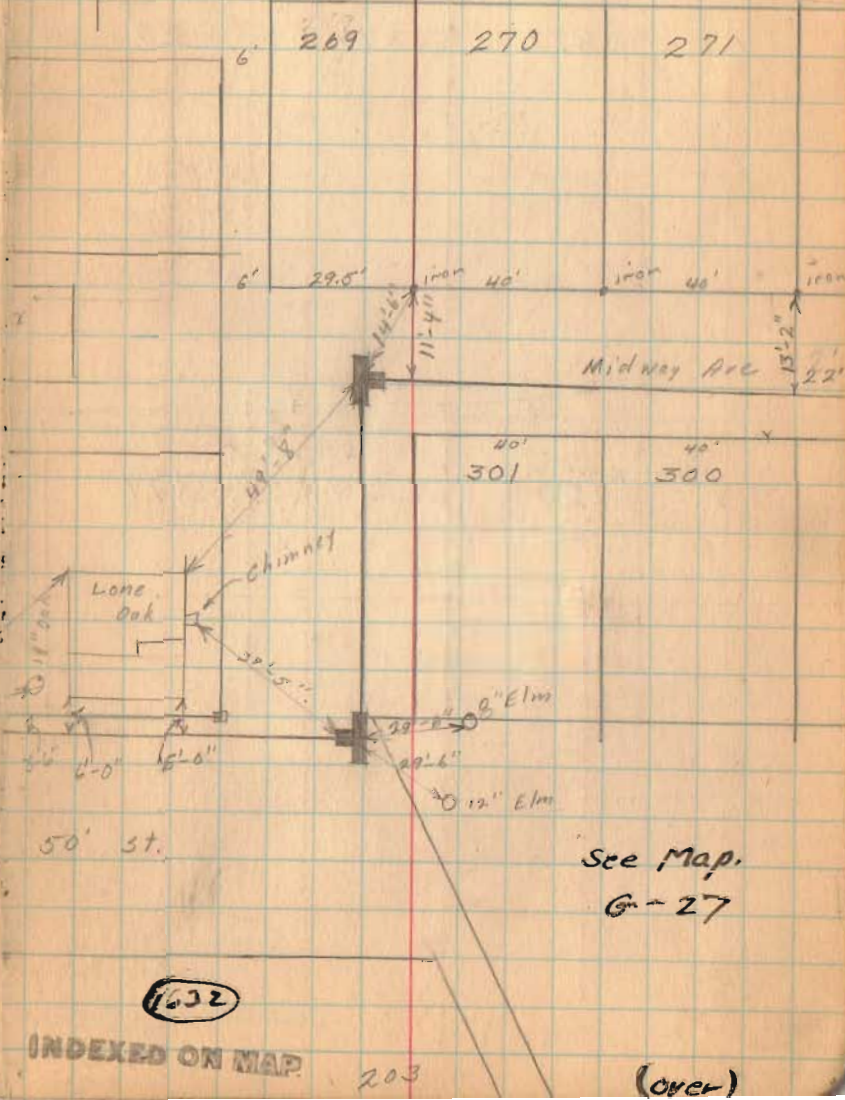

See Map.
G-27

(632)


INDEXED ON MAP

203

(over)

Midway Avenue Water Line, Lakewood, Ohio

April 26, 1935
E. K. Carr 42

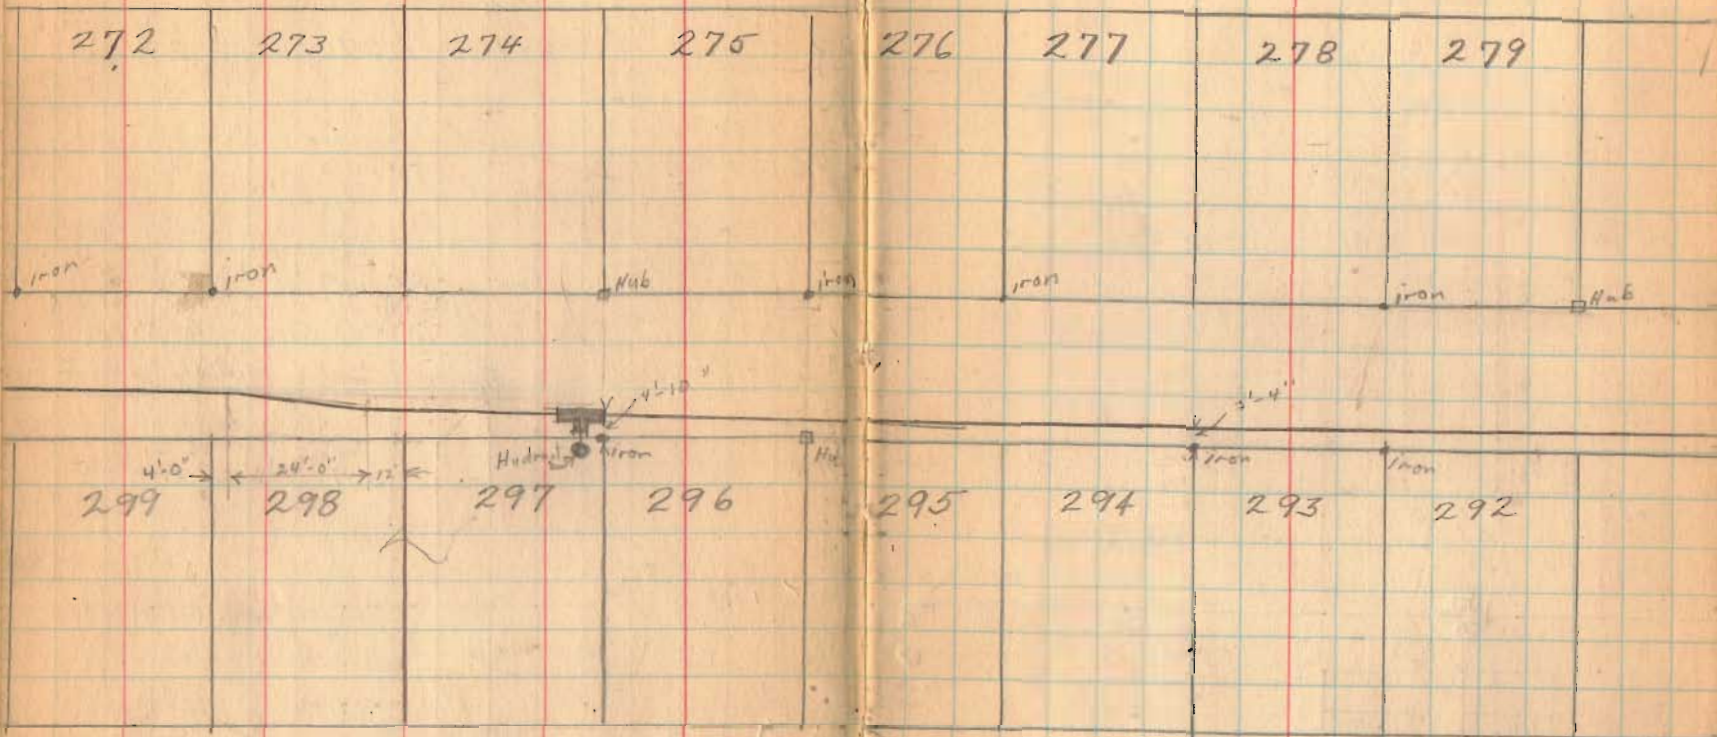



1632

INDEXED ON MAP


(over)

Midway Arc Water Line Lake v 12W

280 281 282 283 284 285

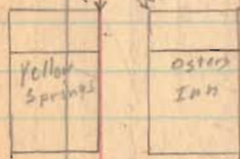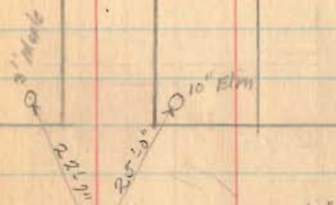

291 290 289 288

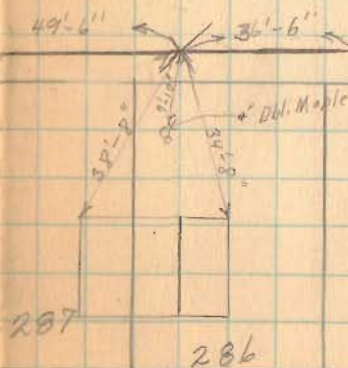

287 286

1652

INDEXED ON MAP