


CLAIR A. INSKEEP
 CIVIL ENGINEER
 INSKEEP BLOCK
 BELLEFONTAINE, OHIO
 Horth.

stabler Sury.
 Lake View

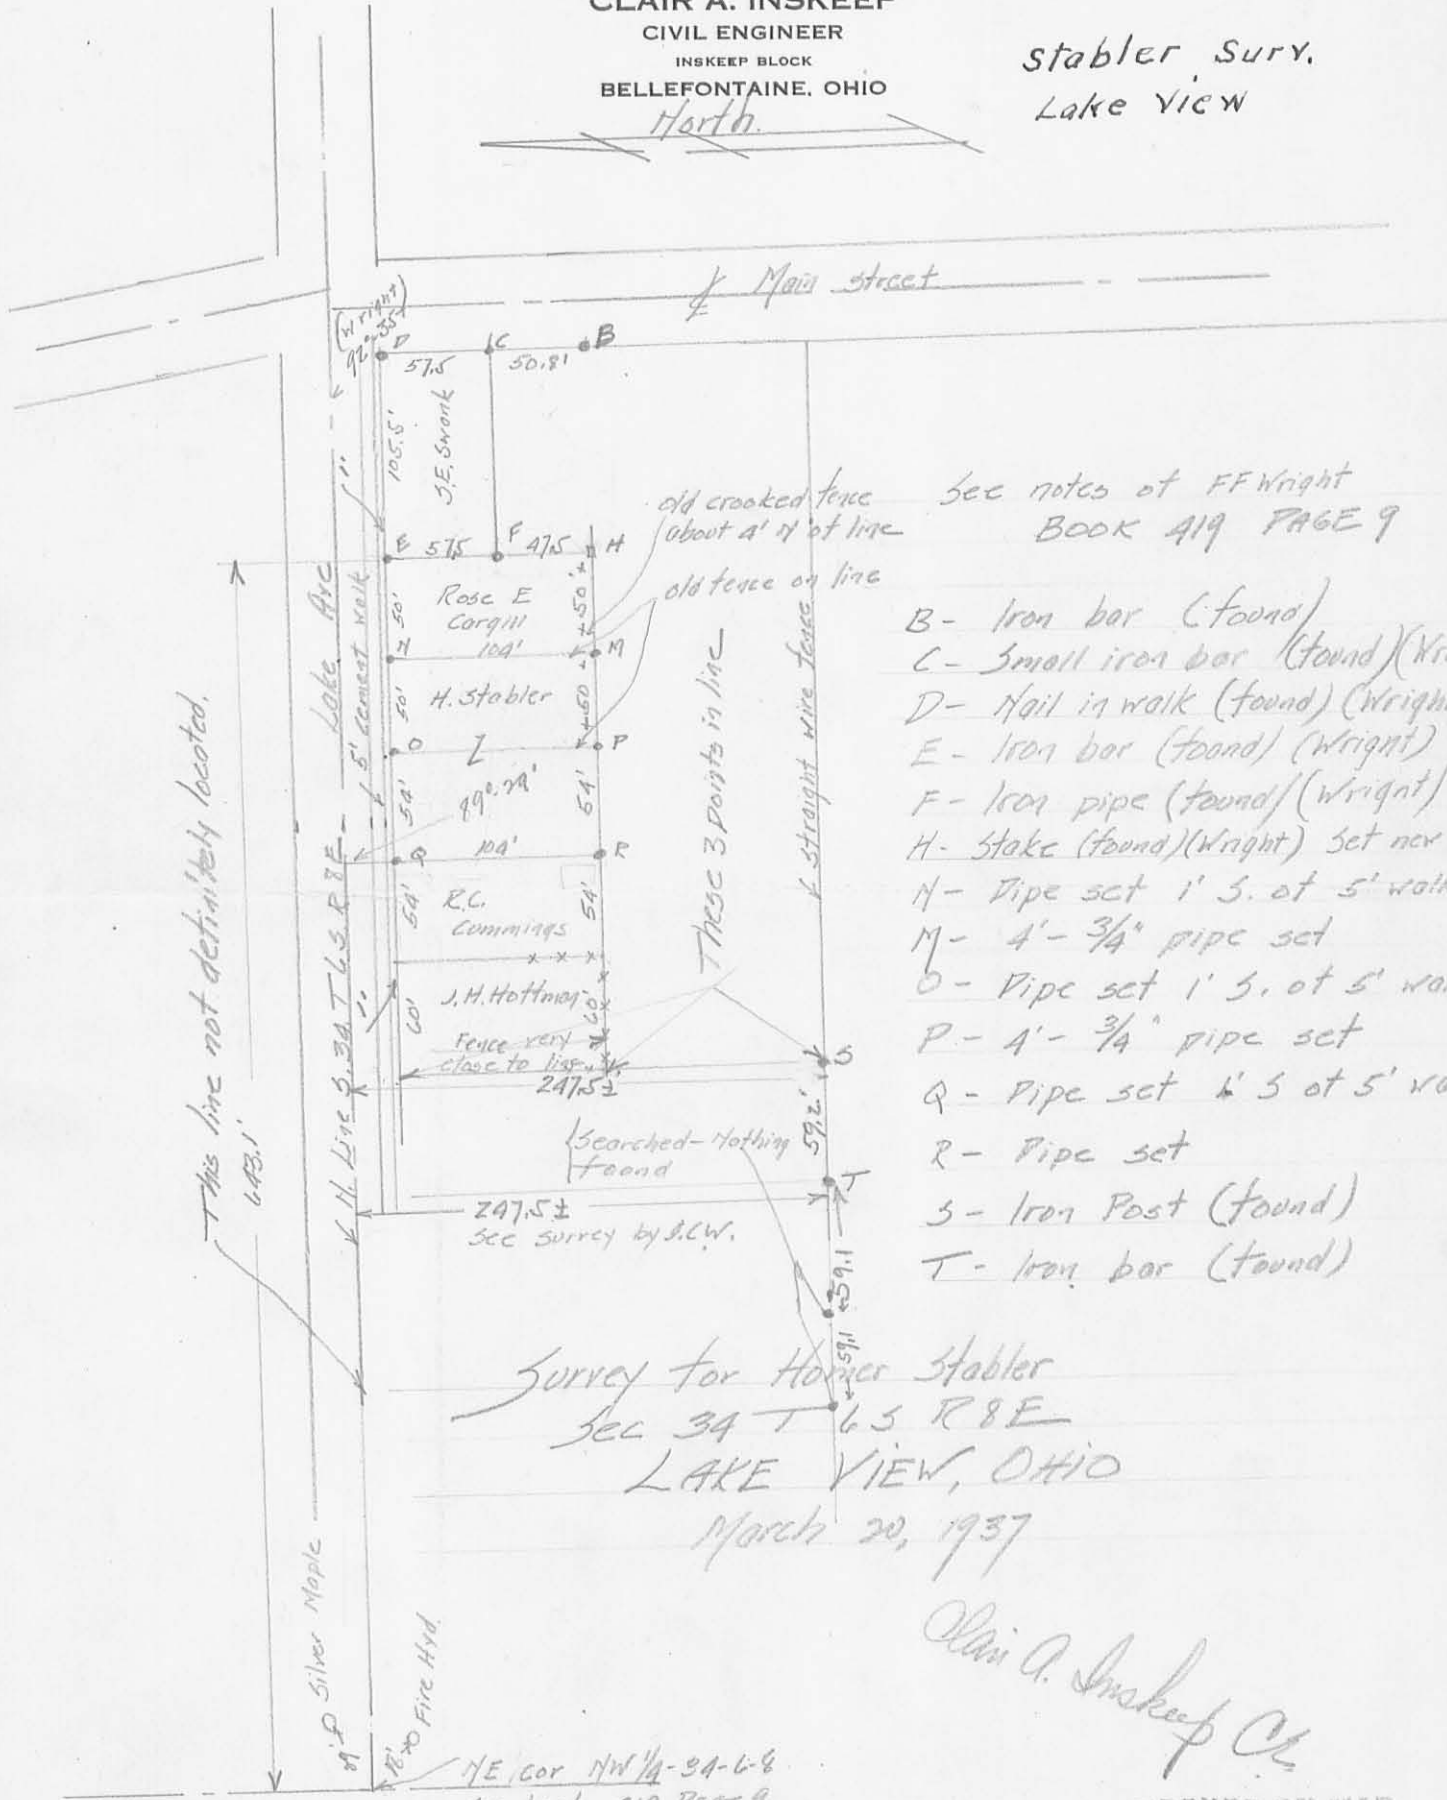

See notes of FF Wright
 BOOK 419 PAGE 9

- B - Iron bar (found)
- C - Small iron bar (found) (Wright)
- D - Nail in walk (found) (Wright)
- E - Iron bar (found) (Wright)
- F - Iron pipe (found) (Wright)
- H - Stake (found) (Wright) Set near stake
- M - Pipe set 1' 5" of 5' walk
- N - 4' - 3/4" pipe set
- O - Pipe set 1' 5" of 5' walk
- P - 4' - 3/4" pipe set
- Q - Pipe set 1' 5" of 5' walk
- R - Pipe set
- S - Iron Post (found)
- T - Iron bar (found)

This line not definitely located.

Survey for Homer Stabler
 Sec 34 T 6 S R 8 E
 LAKE VIEW, OHIO
 March 20, 1937

Clair A. Inskeep

NE cor NW 1/4 - 34-6-8
 See book 419 Page 9
 Not found. Located
 by witnesses only
 St. wire fence on line to it.

INDEXED ON MAP
 Indexed on MAP
 1774 IP