


Note: The distances on the North South lot Lines are calculated distances excepting the West Line of OAK ST.

- ⊗ - Chiseled Cross on Conc.
- - Iron Pin Set
- - Iron Pin Existing

INDEXED ON MAP
 2136 IP
 INDEXED ON MAP

Survey for
 THE FARMERS BANK
 Lakeview, Ohio
 H. H. Lewis CE2662
 April 1955

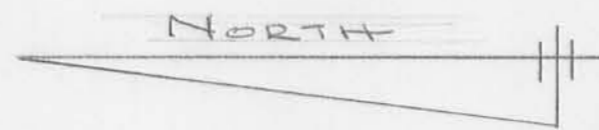

OAK STREET 40'

93.15 93.94 93.72 93.62 93.59 93.65 93.79 94.05 94.29 94.11 94.14

15" SANITARY @ 0.12%

6" WATER LINE

SURFACE INLET
FL GRATE 993.00

4" CONC. WALK


LOT LINE 2

BENCH MARK

CHISELED + ON CONC
WALK FOUND

M.H. 396
TOP = 993.1
INVERT 983.3

24" MAPLE

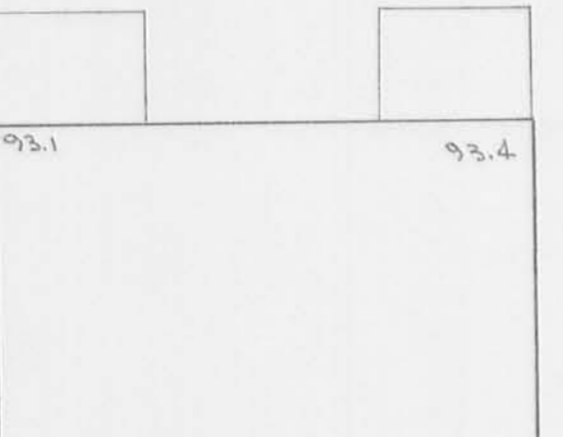

LOT No. 4

2 STORY
BRICK BUILDING

CONC. SLAB

FOUNDATION ONLY

SURVEY OF
LOT 3 & LOT 4
LAKEVIEW, OHIO
FOR
FARMERS BANKING CO
AUGUST 30, 1914
SCALE 1"=10'

BENCH MARK (U.S.G.S. DATUM)
CHISELED + ON CONC. WALK @ S.E.
COR. LOT No. 4
ELEV. 994.00

NAIL SET

8" CONC. WALL

LOT LINE

CHISELED + ON
CONC. WALK FND.

SURFACE INLET
FL GRATE 992.87

ASPHALT CONC. PARKING AREA

LOT No. 3

BRICK BANK BUILDING

- W.M. = WATER METER
- G.M. = GAS METER
- ⊕ = POWER POLE
- ⊙ = FIRE HYDRANT
- X = WATER VALVE

3/8" Bar
FOUND

8" CONC. BLOCK WALL

LOT LINE

12" CONC. WALK

LAKE AVE 50'

6" WATER LINE

DAV L. DOBSON
REG. SURVEYOR 4270
BELLEFONTAINE, O.