

Survey of Harrison St. Extension,
for

Village of Lake View Ohio

Job No 108

S 34 T 6 S R 8 E


Stations measured E along N prop line from

0+00	Intersection of N Line of Wise Co 4 Co L ³⁴
0+36	30' oak 3' R
+77.5	8' mulberry 2' R Measured to
+95	12' hickory 2' R center of trees
1+20	24' oak 1' R
1+30	36' maple 11' R
1+42	west line Mueller house 39' L
1+46	west line Wise house 36' R
1+49	Mueller W.C. 12' L (W edge)
2+29	Wise W.C. 6' R 8'x4' (W edge)
2+29	W.C. 4' L 4'x4' (W edge)
2+39	8' oak 3' L
+42	12' oak 3' R
+42	W.C. 4' L 8'x4' (W edge)
+70	12' elm 6' R
+70	11' white walnut 5' L
+83	10' " " 6' L
9+00	west line of cottage 7' R
+77	6" white walnut on line
+24	west edge of cottage 13' L

C. Hyskeep
F. L. Marshall
Robt. Hughes

5/24/07

State Title

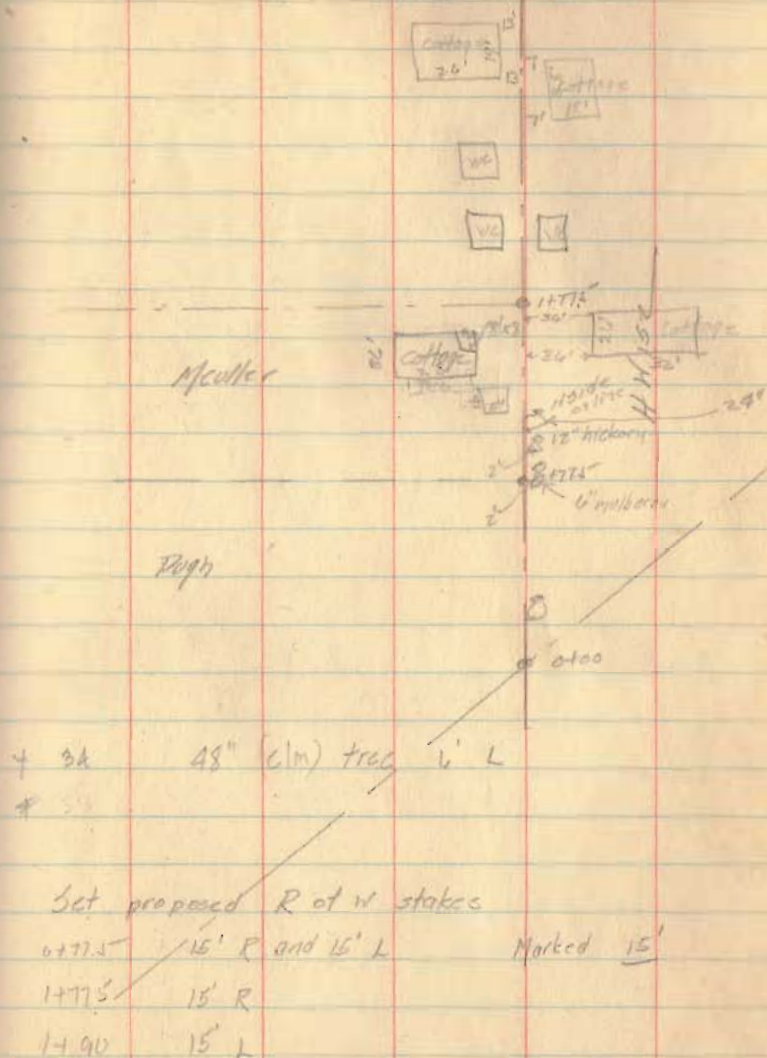

Job No
4 of Harrison St Xing

B6
tangent
1/4" to

1024	341+85.9	340	1° 10'	342
			1° 15'	
			341+79	
			1° 07'	
			340+53	
			0° 31'	
			340+75	
			0° 28'	

CA Myskeop
FL Howell
Robt Wagner

5/27/07

150

43.3
983.3

1121.6

279.4

42
321.4

Proposed
RatW line
see page 152

