

JOSEPH C. BRUBAKER SURVEY


The following described real estate situated in the Village of Lakeview, Section 34, Town 6 South, Range 8 East, Stokes Township, Logan County, Ohio and more particularly described as follows:

Commence at the intersection of Main Street and Lake Street and in the north line of said Section 34, thence with the center of Main Street S. 2° 41' E. 320.5 feet for the place of beginning of this description, thence continuing with Main Street S. 2° 41' E. 55.0 feet, thence West 175.0 feet to an iron pin, passing an iron pipe at 25.0 feet, thence N. 2° 41' W. 55.0 feet to an iron pipe, thence East 175.0 feet to the place of beginning passing an iron pipe at 150.0 feet containing 0.22 acre.

This tract includes a 0.19 acre tract and 0.03 acre from a 0.10 acre tract of Joseph C. Brubaker.

3186 1D

INDEXED ON MAP

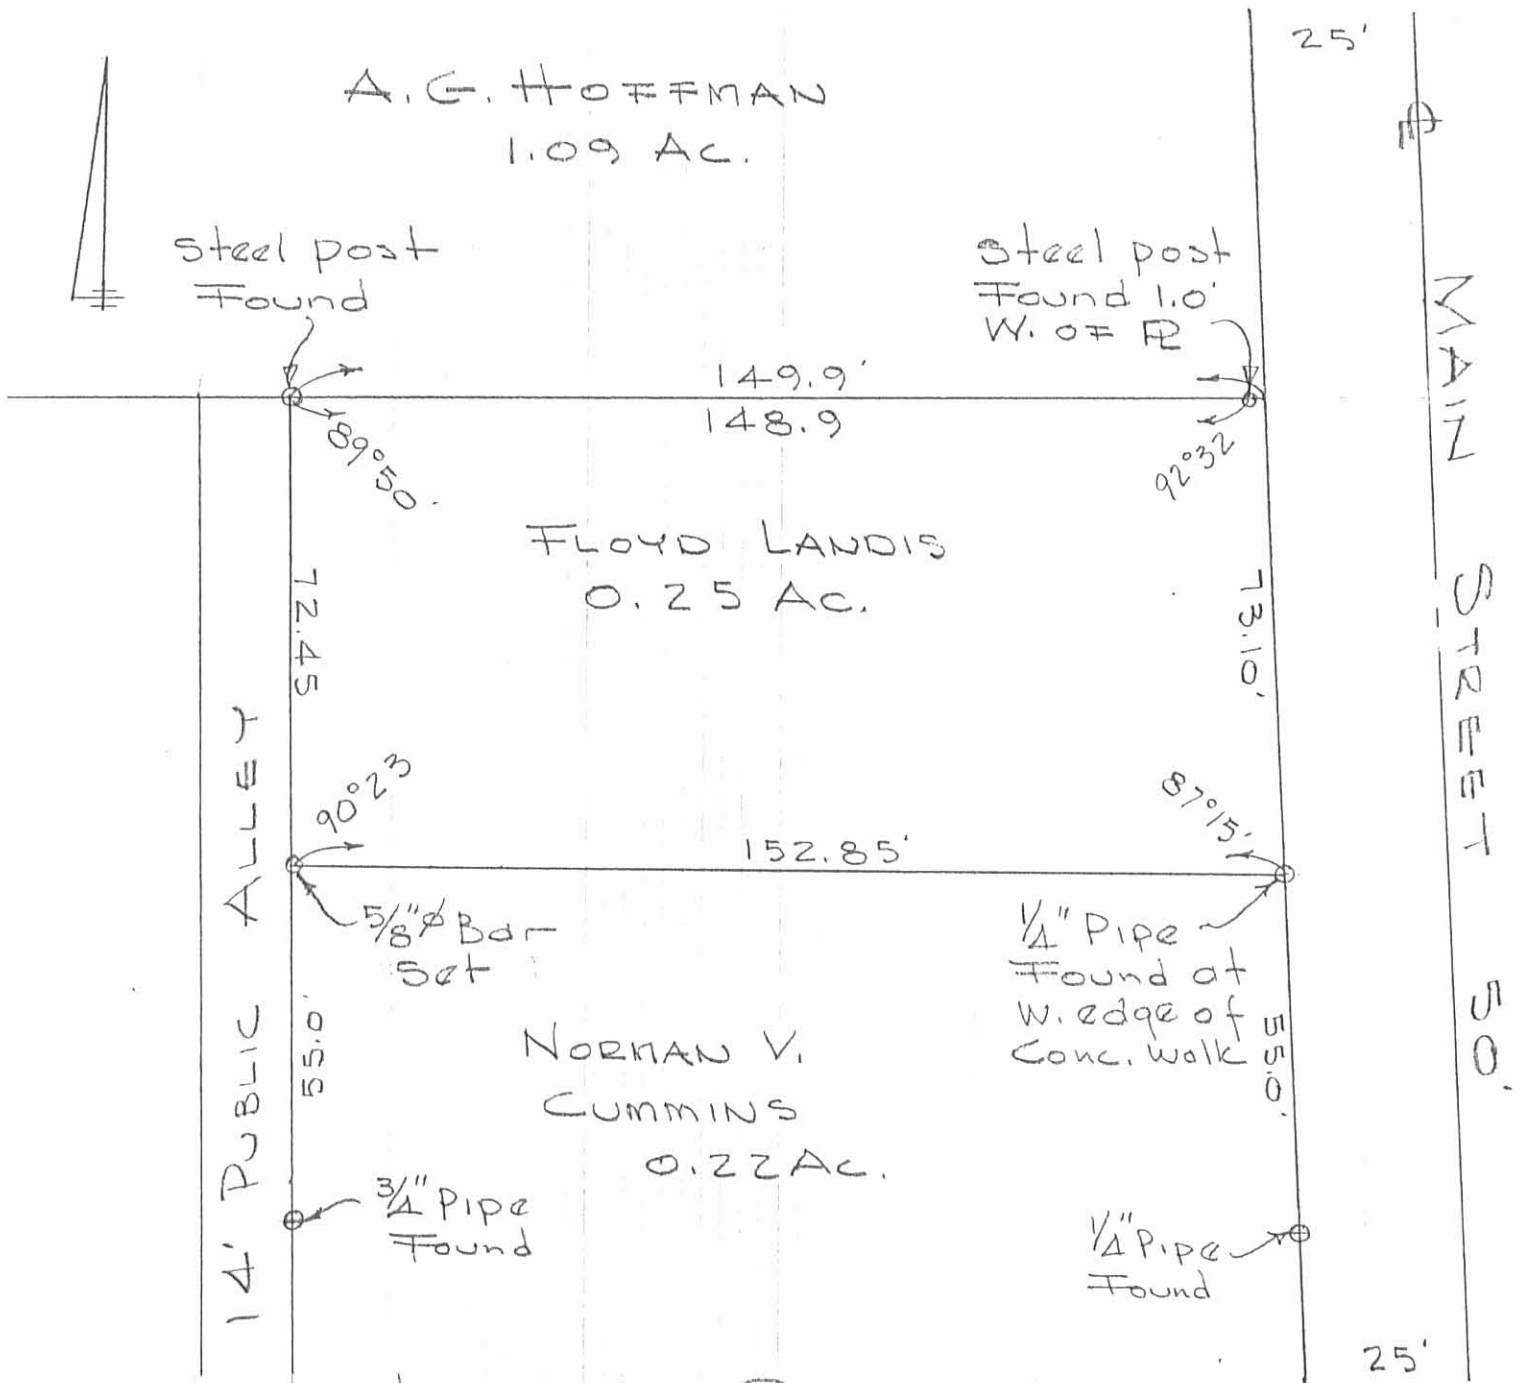

LANDIS SURVEY  
SEC. 34 T-6S. R-8E  
LAKEVIEW, OHIO  
APRIL 18, 1970  
SCALE 1" = 30'

REFERENCE:

F.B. 390 PG. 51  
INSKEEK 8 PG. 46  
Deed Vol. 329, PG. 612

INDEXED ON MAP  
3186 2P

DAN L. DODSON  
REG. SURVEYOR 4270  
BELLEFONTAINE, O.

LANDIS SURVEY  
LAKEVIEW, OHIO



- A = old steel post Found @ edge of low slab
- B " " " "
- C =  $\frac{3}{8}$ " Bar Set
- D =  $\frac{3}{4}$ " Pipe Found
- E =  $\frac{1}{2}$ " " "
- F =  $\frac{1}{2}$ " " "
- G  $\frac{1}{2}$ " Pipe & Hub Found
- H  $\frac{1}{4}$ " Pipe Found
- I  $\frac{1}{4}$ " Pipe Found

See Bk 3 pg. 6  
Inskoop Bk 8 pg 46  
F.B. 390 pg 51

INDEXED ON MAP  
3186

Dodson  
Antis

4/13/70  
70°

41

