

LOTS 364 & 365 NICHALSONS FAIRVIEW ALLOT.


LAKEVIEW, OHIO

STOKES TOWNSHIP, LOGAN COUNTY

SECTION 34 T.6S.; R.8E. SCALE: 1" = 30'

MAY, 1970

UNION ST.

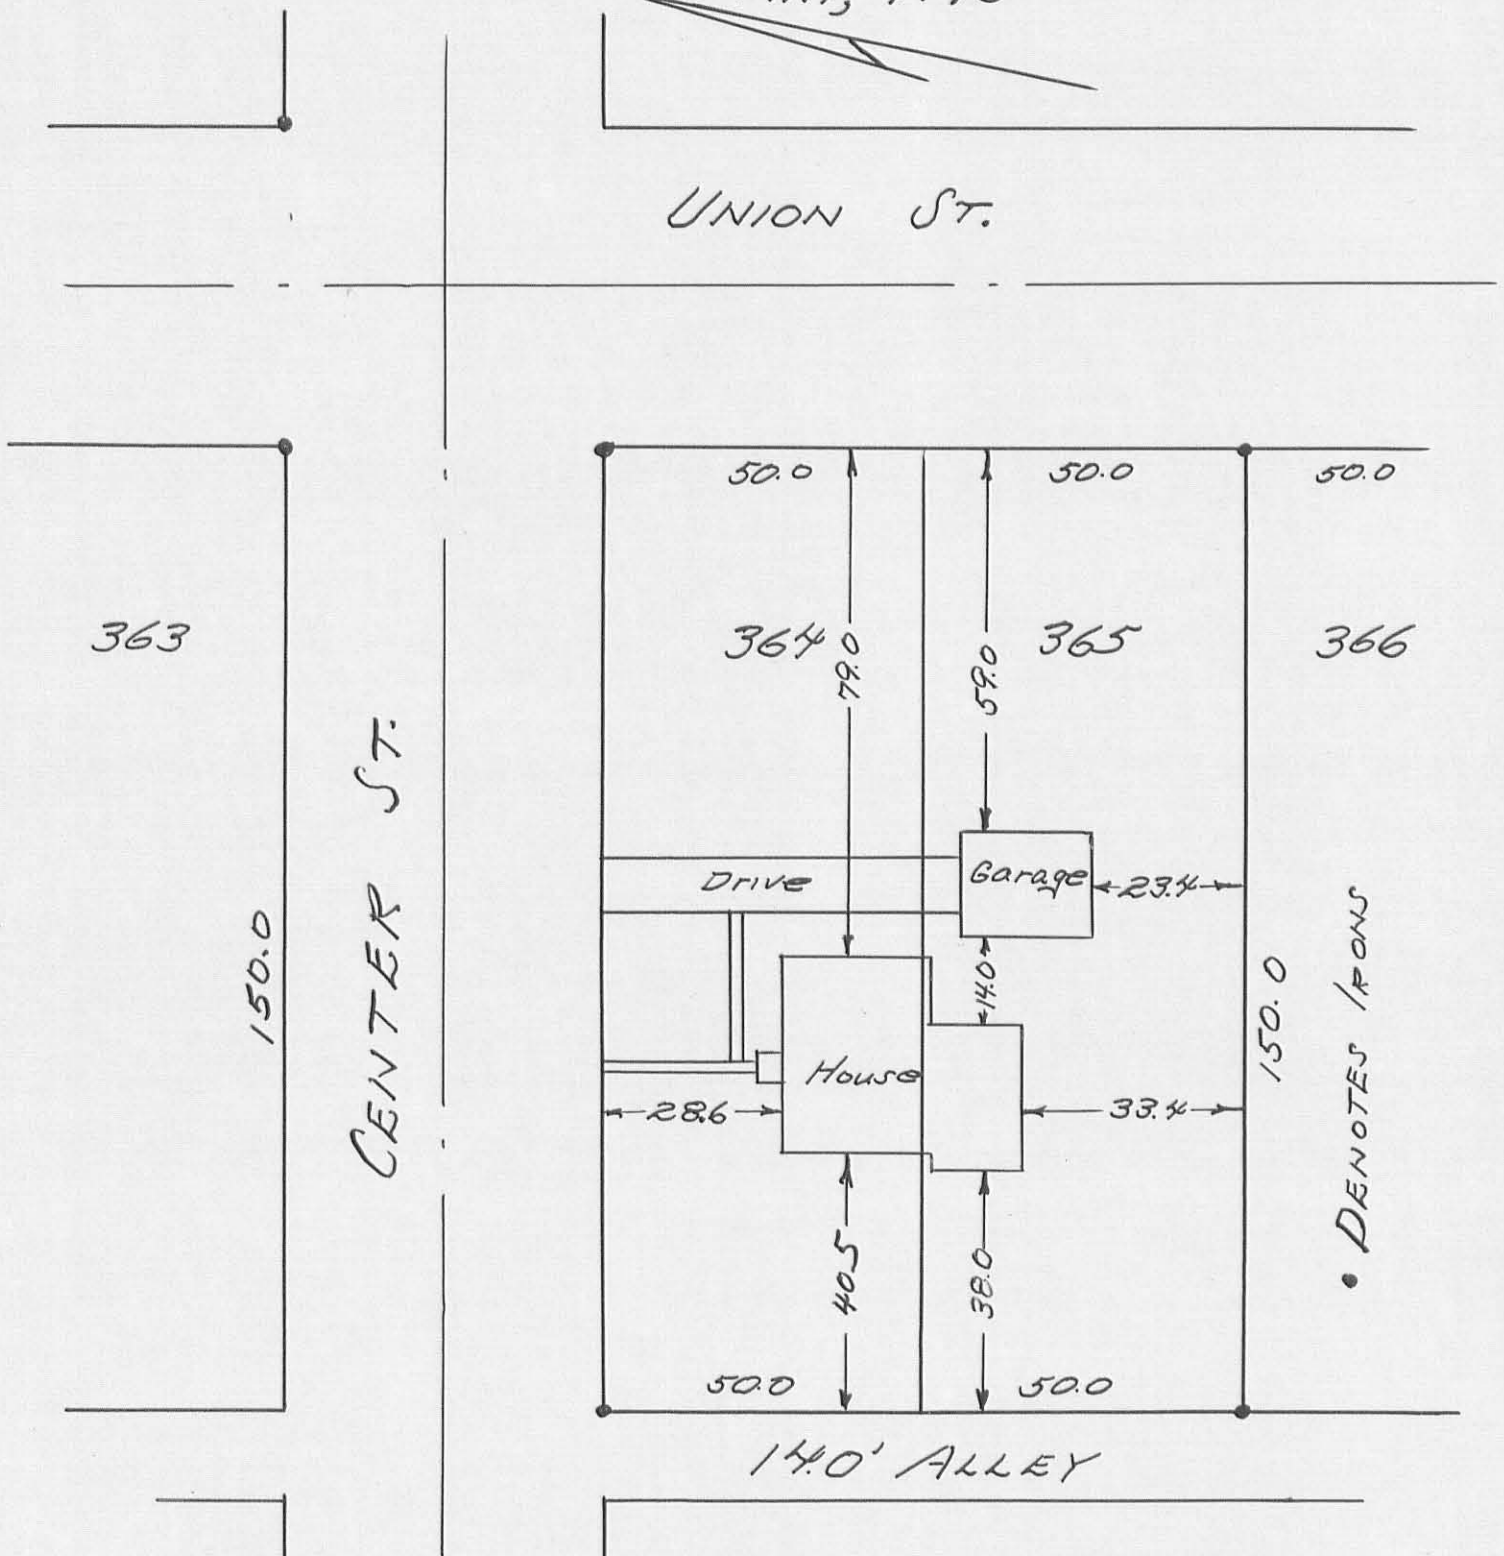

• DENOTES IRONS

INDEXED ON MAP
4659 IP

OWEN K. SHIRK
SURVEYOR 4271

LESLIE H. GEESLIN

REGISTERED SURVEYOR 5248

P. O. BOX 274

RUSHSVLVANIA, OHIO 43347

TELEPHONE: (513) 468-2793

BUTTERMAN SURVEY

September 16, 1994

The following described real estate situated in the State of Ohio, County of Logan, Township of Stokes, being part of Section 34, Town 6 S., Range 8 E., and Lots 349 and 350 of Nichalson's Fairview Addition in the Village of Lakeview as filed in Cabinet A, Slide 14, and more particularly described as follows:

Beginning at a 5/8 inch iron bar set at the intersection of the south line of Center Street and the west line of a 14 foot alley said iron bar also being at the northeast corner of Lot 349 of Nichalsons Fairview Addition to the Village of Lakeview.

Thence with the east line of said 14 foot alley S. 00° 02' 40" E. 100.00 feet to a 5/8 inch iron bar set at the southeast corner of Lot 350 of said Addition.

Thence with the south line of said Lot 350 WEST 75.00 feet to a 5/8 inch iron bar set.

Thence N. 00° 02' 40" W. 100.00 feet to a 5/8 inch iron bar set in the south line of said Center St. and the north line of said Lot 349.

Thence with the south line of said Center St. and the north line of said Lot 349 EAST 75.00 feet to the place of beginning.

Containing 0.172 acre more or less of which 0.086 acre is in the east side of Lot 349 and 0.086 acre is in the east side of Lot 350.

Bearings are based on an assumed bearing (EAST) for the south line of Center Street in this field survey by Leslie H. Geeslin, Reg. Surveyor 5248 on September 16, 1994.



Leslie H. Geeslin

LESLIE H. GEESLIN
REGISTERED SURVEYOR 5248
P. O. BOX 274
RUSHSVLVANIA, OHIO 43347
TELEPHONE: (513) 468-2793

BUTTERMAN SURVEY

September 16, 1994

The following described real estate situated in the State of Ohio, County of Logan, Township of Stokes, being part of Section 34, Town 6 S., Range 8 E., and Lots 349 and 350 of Nichalson's Fairview Addition in the Village of Lakeview as filed in Cabinet A, Slide 14, and more particularly described as follows:

Beginning at a 5/8 inch iron bar set at the intersection of the south line of Center Street and the east line of Oak Street said iron bar also being at the northwest corner of Lot 349 of Nichalsons Fairview Addition to the Village of Lakeview.

Thence with the south line of said Center St. and the north line of said Lot 349 EAST 75.00 feet to a 5/8 inch iron bar set.

Thence S. 00° 02' 40" E. 100.00 feet to a 5/8 inch iron bar set in the south line of Lot 350 of said Addition.

Thence with the south line of said Lot 350 WEST 75.00 feet to a 5/8 inch iron bar set in the east line of said Oak Street.

Thence with the east line of said Oak St. N. 00° 02' 40" W. 100.00 feet to the place of beginning.

Containing 0.172 acre more or less of which 0.086 acre is in the west side of Lot 349 and 0.086 acre is in the west side of Lot 350.


Bearings are based on an assumed bearing (EAST) for the south line of Center Street in this field survey by Leslie H. Geeslin, Reg. Surveyor 5248 on September 16, 1994.



Leslie H. Geeslin

RECD 10-5-94 GMM OK

CENTER STREET (50')

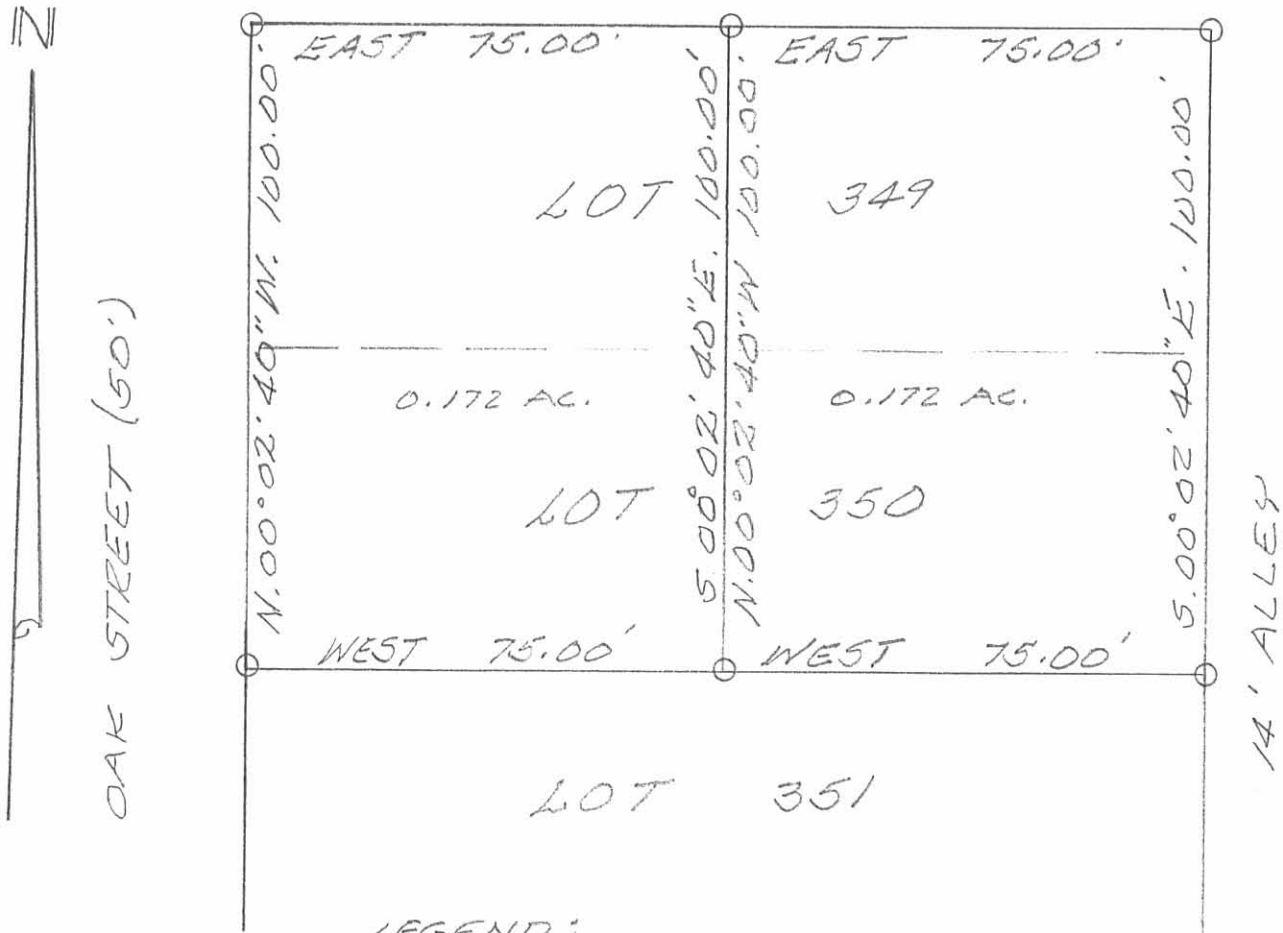

LEGEND:
O = 5/8" IRON BAR SET

SURVEY OF LOTS 349 & 350 IN NICHALSONS FAIRVIEW ADD. IN THE VILLAGE OF LAKEVIEW, SEC. 34, T.6 S., R.8 E., STOKES TOWNSHIP, LOGAN COUNTY, OHIO.

SEPTEMBER 15, 1994



INDEXED ON MAP
4659 2P

Leslie H. Geeslin
LESLIE H. GEESLIN
RUSHSVYANIA, OHIO
PH 513-468-2793